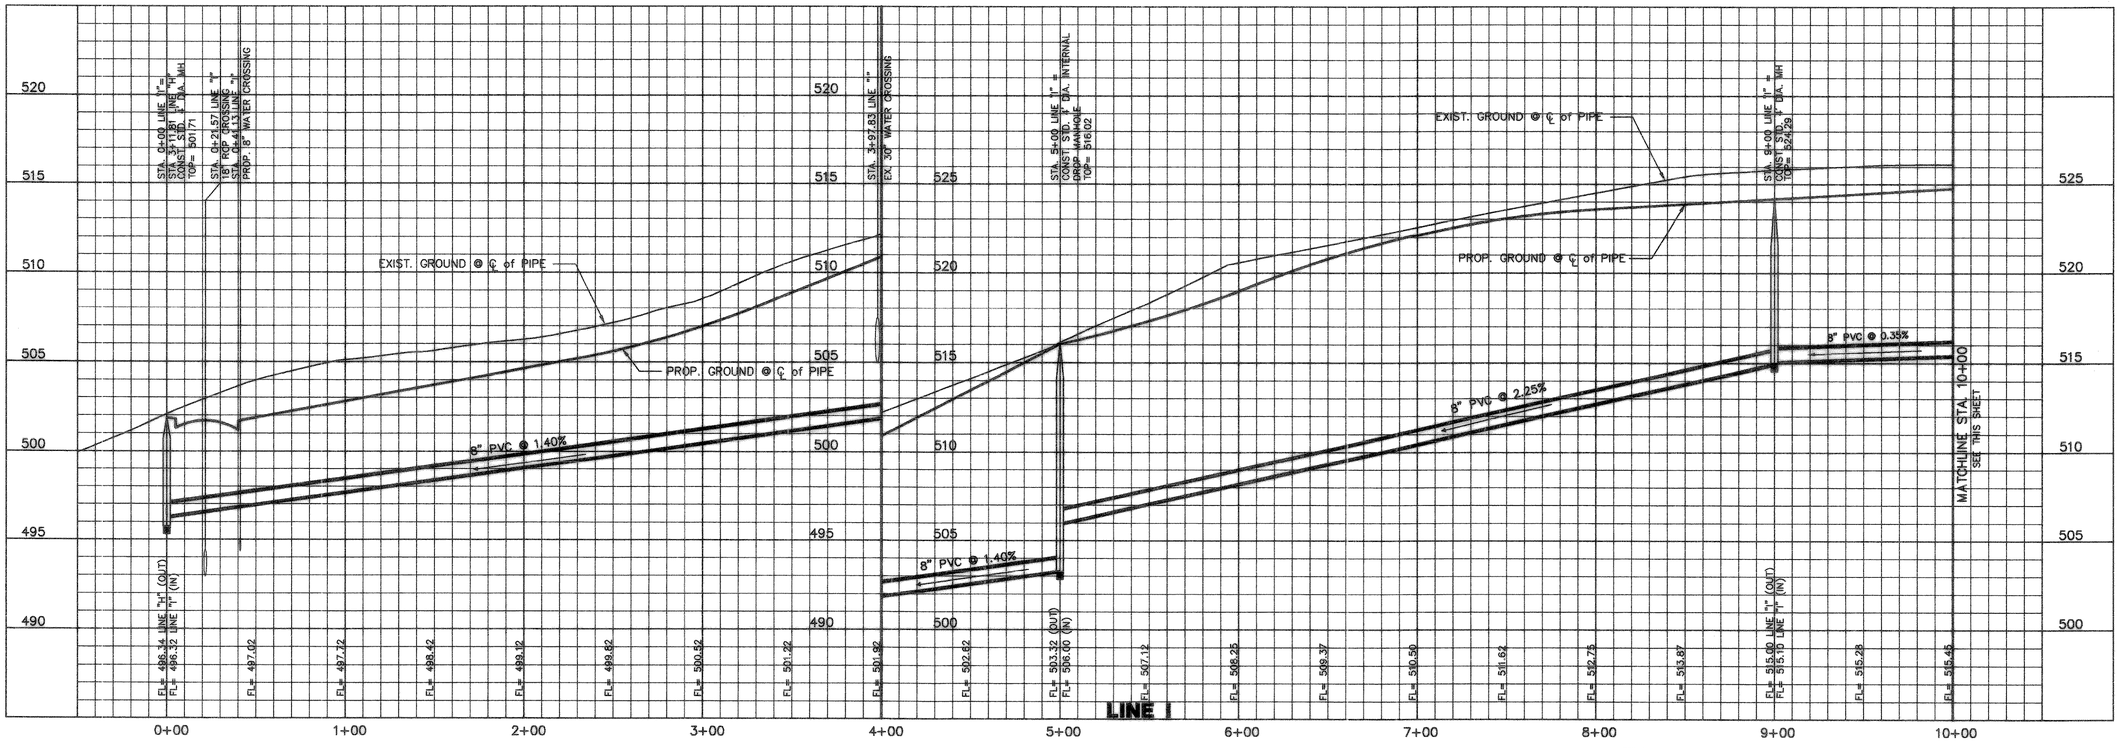

THESE CONSTRUCTION PLANS WERE PREPARED UNDER THE RESPONSIBLE SUPERVISION OF MD. NAIM UDDIN KHAN, REGISTERED PROFESSIONAL ENGINEER NO. 87776.
4/12/04

THE SEAL APPEARING ON THIS DOCUMENT WAS AUTHORIZED BY MD. NAIM UDDIN KHAN, # 87776

BENCHMARK: PK NAIL IN ℄ OF CARUTH LANE & ALLEY INTERSECTION 150'± EAST OF MORNINGSTAR DRIVE. ELEV. 491.68

BENCHMARK: "X" CHISELED IN ℄ OF ALLEY EAST OF MORNINGSTAR DRIVE WITHIN 3RD LOT NORTH OF MIDNIGHT PASS. ELEV. 513.26

NO.	DATE	REVISION	APPROV.

Winkelmann & Associates, Inc.
CONSULTING CIVIL ENGINEERS ■ SURVEYORS
6750 Hillcrest Plaza Drive, Suite 100
Dallas, Texas 75230
(972) 490-7200
(972) 490-7201 FAX
www.winkelmann.com

STATE OF TEXAS — MD. NAIM UDDIN KHAN — 87776 — REGISTERED PROFESSIONAL ENGINEER

M.B. JONES SURVEY, ABSTRACT NO. 122
CITY OF ROCKWALL
ROCKWALL COUNTY, TEXAS

LUMBERMEN'S INVESTMENT CORPORATION
5495 BELTLINE ROAD #225
DALLAS, TEXAS 75240

SANITARY SEWER PROFILE
LINE I - STA. 0+00 STA. 11+07.93
LINE H - STA. 0+00 STA. 3+83.52

Scale : H: 1"=40' V: 1"=4'	Date : 9/10/03
Designed By :	RB
Drawn By :	MS
Checked By :	NK
File :	14654ANSSP.DWG
Project No. :	14654.01

SHEET 42 OF 57

G:\14654\New Phase 6\14654ANSSP.dwg Fri Apr 09 13:41:39 2004 rd1