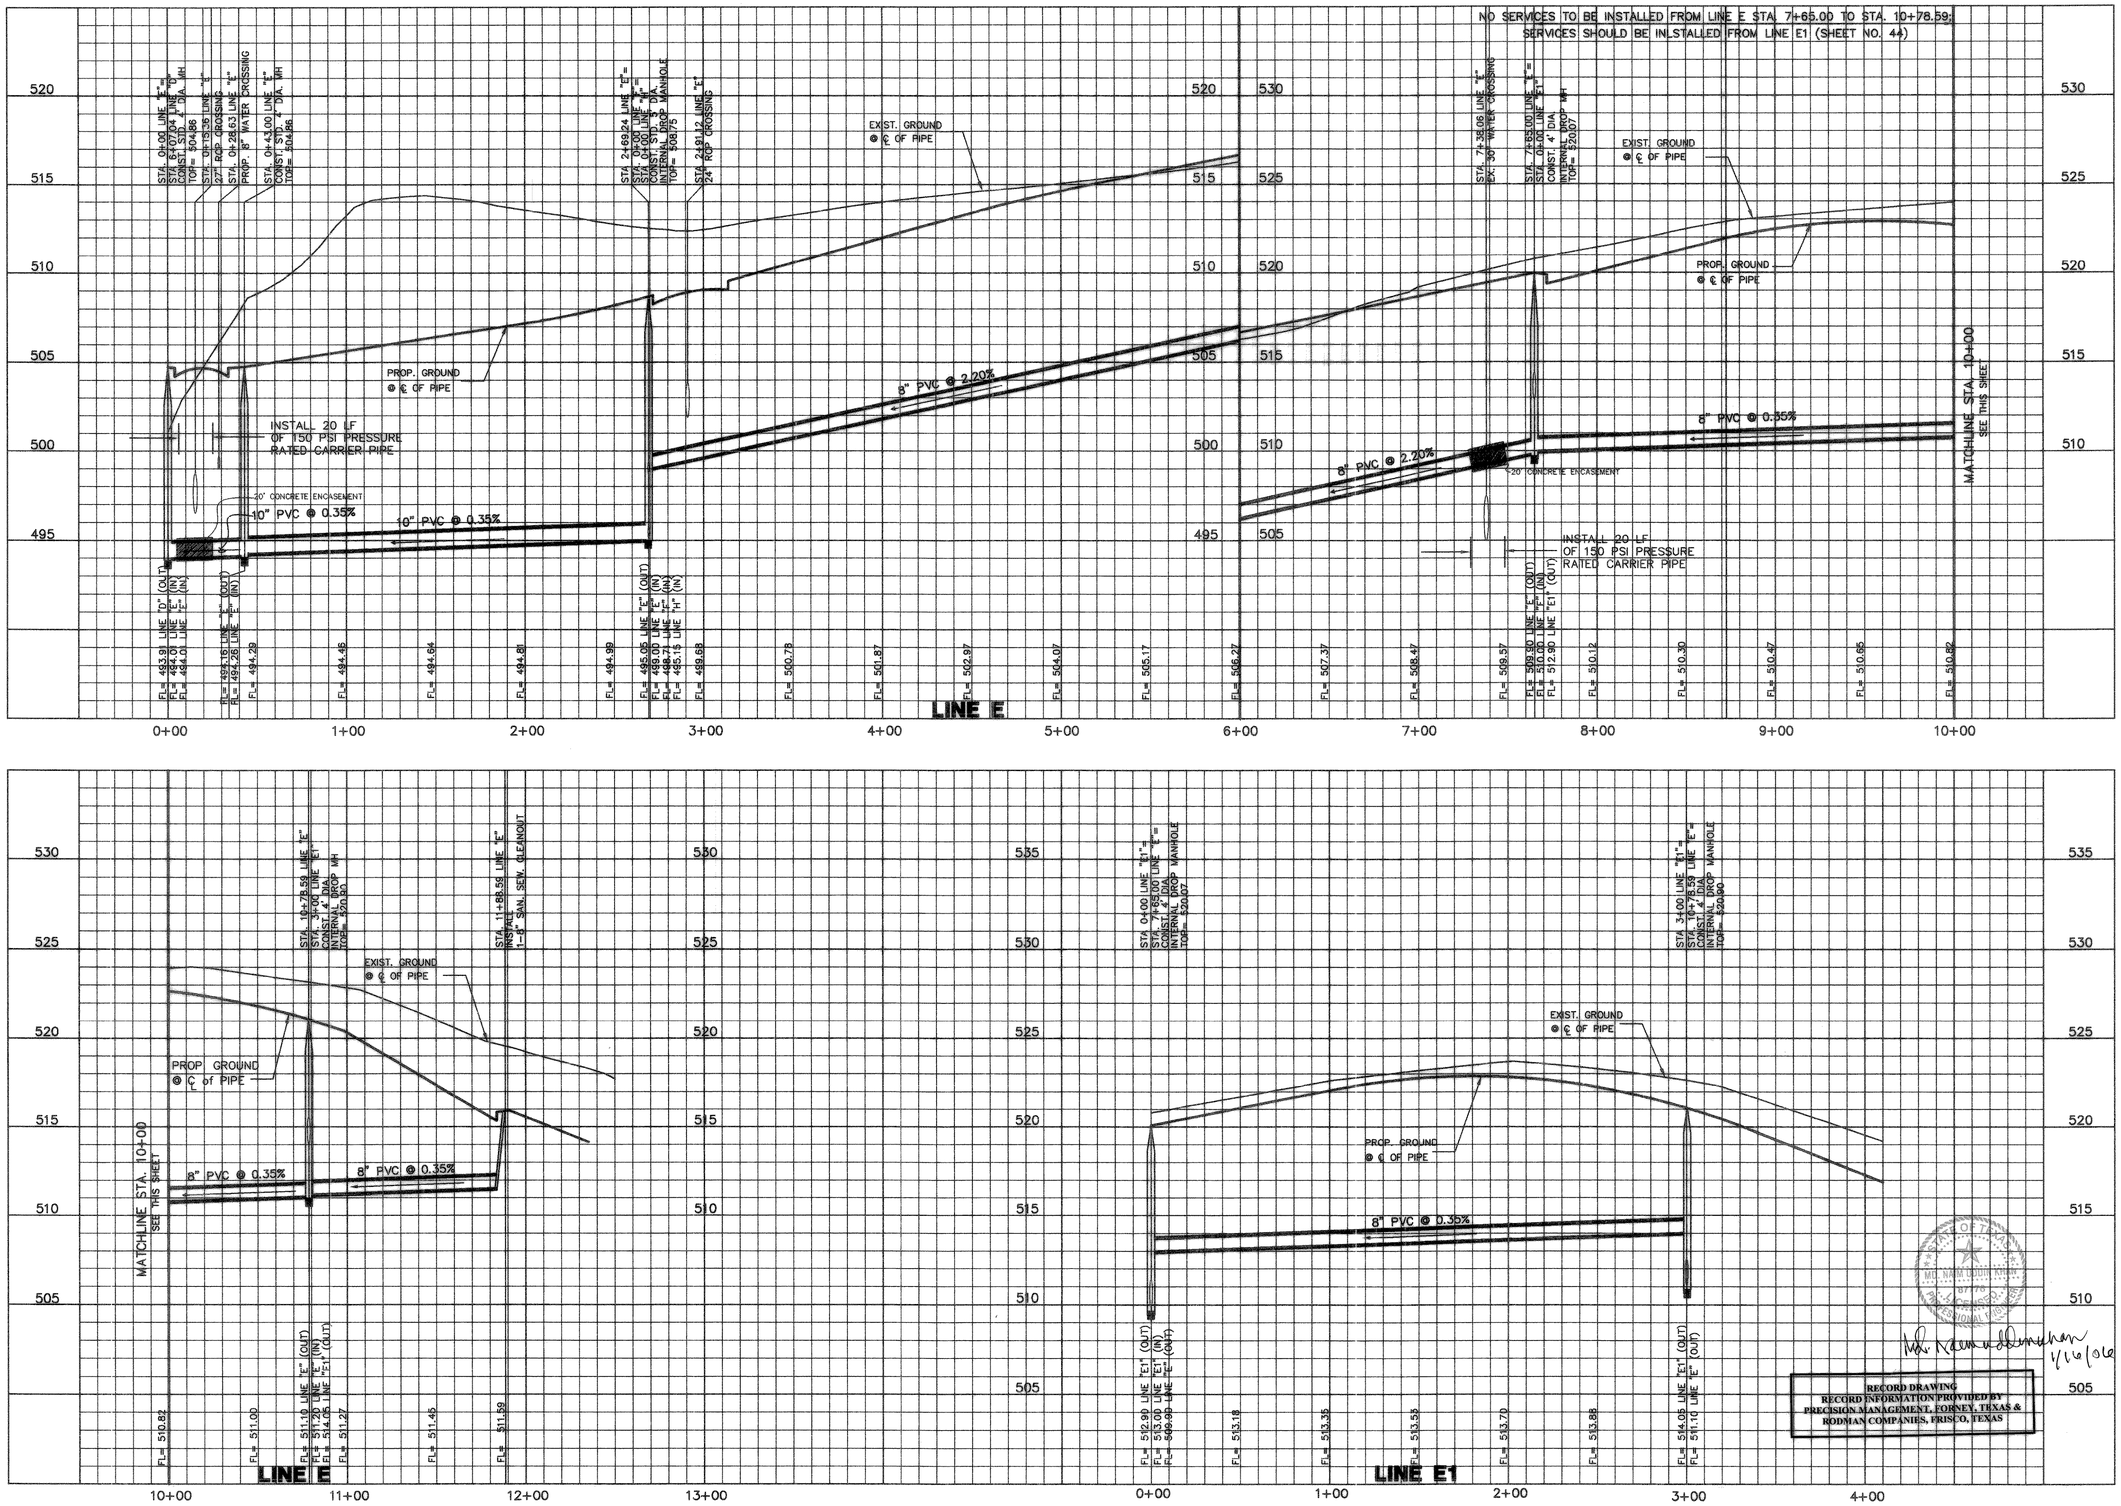

THESE CONSTRUCTION PLANS WERE PREPARED UNDER THE RESPONSIBLE SUPERVISION OF MD. NAIM UDDIN KHAN, REGISTERED PROFESSIONAL ENGINEER NO. 87776

M.B. JONES SURVEY, ABSTRACT NO. 122
CITY OF ROCKWALL
ROCKWALL COUNTY, TEXAS

LUMBERMEN'S INVESTMENT CORPORATION
5495 BELTLINE ROAD #225
DALLAS, TEXAS 75240

THE SEAL APPEARING ON THIS DOCUMENT WAS AUTHORIZED BY MD. NAIM UDDIN KHAN, # 87776

SANITARY SEWER PROFILES
LINE E - STA. 0+00 STA. 11+88.59
LINE E1 - STA. 0+00 STA. 3+00

BENCHMARK: PK NAIL IN ℄ OF CARUTH LANE & ALLEY INTER-SECTION 150'± EAST OF MORNINGSTAR DRIVE. ELEV. 491.68

BENCHMARK: "X" CHISELED IN ℄ OF ALLEY EAST OF MORNINGSTAR DRIVE WITHIN 3RD LOT NORTH OF MIDNIGHT PASS. ELEV. 513.26

Scale : H: 1"=40' V: 1"=4'
Designed By : RB
Drawn By : MS
Checked By : NK
File : 146546ANSSP.DWG
Project No. : 14654.01
Date : 12/2/03

RECORD DRAWING
RECORD INFORMATION PROVIDED BY PRECISION MANAGEMENT, FORNEY, TEXAS & RODMAN COMPANIES, FRISCO, TEXAS

1/16/06

SHEET 44 OF 57

Winkelmann & Associates, Inc.
CONSULTING CIVIL ENGINEERS ■ SURVEYORS
6750 Hillcrest Plaza Drive, Suite 100
Dallas, Texas 75230
www.winkelmann.com
(972) 490-7090
(972) 490-7099 FAX

NO. | DATE | REVISION | APPROV.

G:\146\54\New Phase 6\146546ANSSP.dwg Fri Apr 09 13:42:29 2004 rdl