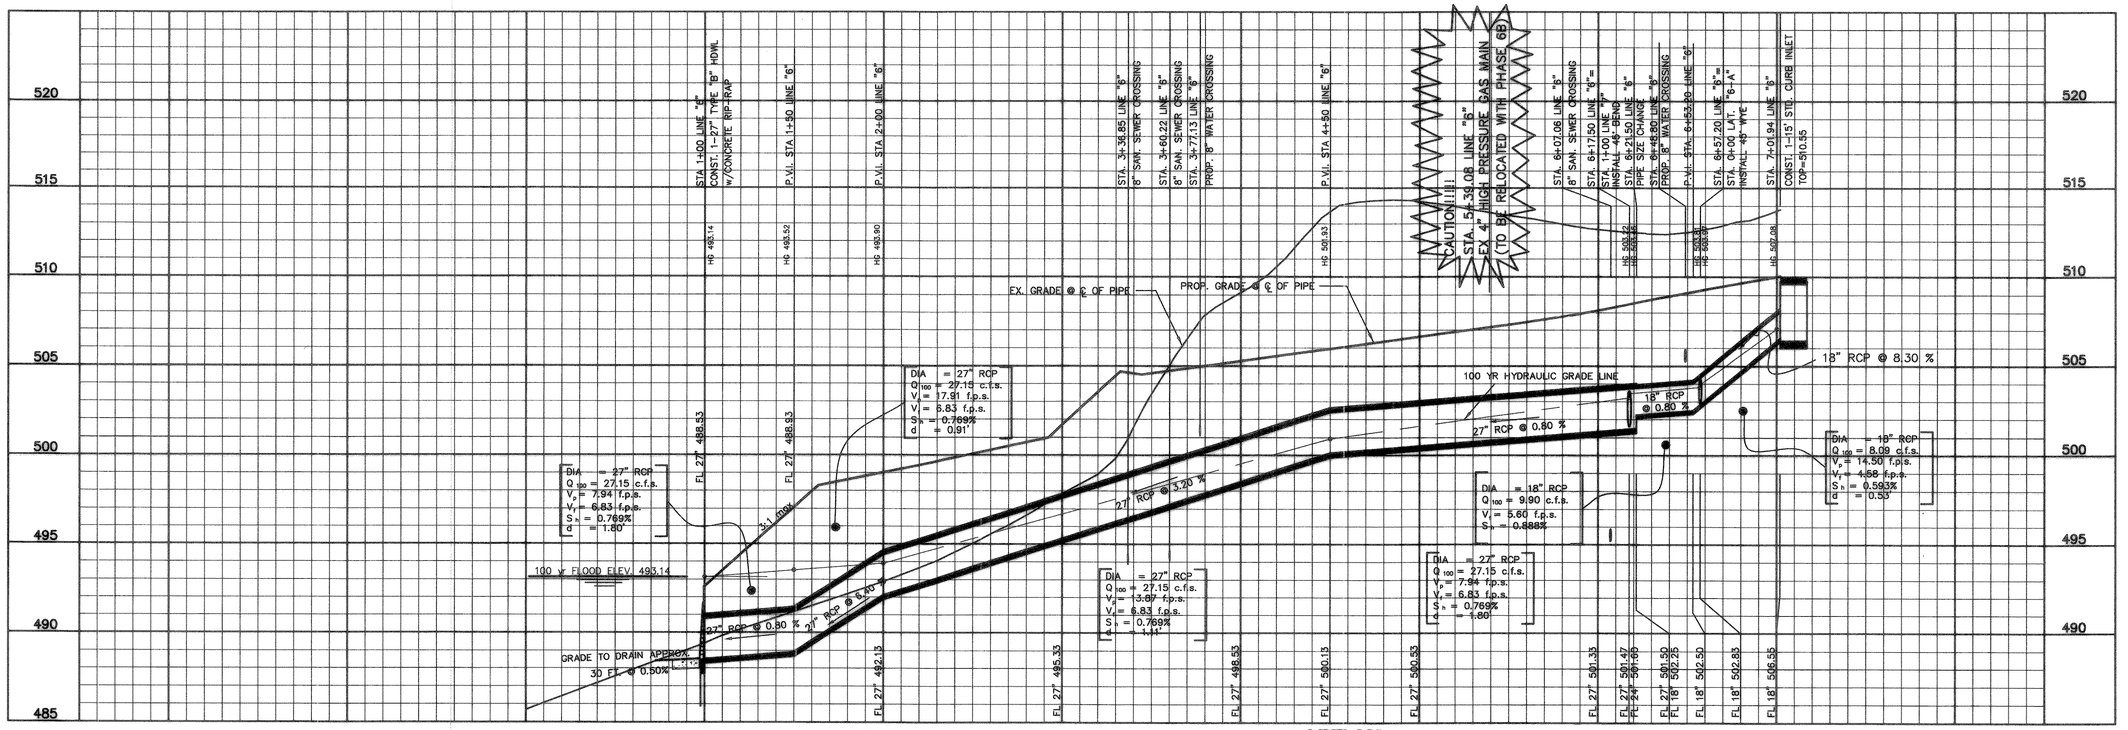

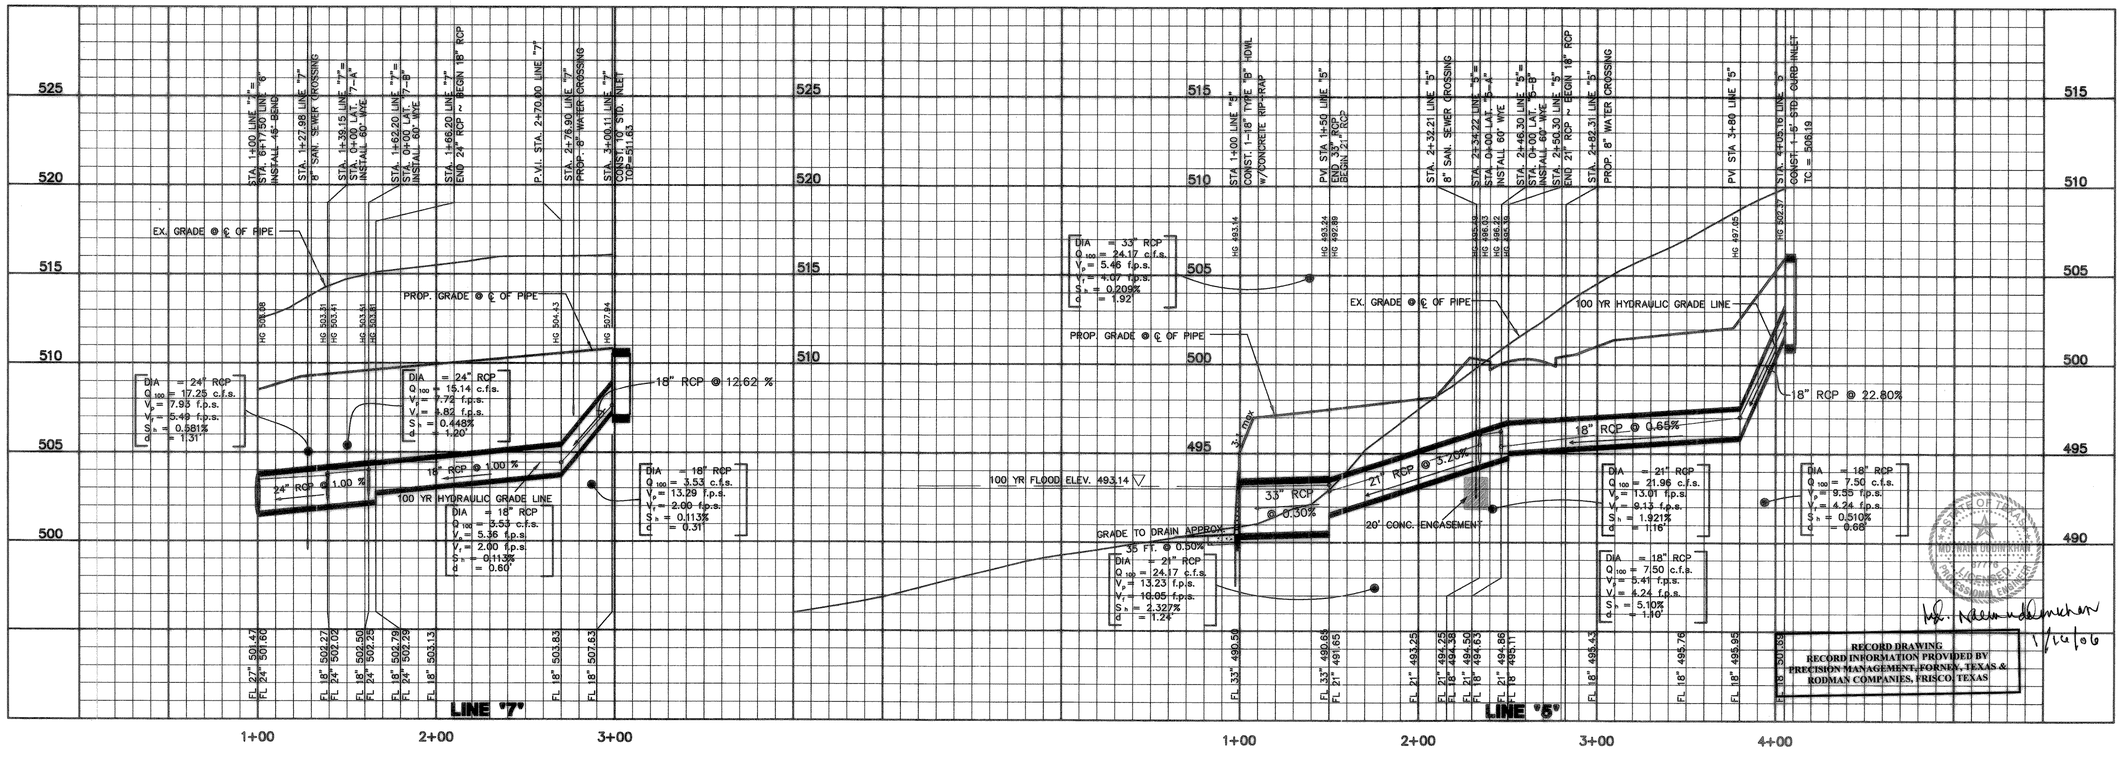

THESE CONSTRUCTION PLANS WERE PREPARED UNDER THE RESPONSIBLE SUPERVISION OF MD. NAIM UDDIN KHAN, REGISTERED PROFESSIONAL ENGINEER NO. 87776

THE SEAL APPEARING ON THIS DOCUMENT WAS AUTHORIZED BY MD. NAIM UDDIN KHAN. # 87776

NO.	DATE	REVISION	APPROV.

Winkelmann & Associates, Inc.
CONSULTING CIVIL ENGINEERS ■ SURVEYORS
8750 HILLCREST PLAZA BLVD, SUITE 100
DALLAS, TEXAS 75230
(972) 490-7999 FAX

STATE OF TEXAS — MD. NAIM UDDIN KHAN — 87776 — REGISTERED PROFESSIONAL ENGINEER

M.B. JONES SURVEY, ABSTRACT NO. 122
CITY OF ROCKWALL
ROCKWALL COUNTY, TEXAS

LUMBERMEN'S INVESTMENT CORPORATION
5495 BELTLINE ROAD #225
DALLAS, TEXAS 75240

STORM SEWER PROFILES
(PHASE 6)
LINE "5", LINE "6" & LINE "7"

BENCHMARK:
PK NAIL IN ℄ OF CARUTH LANE & ALLEY INTERSECTION 175'± EAST OF MORNINGSTAR DRIVE.
ELEV. 491.88

BENCHMARK:
PK NAIL IN ℄ OF ALLEY EAST OF MORNINGSTAR DRIVE CHISELED IN ℄ OF ALLEY 3RD LOT NORTH OF MIDNIGHT PASS.
ELEV. 513.28

Scale : H: 1"=40' V: 1"=4'
Date : 9/10/03
Designed By : NK
Drawn By : MS
Checked By : NK
File :14654Nstp.dwg
View :
Project No. : 14654.01

SHEET 29 OF 57