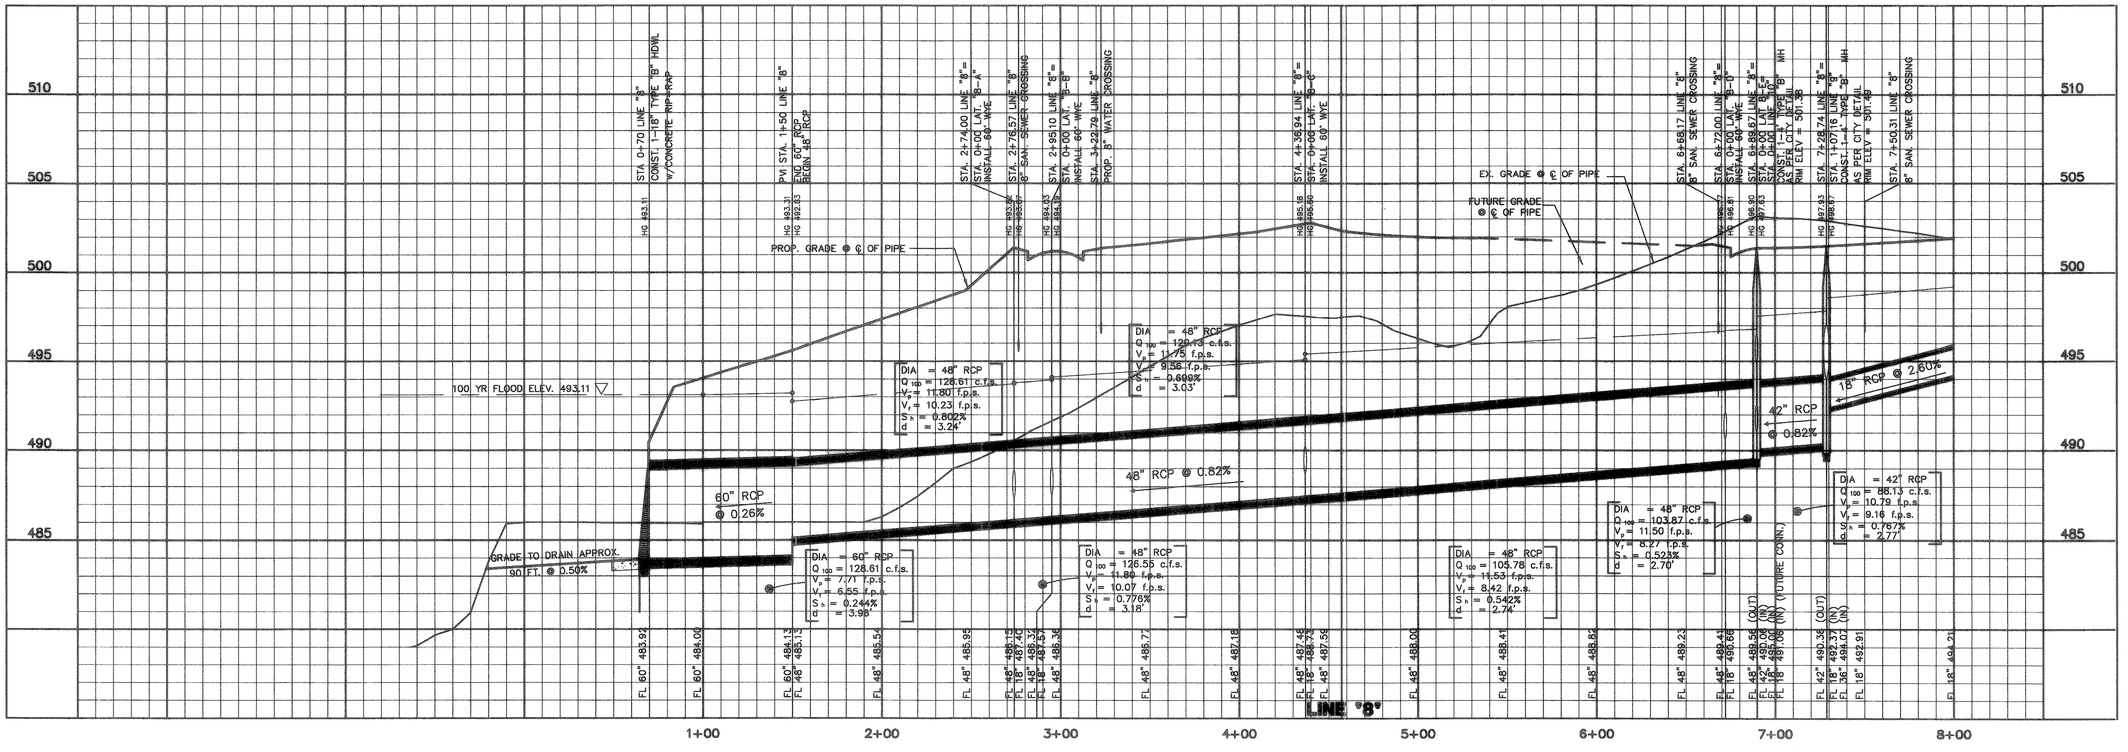

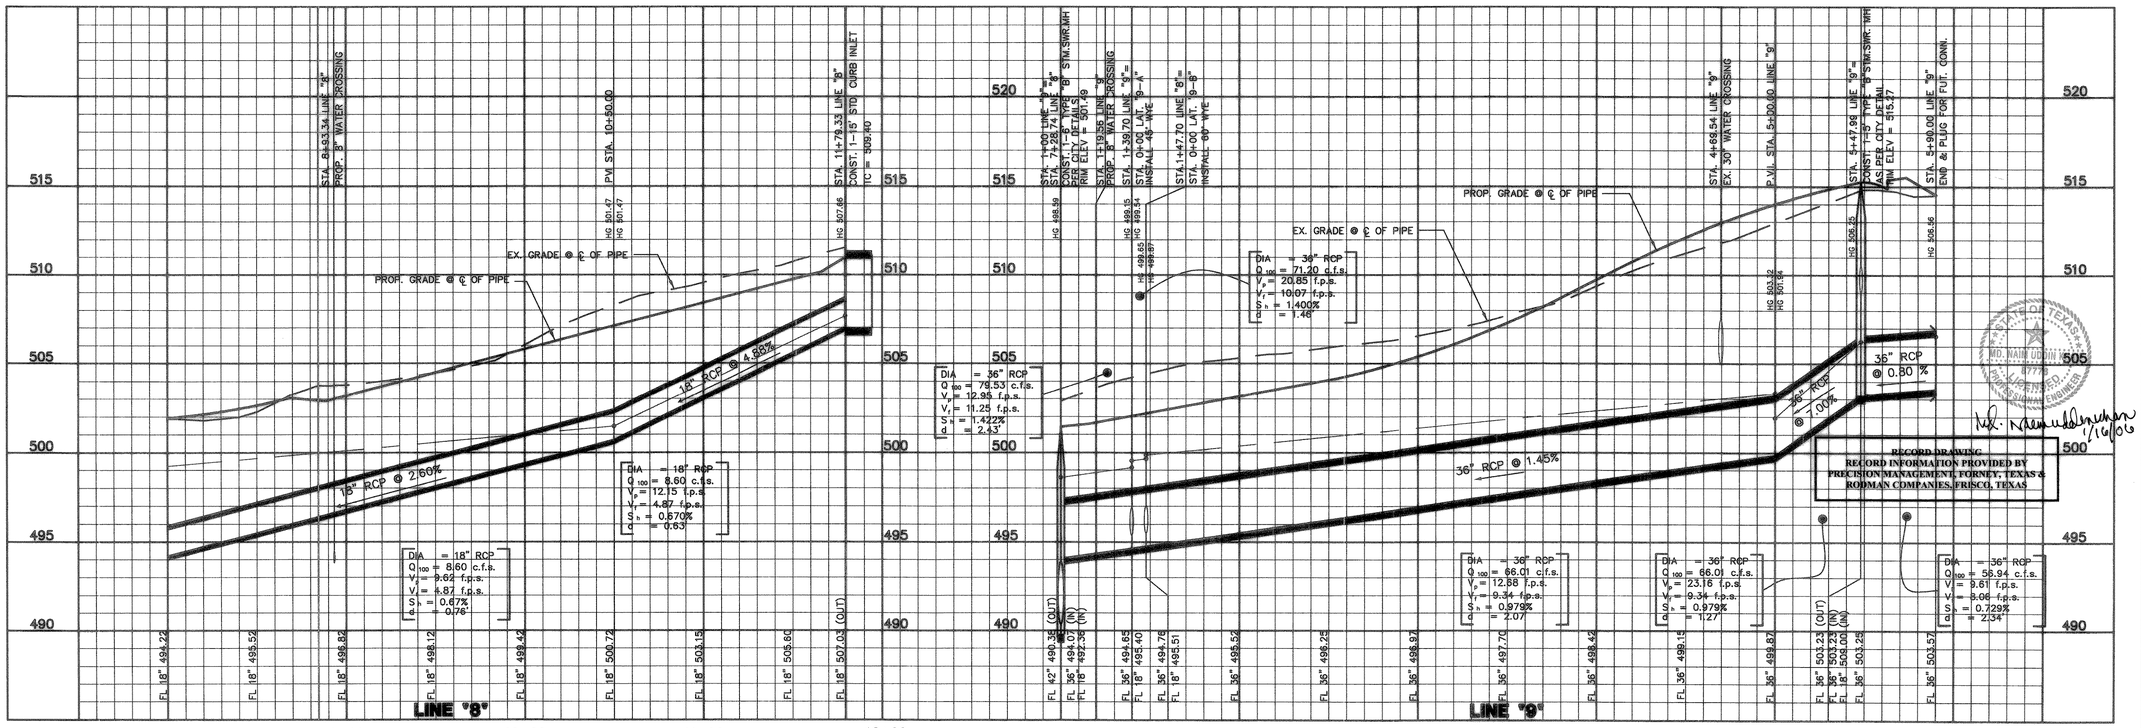

NO.	DATE	REVISION	APPROV.

Winkelmann & Associates, Inc.
CONSULTING CIVIL ENGINEERS & SURVEYORS
8750 HILLCREST PLAZA BLVD., SUITE 100 (972) 490-7999
DALLAS, TEXAS 75230 (972) 490-7995 FAX

STATE OF TEXAS — NAIM UDDIN KHAN — 87778 — REGISTERED PROFESSIONAL ENGINEER

THESE CONSTRUCTION PLANS WERE PREPARED UNDER THE RESPONSIBLE SUPERVISION OF MD. NAIM UDDIN KHAN, REGISTERED PROFESSIONAL ENGINEER NO. 87778
11/14/05

M.B. JONES SURVEY, ABSTRACT NO. 122
CITY OF ROCKWALL
ROCKWALL COUNTY, TEXAS

LUMBERMEN'S INVESTMENT CORPORATION
5495 BELTLINE ROAD #225
DALLAS, TEXAS 75240

THE SEAL APPEARING ON THIS DOCUMENT WAS AUTHORIZED BY MD. NAIM UDDIN KHAN, # 87776

BENCHMARK:
"X" CHISELED IN ℄ OF ALLEY EAST OF MORNINGSTAR DRIVE, SOUTH OF 3RD LOT NORTH OF MIDNIGHT PASS.
ELEV. 513.26

BENCHMARK:
PK NAIL IN ℄ OF CARUTH LANE & ALLEY INTERSECTION 150'± EAST OF MORNINGSTAR DRIVE.
ELEV. 491.88

STORM SEWER PROFILES
(PHASE 6)
LINE "8" & LINE "9"

Scale : H: 1"=40' V: 1"=4'
Designed By : NK
Drawn By : MS
Checked By : NK
File : 14654Nstp.dwg
Project No. : 14654.01
Date : 9/10/03
View :

SHEET 30 OF 57