REV. 8-24-73
10-26-73

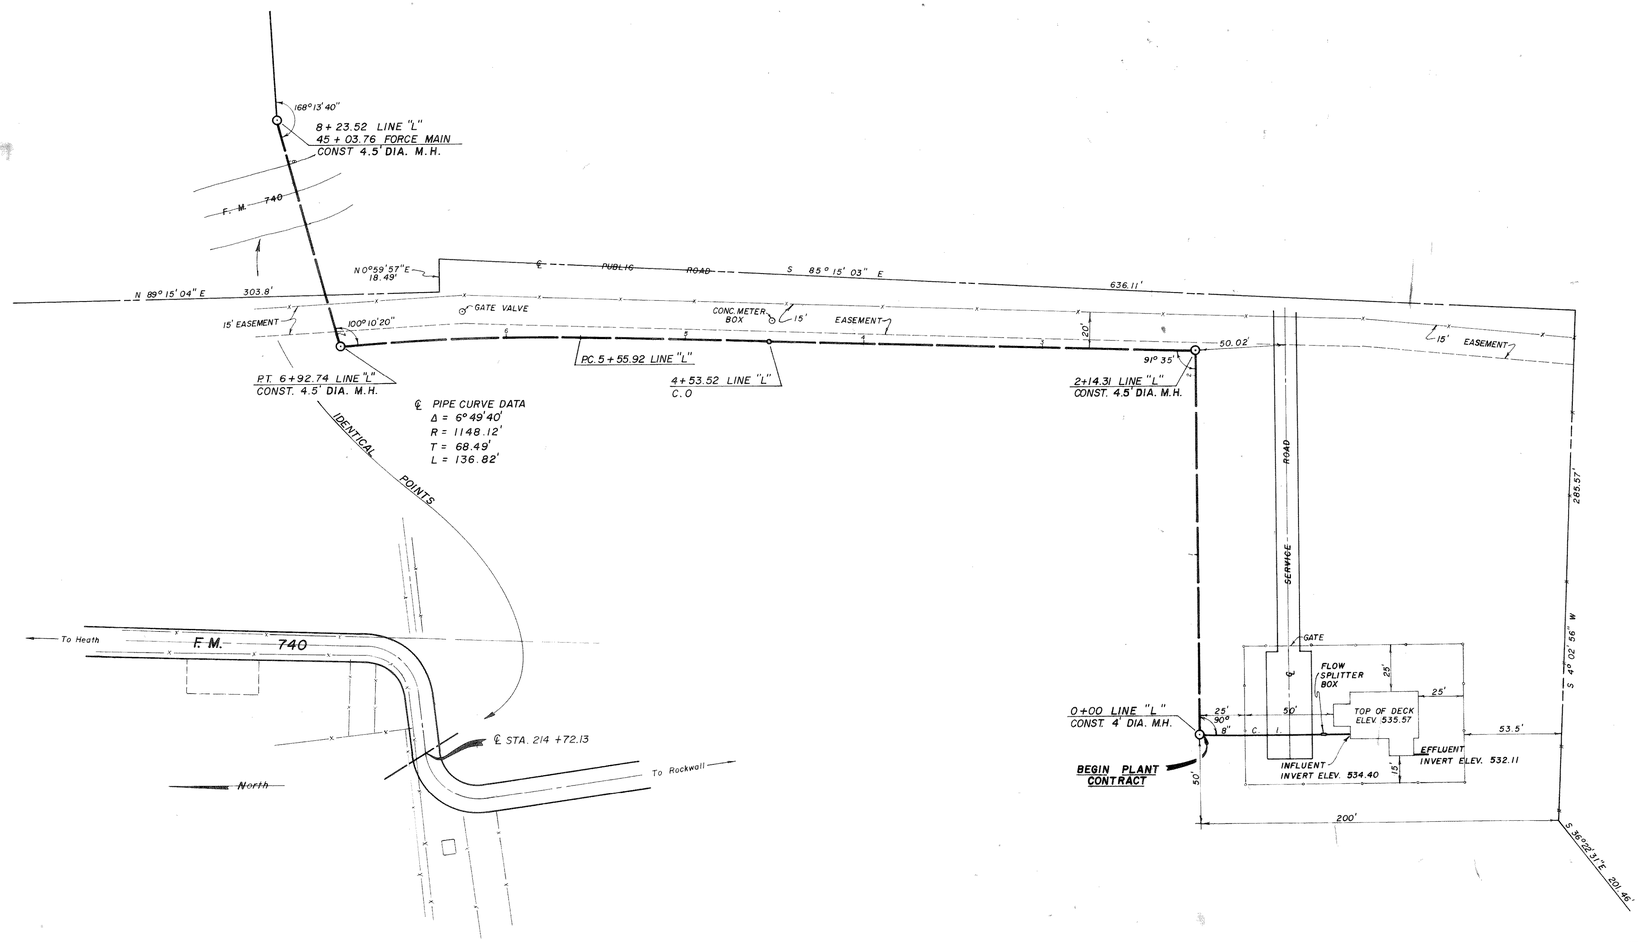

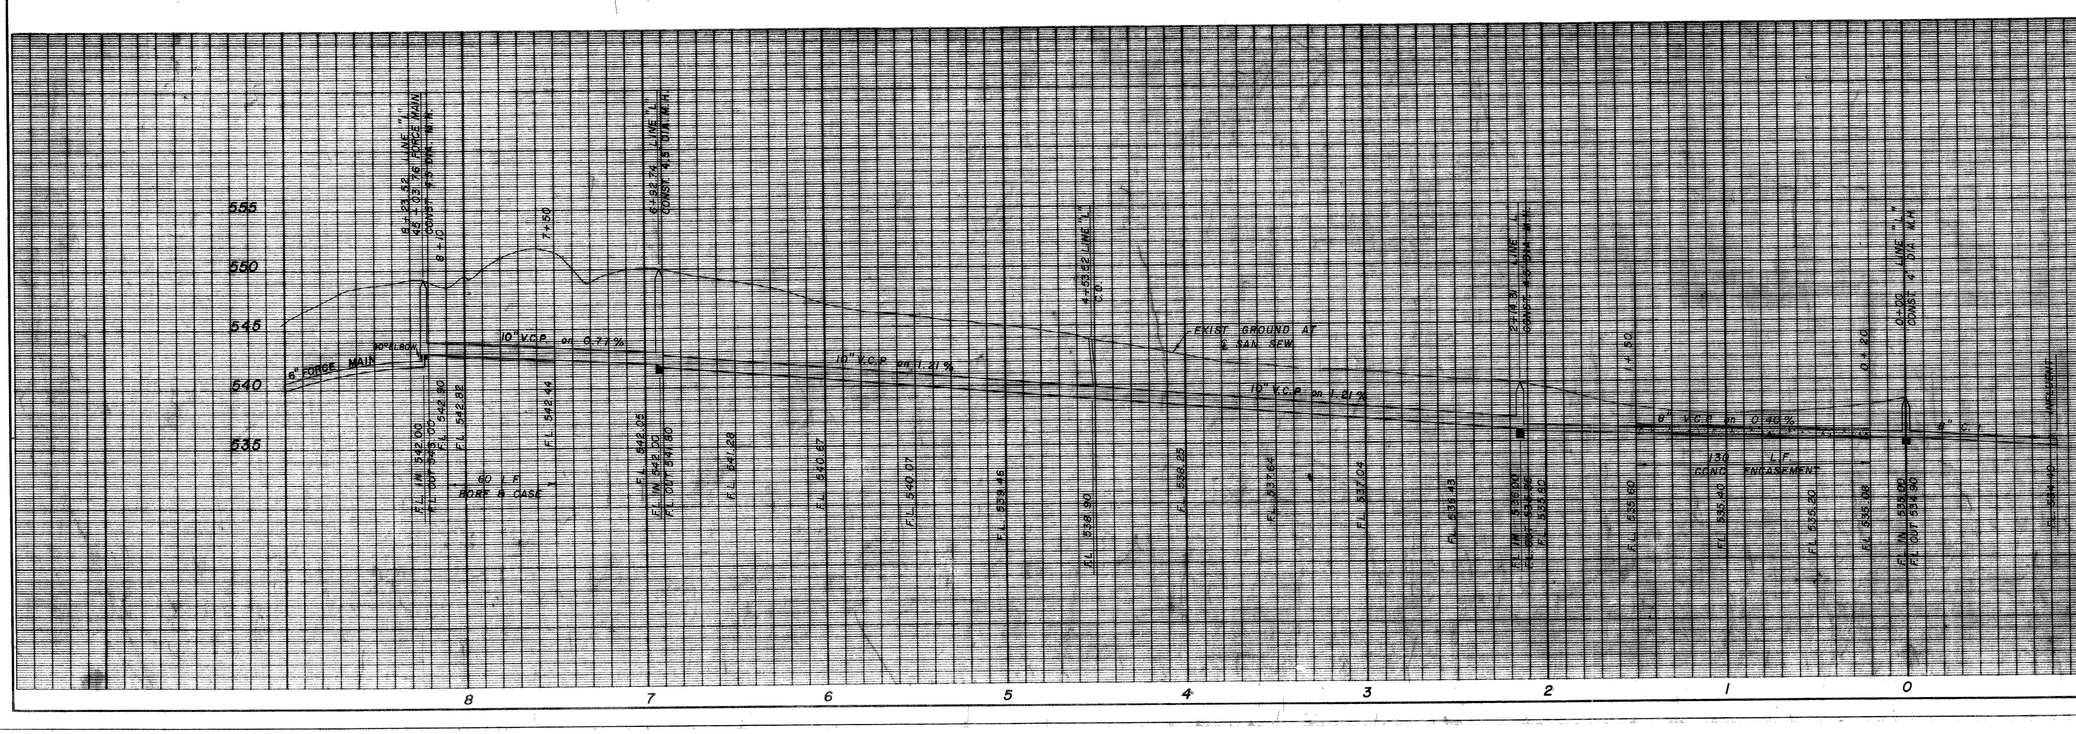

AS BUILT

12

CHANDLERS LANDING						
PROPOSED SANITARY SEWER						
LINE "L" & TREATMENT PLANT						
ROCKWALL, TEXAS						
DESIGN	DRAWN	DATE	SCALE	NOTES	FILE	NO.
JTS		6/12/73	1"=40' H. 1"=6' V.			72182

PHASE 1, 2 & 3