
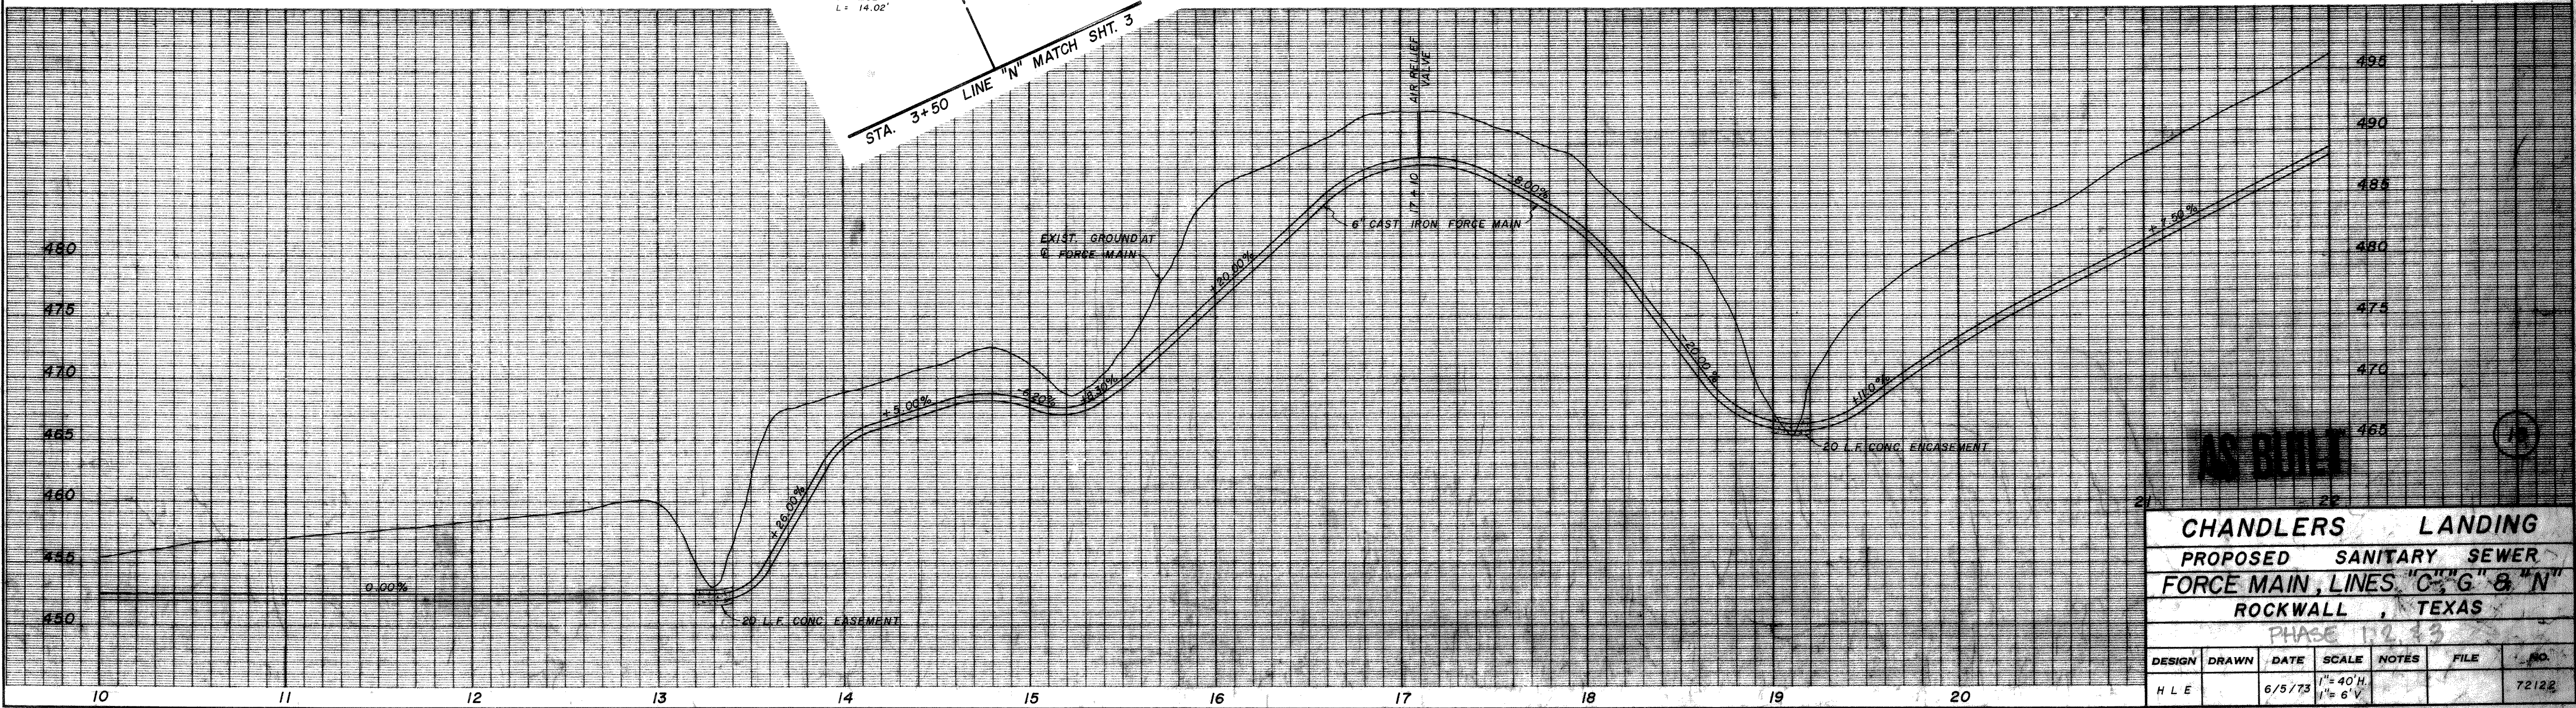


| CURVE DATA TABLE |          |        |     |          |        |     |         |        |
|------------------|----------|--------|-----|----------|--------|-----|---------|--------|
| NO.              | ANGLE    | RADIUS | NO. | ANGLE    | RADIUS | NO. | ANGLE   | RADIUS |
| 10               | 104° 05' | 100.0' | 14  | 52° 08'  | 70.0'  | 18  | 68° 55' | 40.0'  |
| 11               | 38° 05'  | 150.0' | 15  | 102° 50' | 30.0'  |     |         |        |
| 12               | 81° 46'  | 30.0'  | 16  | 143° 58' | 55.0'  |     |         |        |
| 13               | 67° 42'  | 30.0'  | 17  | 78° 09'  | 50.0'  |     |         |        |

NOTE:  
USE 5° BEVEL JOINTS AS REQUIRED  
FOR LINE 'C'.

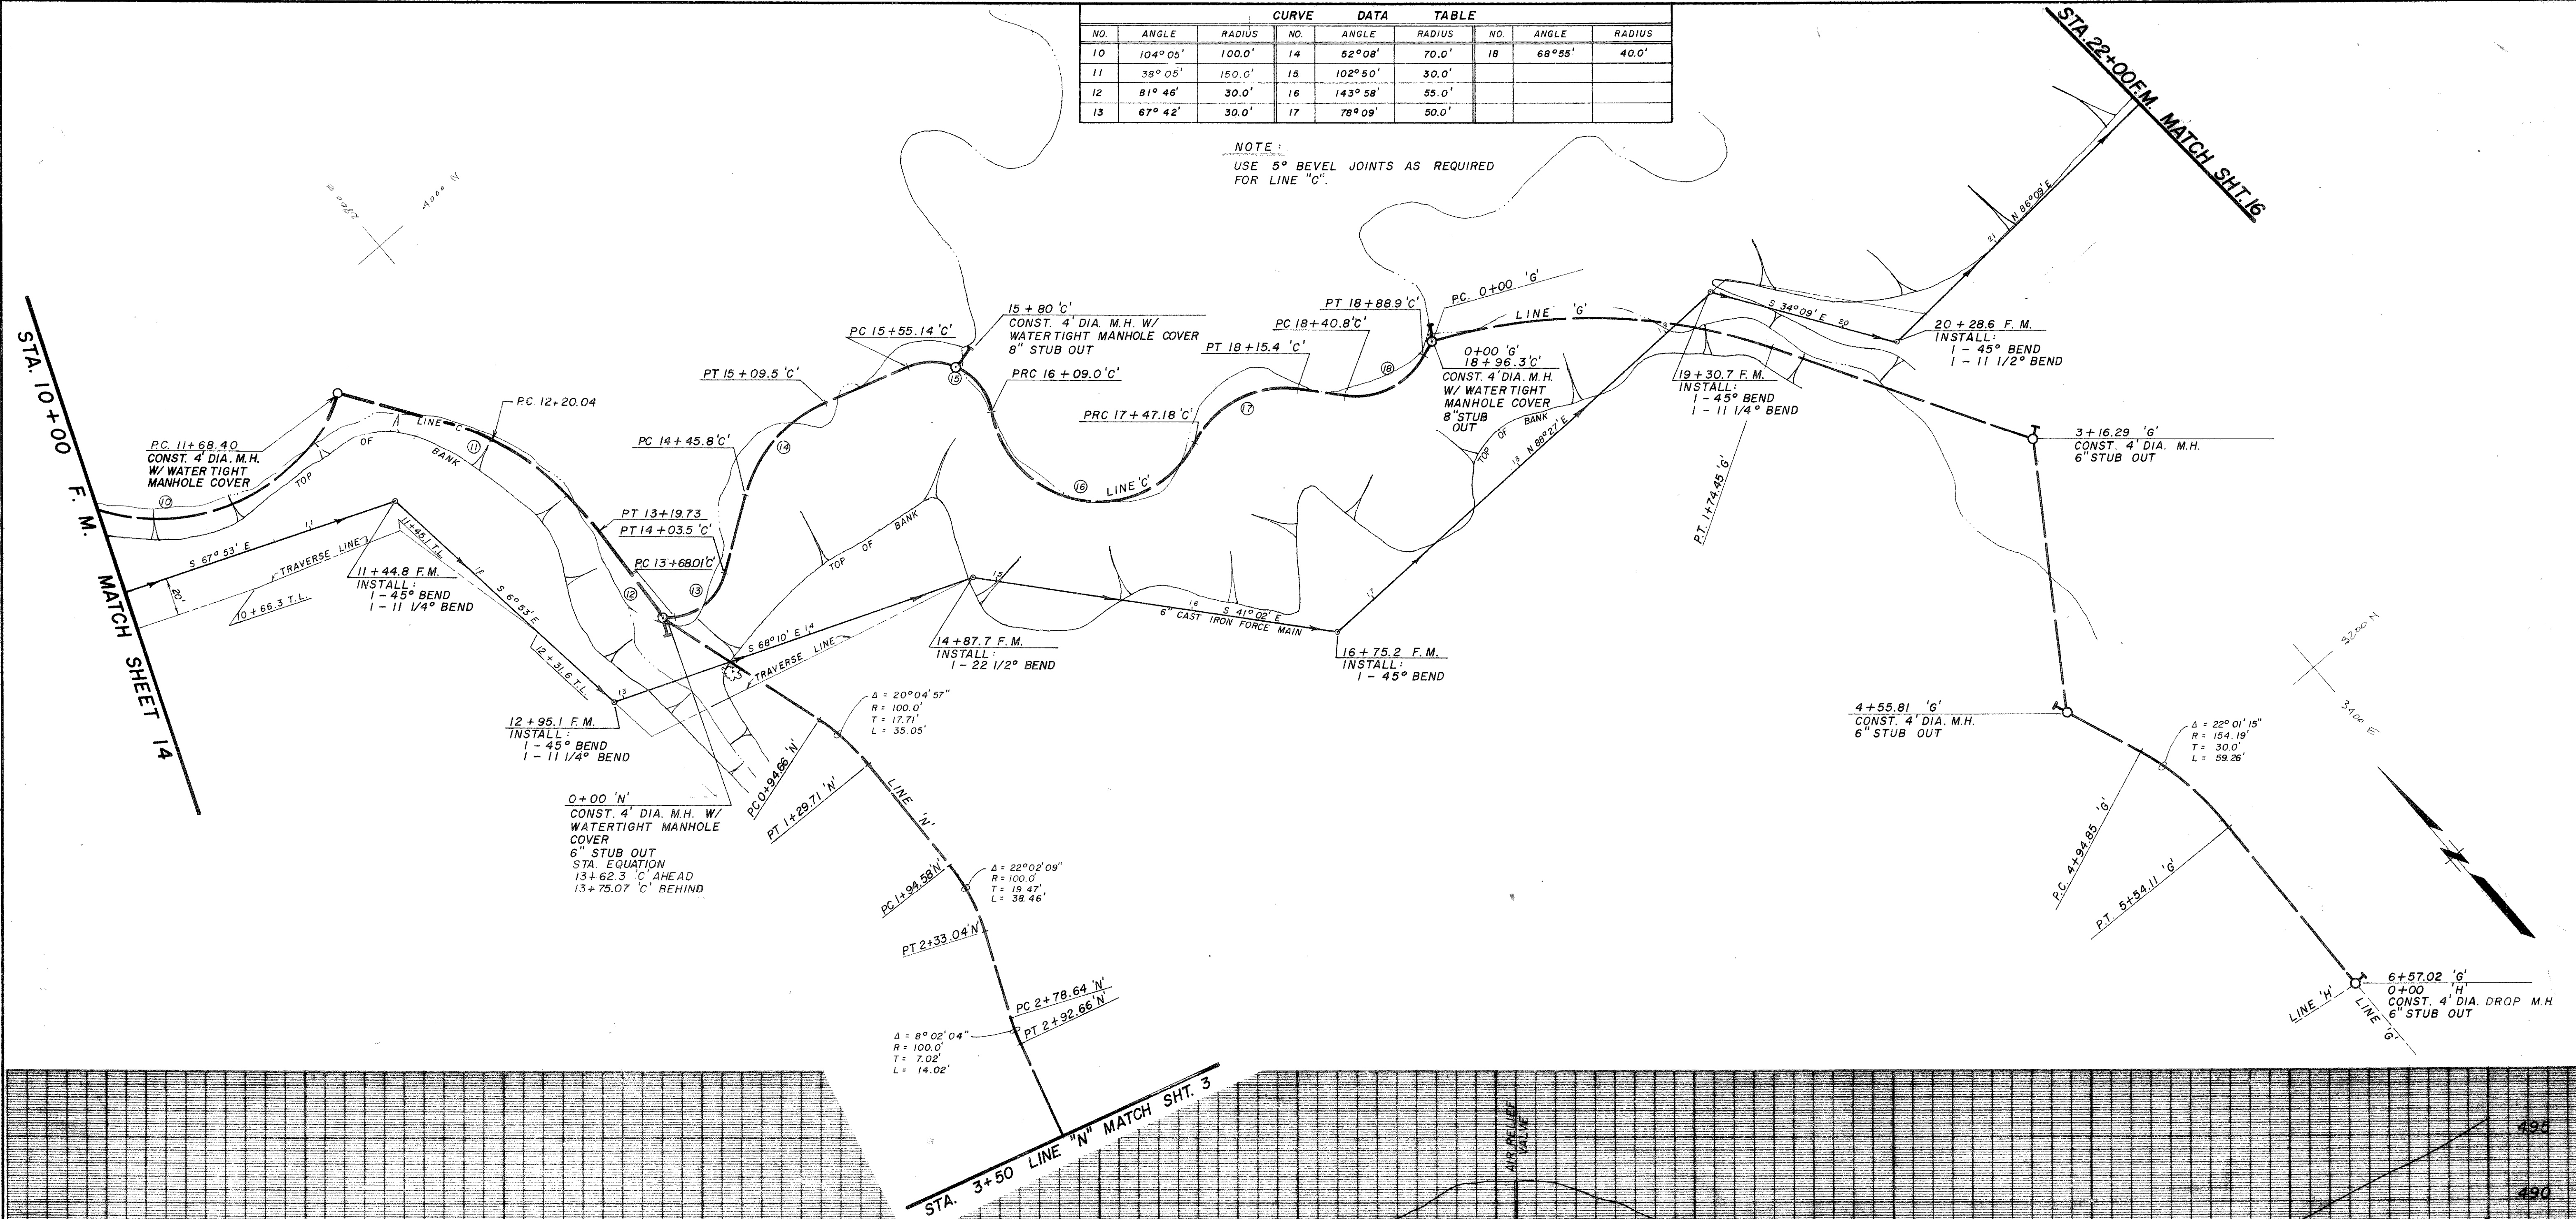

| CHANDLERS LANDING                |       |        |                    |       |      |       |
|----------------------------------|-------|--------|--------------------|-------|------|-------|
| PROPOSED SANITARY SEWER          |       |        |                    |       |      |       |
| FORCE MAIN, LINES "C", "G" & "N" |       |        |                    |       |      |       |
| ROCKWALL, TEXAS                  |       |        |                    |       |      |       |
| PHASE 12.33                      |       |        |                    |       |      |       |
| DESIGN                           | DRAWN | DATE   | SCALE              | NOTES | FILE | NO.   |
| H L E                            |       | 6/5/73 | 1"=40'H.<br>1"=6'V |       |      | 72122 |