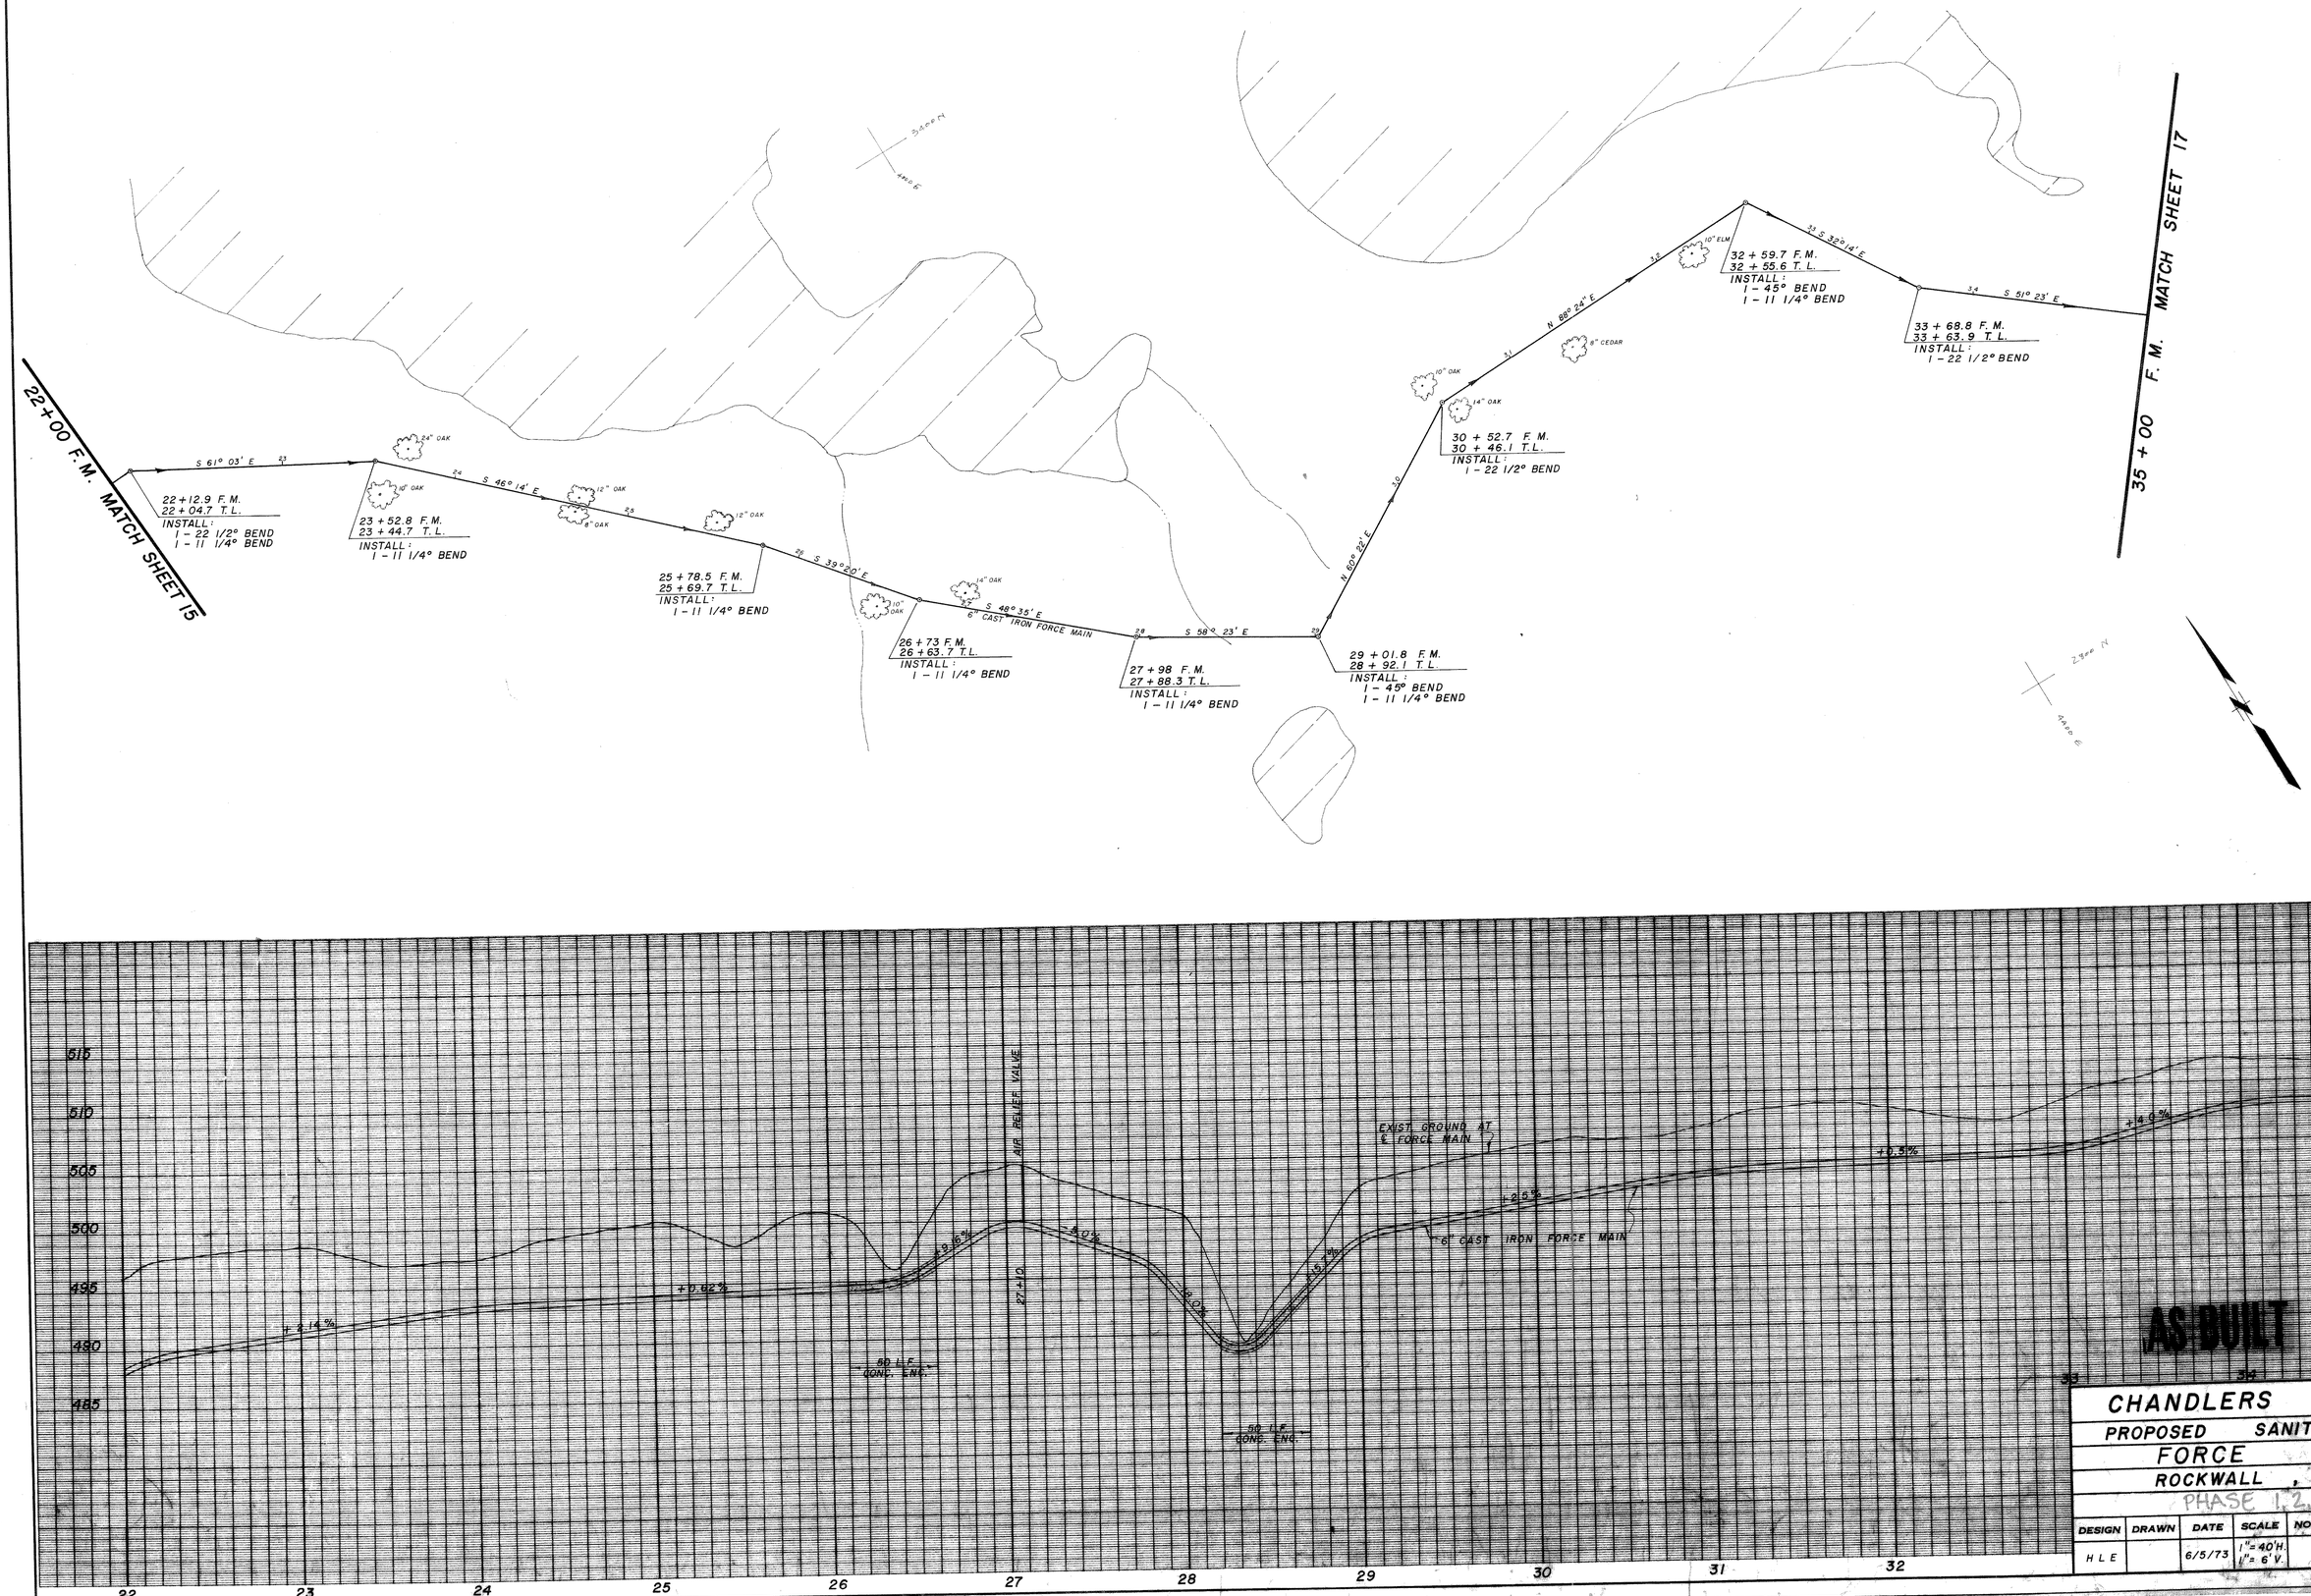

CHANDLERS LANDING

PROPOSED SANITARY SEWER

FORCE MAIN

ROCKWALL, TEXAS

PHASE 1, 2, & 3

DESIGN	DRAWN	DATE	SCALE	NOTES	FILE	NO.
HLE		6/5/73	1" = 40' H. 1" = 6' V.			72122