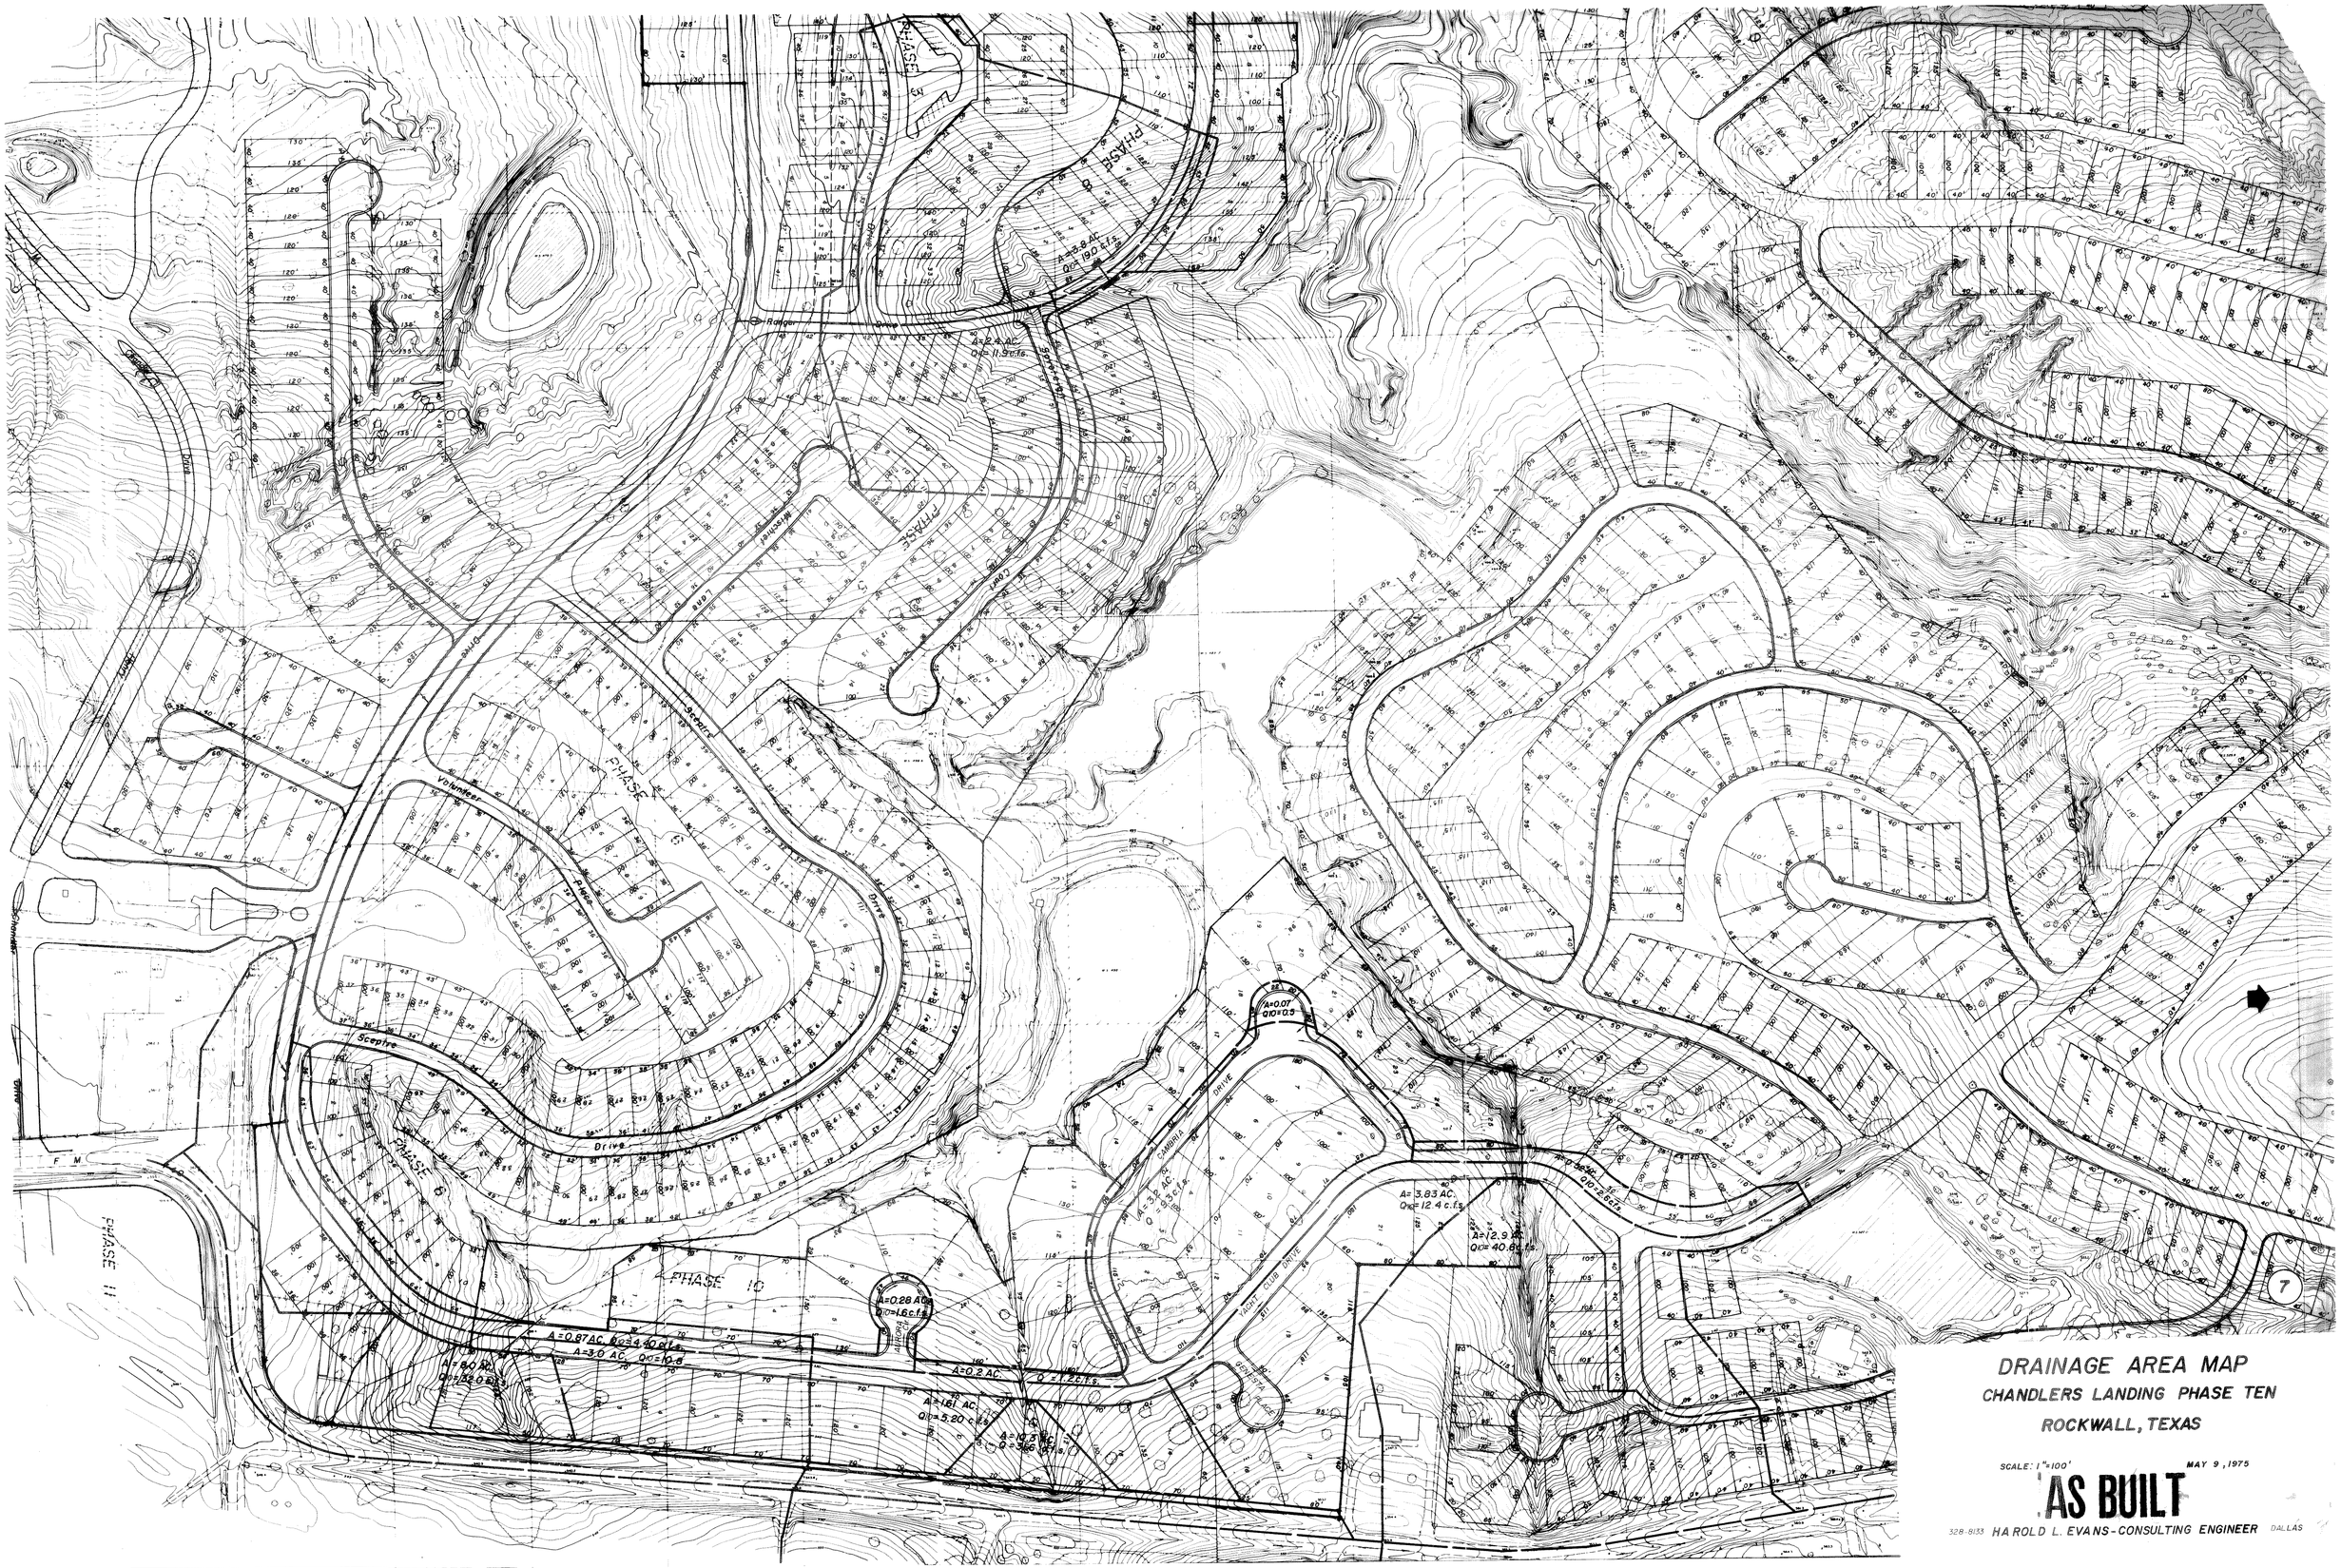

DRAINAGE AREA MAP

CHANDLERS LANDING PHASE TEN

ROCKWALL, TEXAS

SCALE: 1" = 100'

MAY 9, 1975

AS BUILT

328-8133 HAROLD L. EVANS - CONSULTING ENGINEER DALLAS