


ORIGINAL SURVEY		BY	DATE
NOTE BOOK			
	SURVEYED		
	PLOTTED		
	TEMPLATE		
	AREAS		
	AREAS CHECKED		

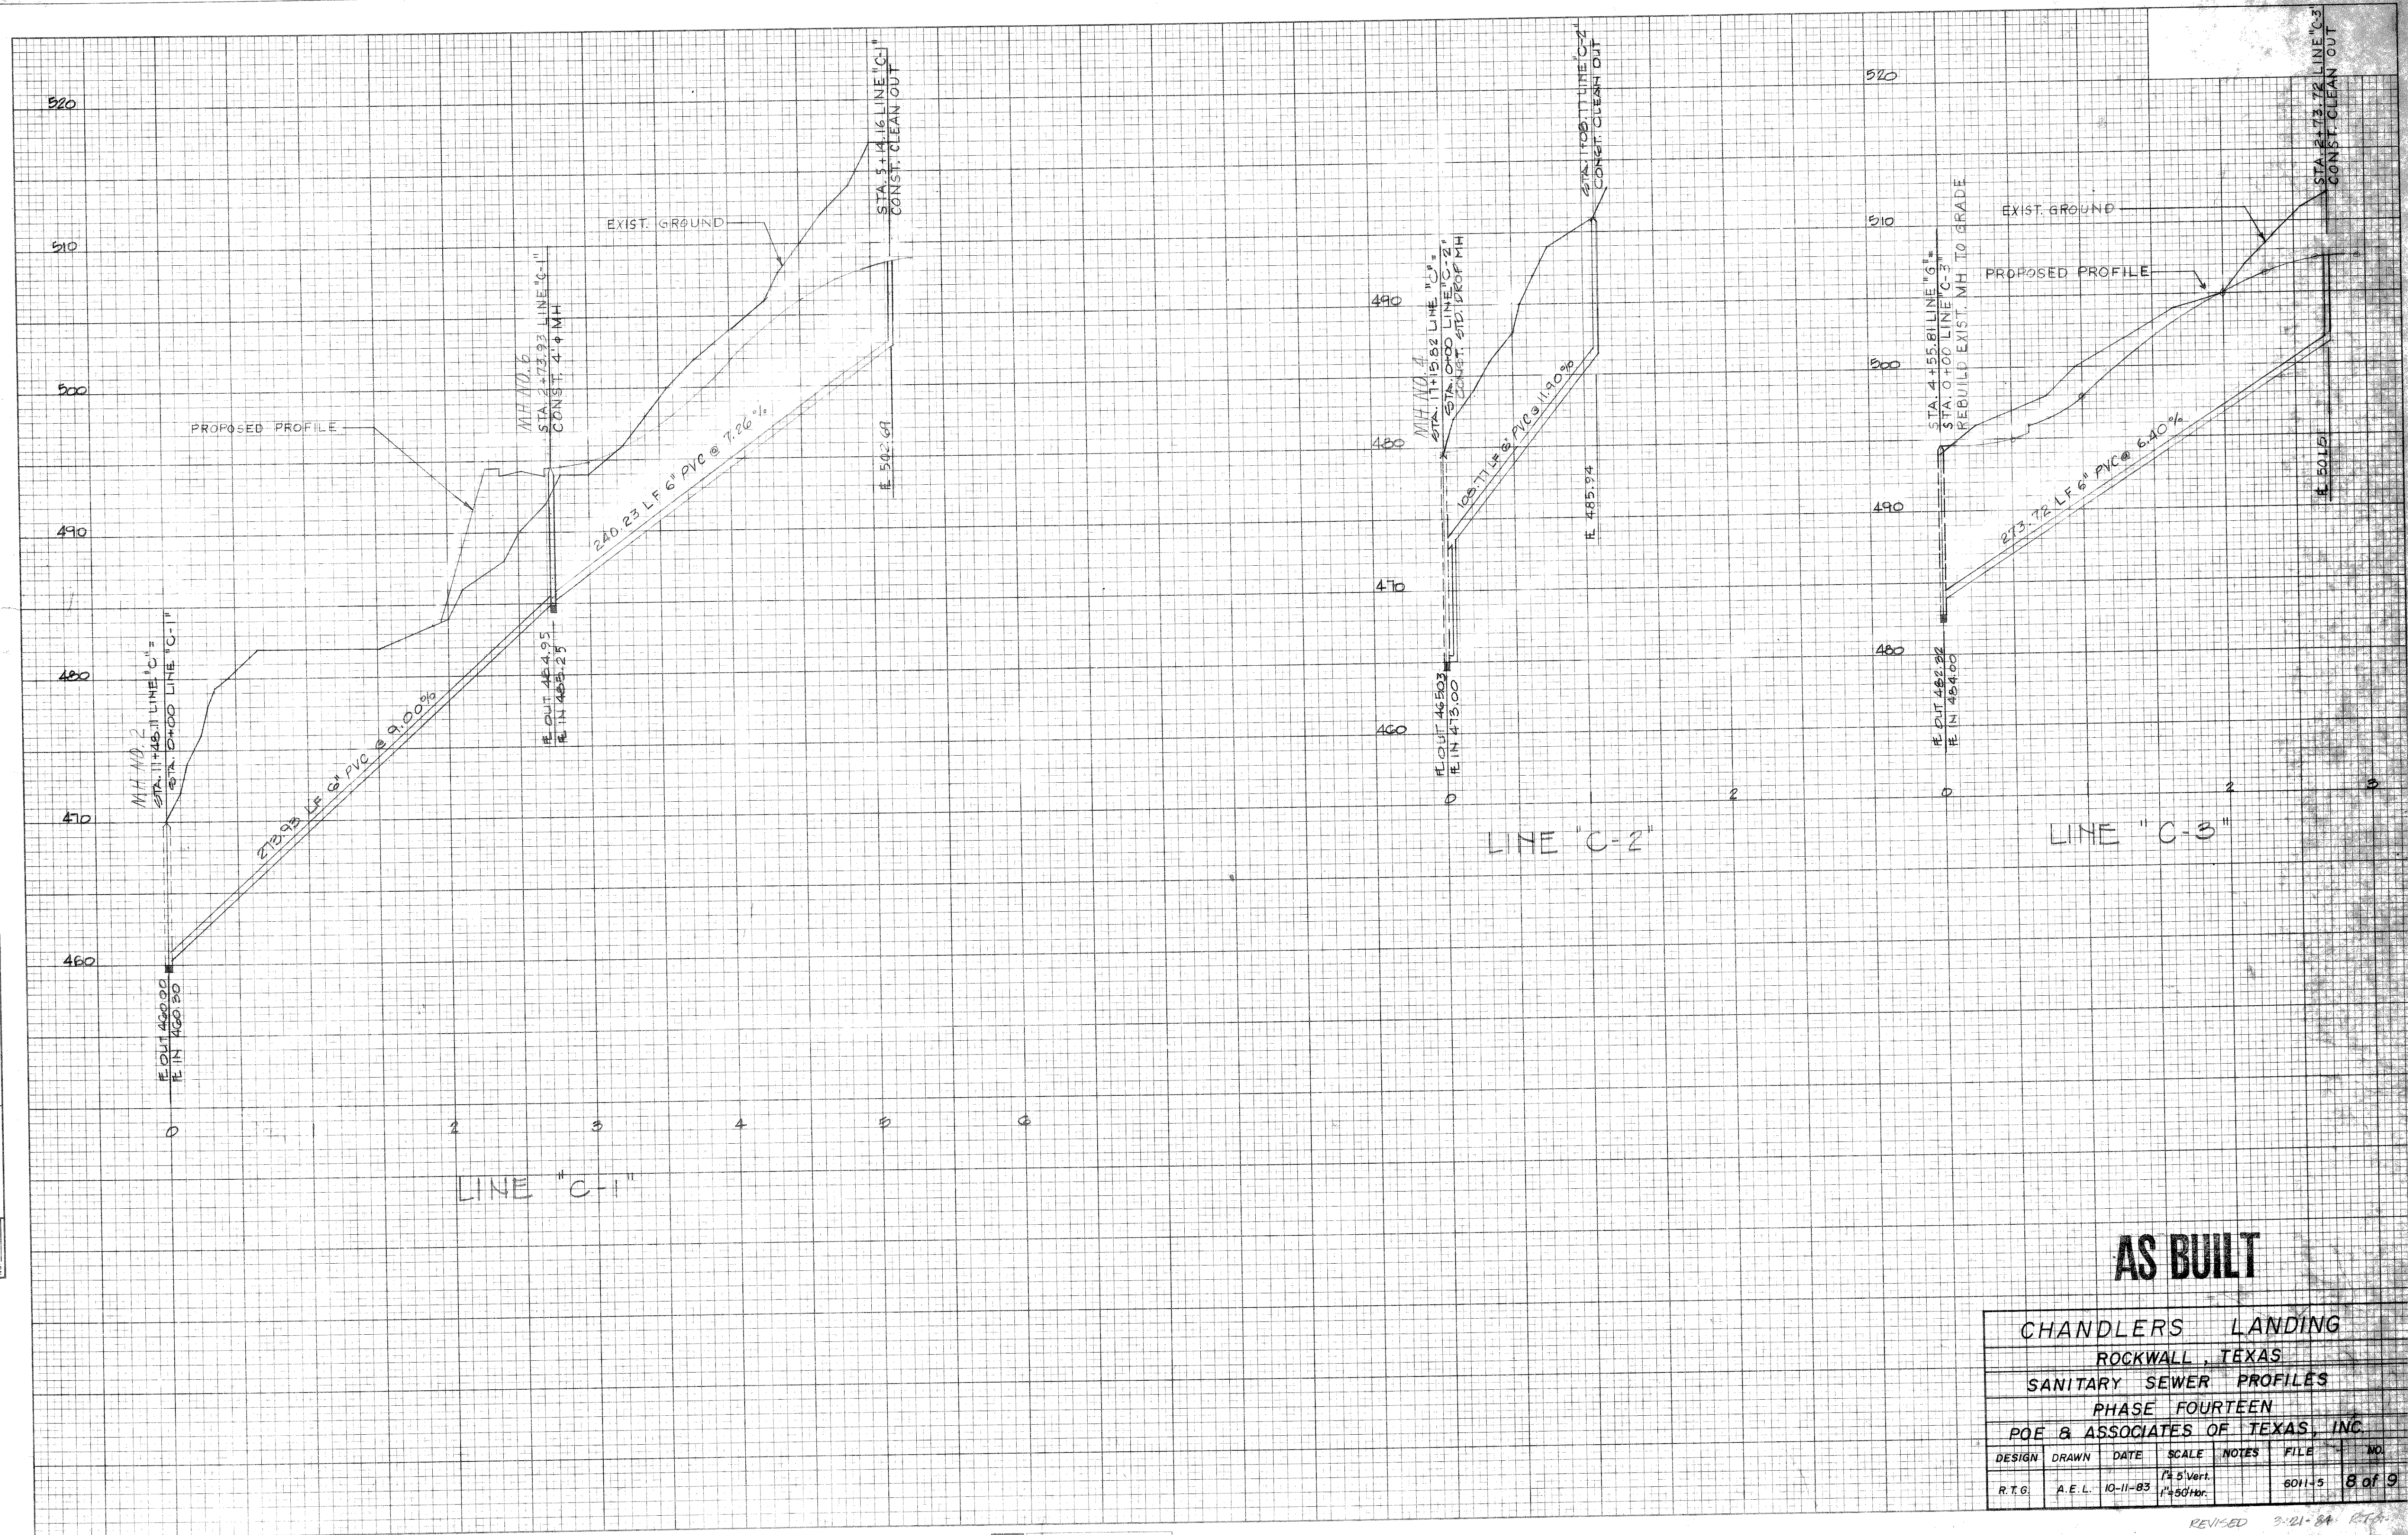

AS BUILT

CHANDLERS LANDING					
ROCKWALL, TEXAS					
SANITARY SEWER PROFILES					
PHASE FOURTEEN					
POE & ASSOCIATES OF TEXAS, INC.					
DESIGN	DRAWN	DATE	SCALE	NOTES	FILE NO.
R.T.G.	A.E.L.	10-11-83	1" = 5' Vert. 1" = 50' Hor.		6011-5 8 of 9

REVISED 3-21-84 R.T.P.