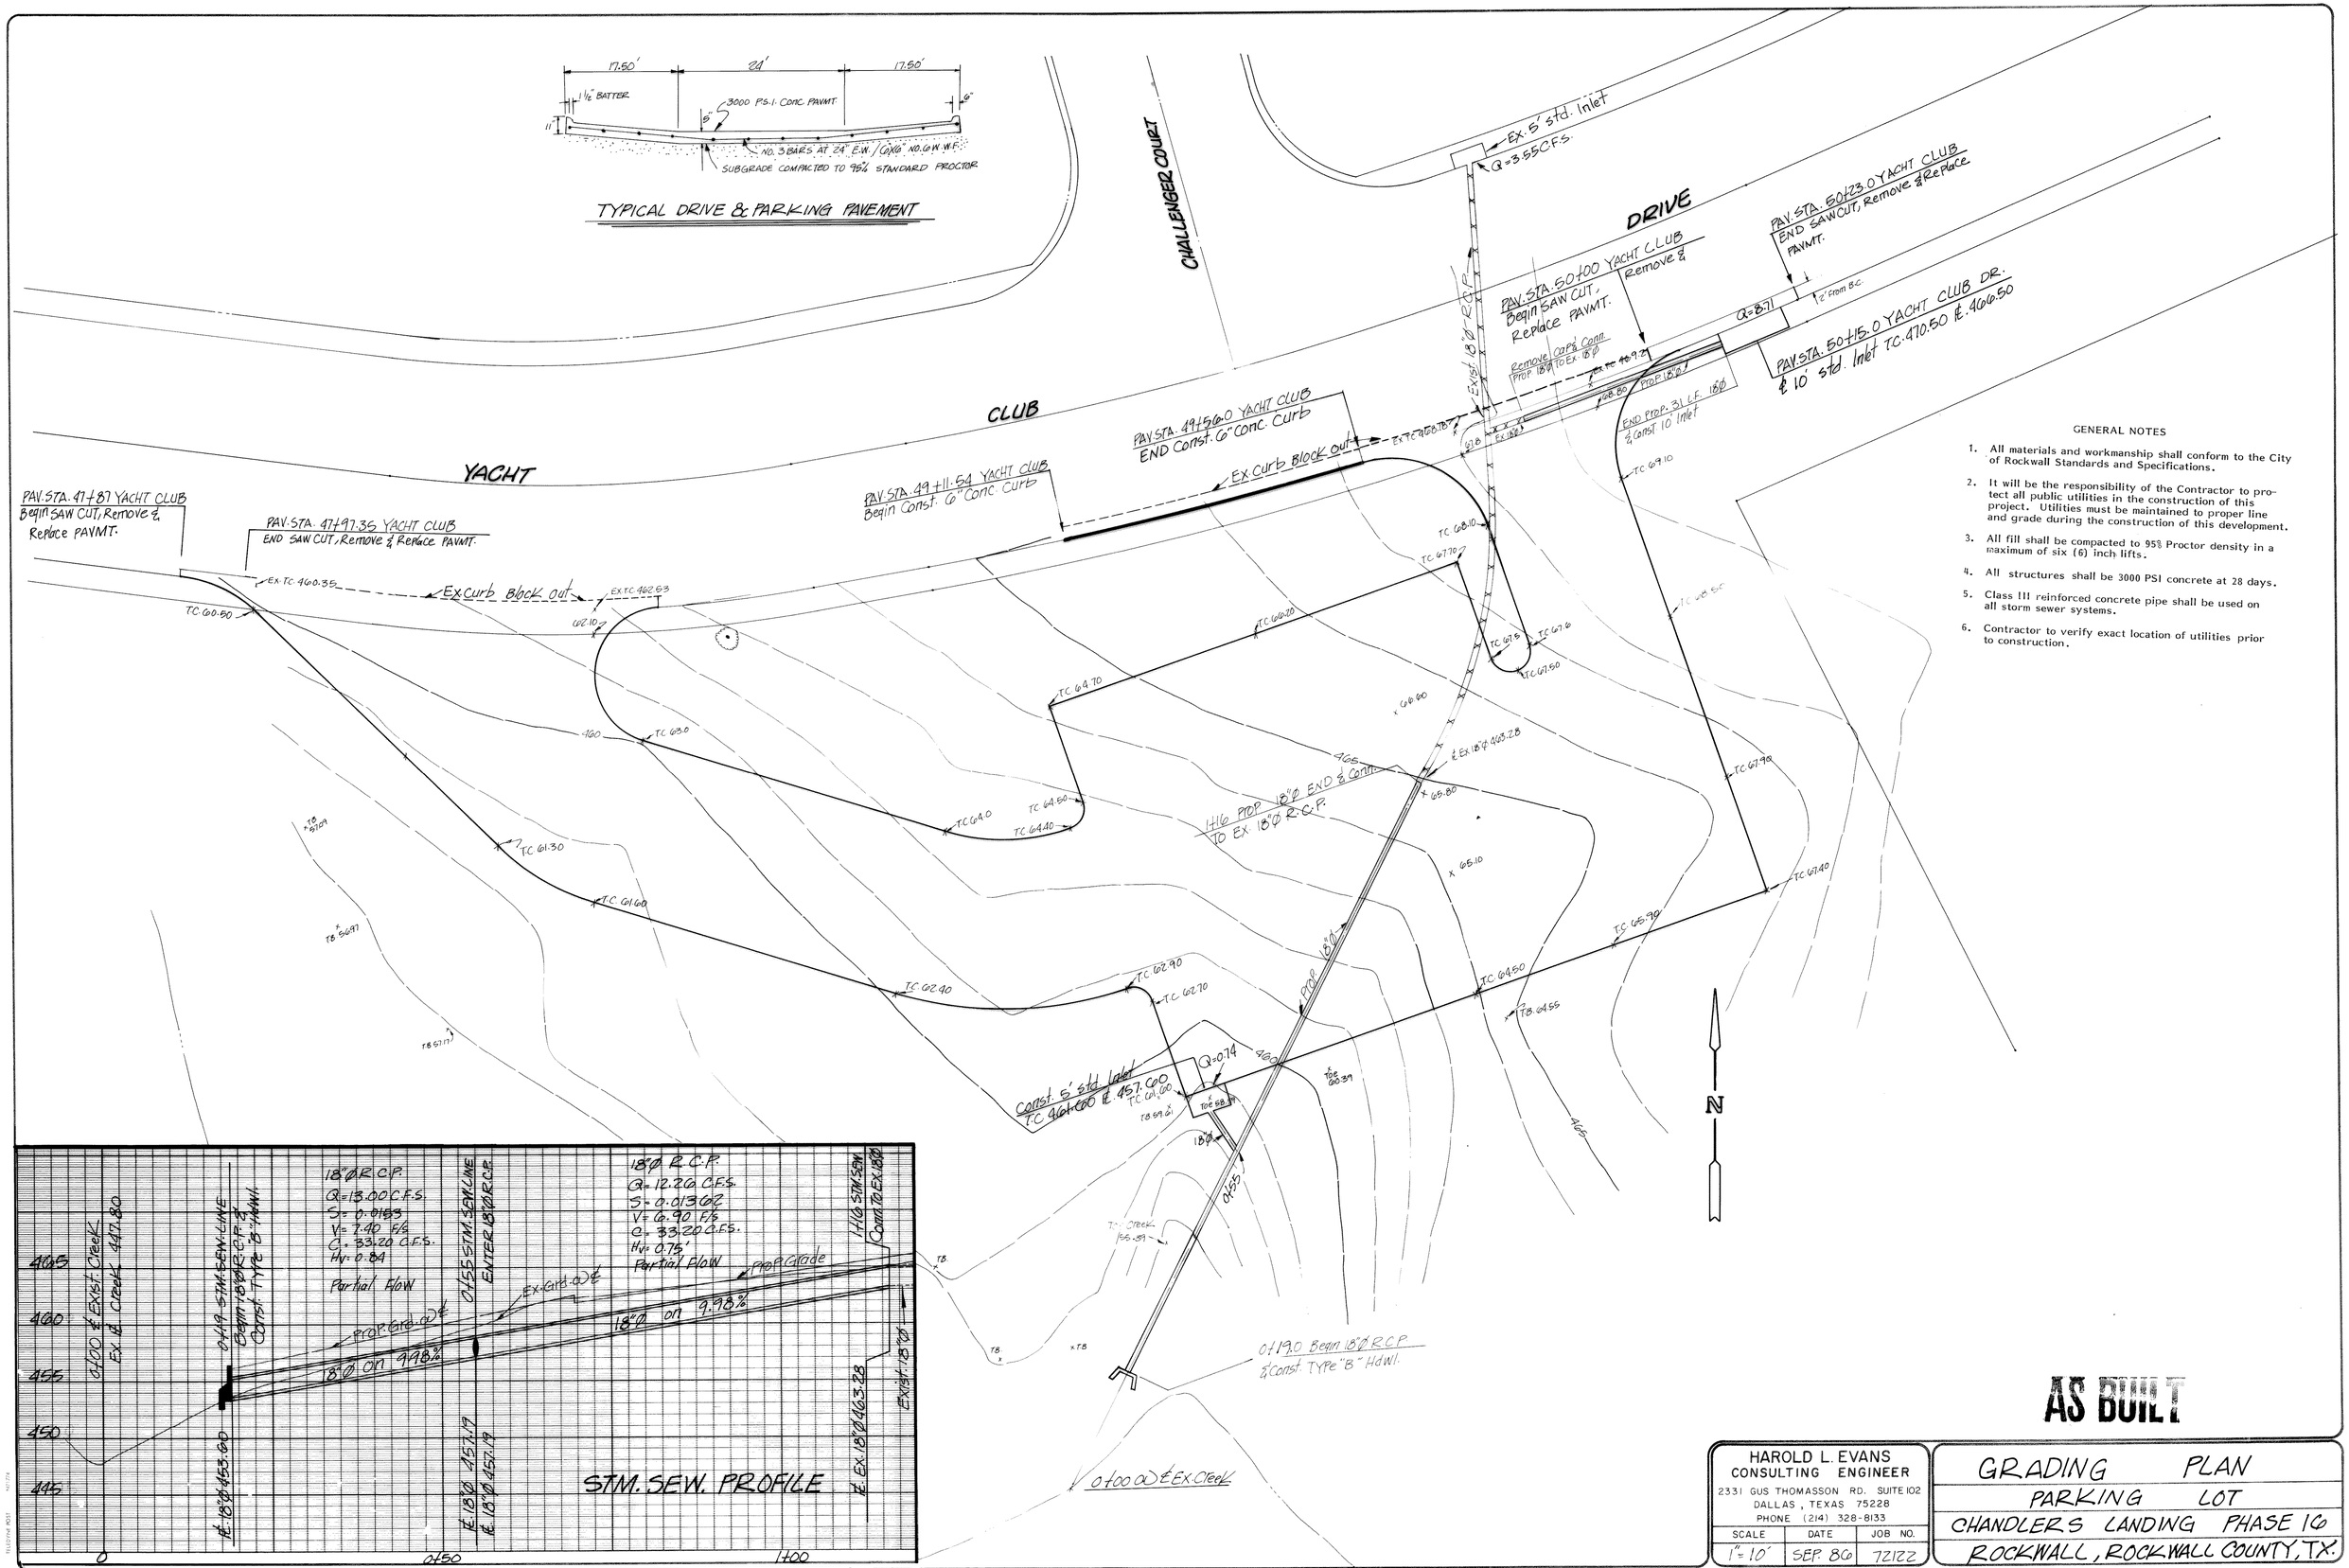
17.50'
24'
17.50'
1 1/2" BATTER
3000 P.S.I. CONC. PAVMT.
6"
11"
NO. 3 BARS AT 24" E.W. / 6"x6" NO. 6 W.W.F.
SUBGRADE COMPACTED TO 95% STANDARD PROCTOR
TYPICAL DRIVE & PARKING PAVEMENT
CHALLENGER COURT
YACHT CLUB DRIVE
Ex. 5' std. Inlet
Q=3.55 C.F.S.
PAV. STA. 50+00 YACHT CLUB
Begin SAW CUT, Remove & Replace PAVMT.
PAV. STA. 50+23.0 YACHT CLUB
END SAW CUT, Remove & Replace PAVMT.
2' from B.C.
Q=8.71
PAV. STA. 50+15.0 YACHT CLUB DR.
& 10' std. Inlet TC. 470.50 ℄. 466.50
Remove Corp's Conn. Prop. 18"Ø to Ex. 18"Ø
Prop. 18"Ø
END Prop. 31 L.F. 18"Ø & Const. 10' Inlet
Exist. 18"Ø R.C.P.
PAV. STA. 49+56.0 YACHT CLUB
END Const. 6" Conc. Curb
Ex. Curb Block out
PAV. STA. 49+11.54 YACHT CLUB
Begin Const. 6" Conc. Curb
PAV. STA. 47+87 YACHT CLUB
Begin SAW CUT, Remove & Replace PAVMT.
PAV. STA. 47+97.35 YACHT CLUB
END SAW CUT, Remove & Replace PAVMT.
Ex. Curb Block out
Ex. TC. 460.35
Ex. TC. 462.53
TC. 60.80
TC. 68.10
TC. 67.70
TC. 67.5
TC. 67.6
TC. 67.50
TC. 69.10
TC. 67.90
TC. 67.40
TC. 65.99
TC. 64.50
TC. 64.70
TC. 66.10
TC. 63.0
TC. 64.0
TC. 64.60
TC. 64.40
TC. 61.30
TC. 61.60
TC. 62.40
TC. 62.90
TC. 62.70
TC. 66.80
TC. 66.10
TC. 65.80
TC. 65.55
TC. 65.50
