


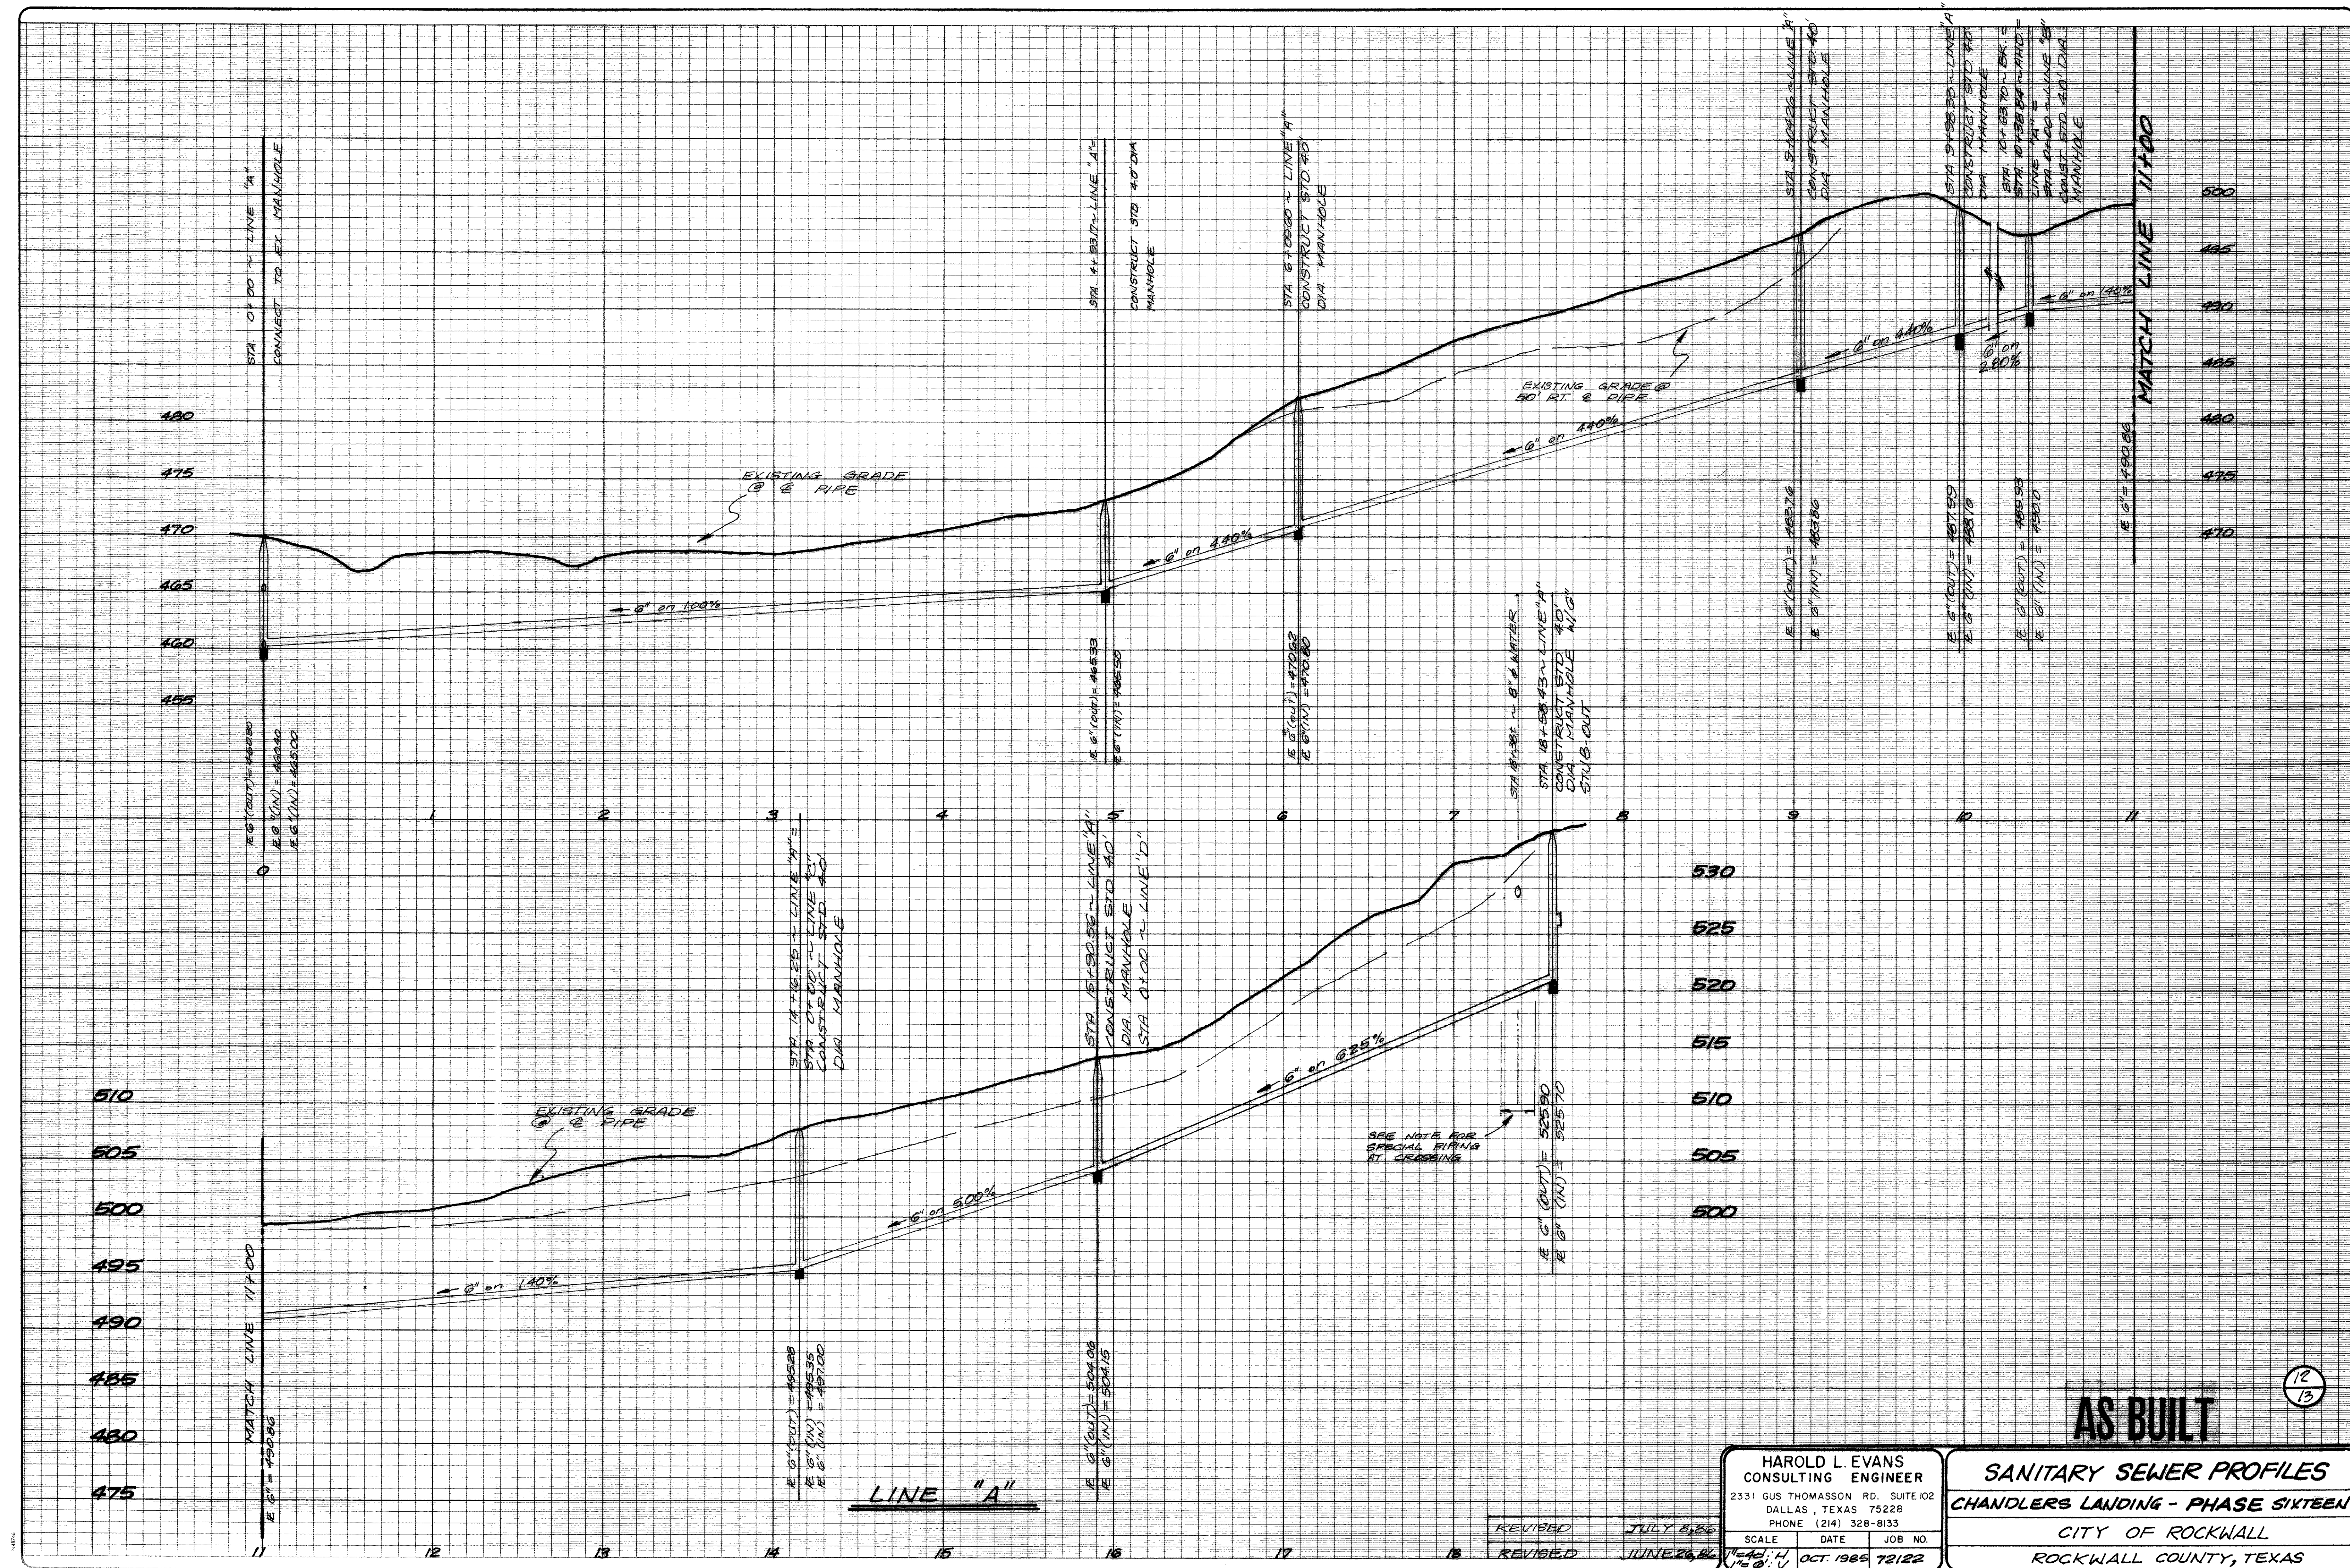

HAROLD L. EVANS
CONSULTING ENGINEER
2331 GUS THOMASSON RD. SUITE 102
DALLAS, TEXAS 75228
PHONE (214) 328-8133

SCALE	DATE	JOB NO.
1"=40'; 1/4"=10'	OCT. 1985	72122

SANITARY SEWER PROFILES
CHANDLERS LANDING - PHASE SIXTEEN
CITY OF ROCKWALL
ROCKWALL COUNTY, TEXAS