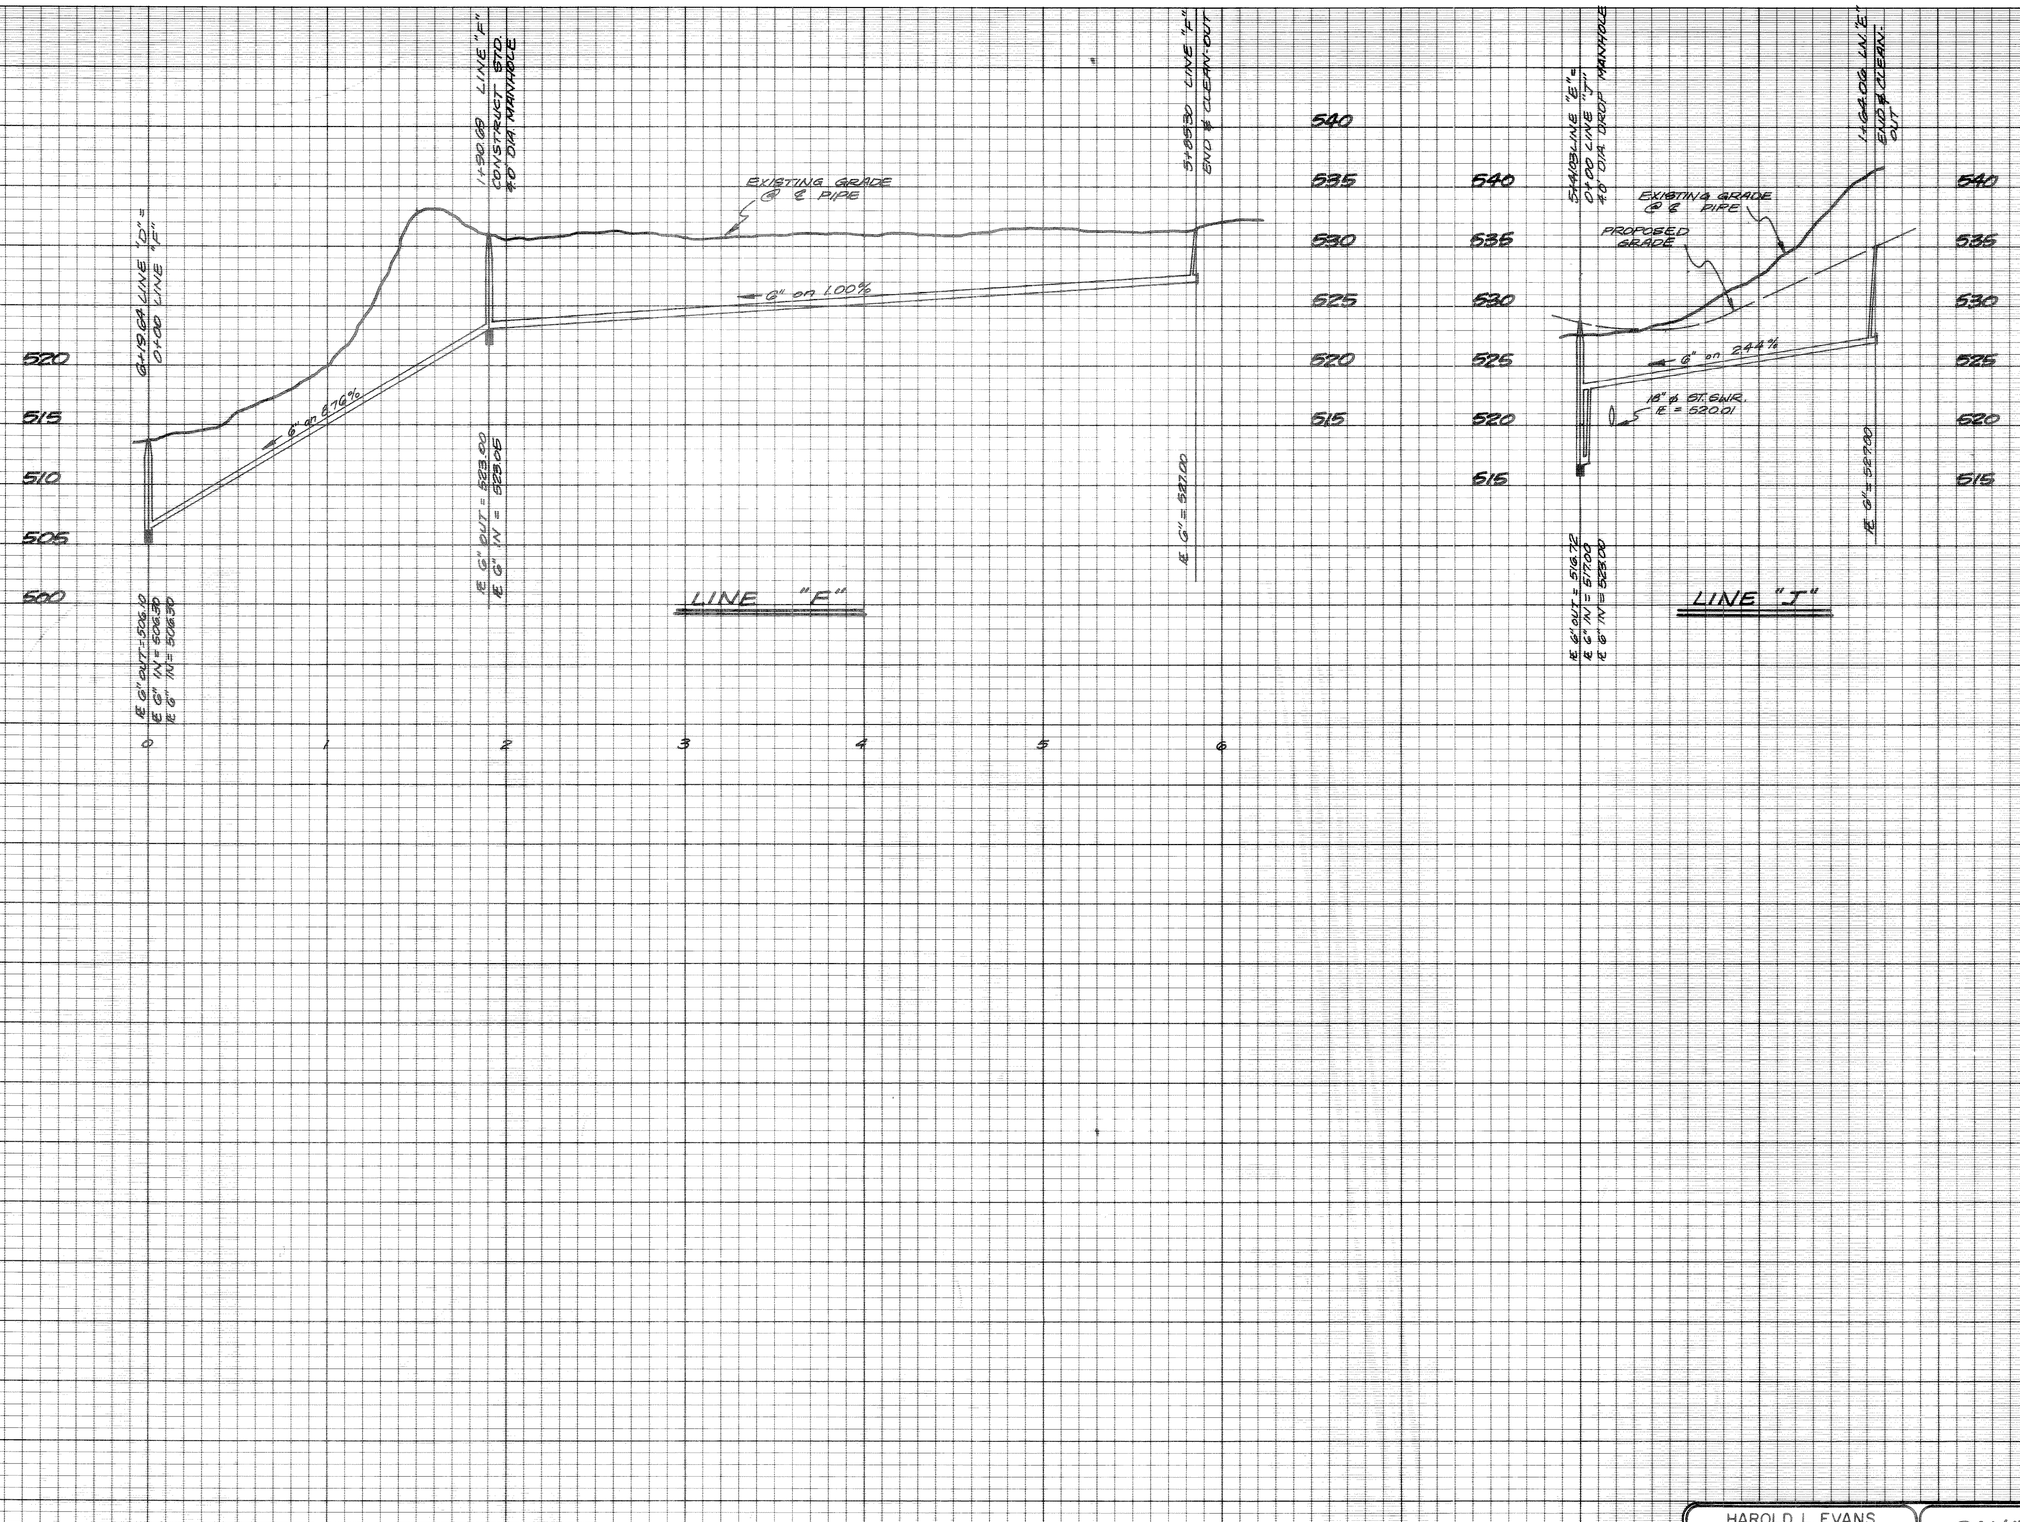

REVISED PER CONSTRUCTION STAKING NOV. 13, 1986

AS BUILT

19/19

HAROLD L. EVANS
CONSULTING ENGINEER
2331 GUS THOMASSON RD. SUITE 102
DALLAS, TEXAS 75228
PHONE (214) 328-8133

SCALE	DATE	JOB NO.
1"=40' : H 1"=6' : V	9-16-86	72122

SANITARY SEWER PROFILES

CHANDLERS LANDING - PHASE NINTEEN

CITY OF ROCKWALL

ROCKWALL COUNTY, TEXAS