


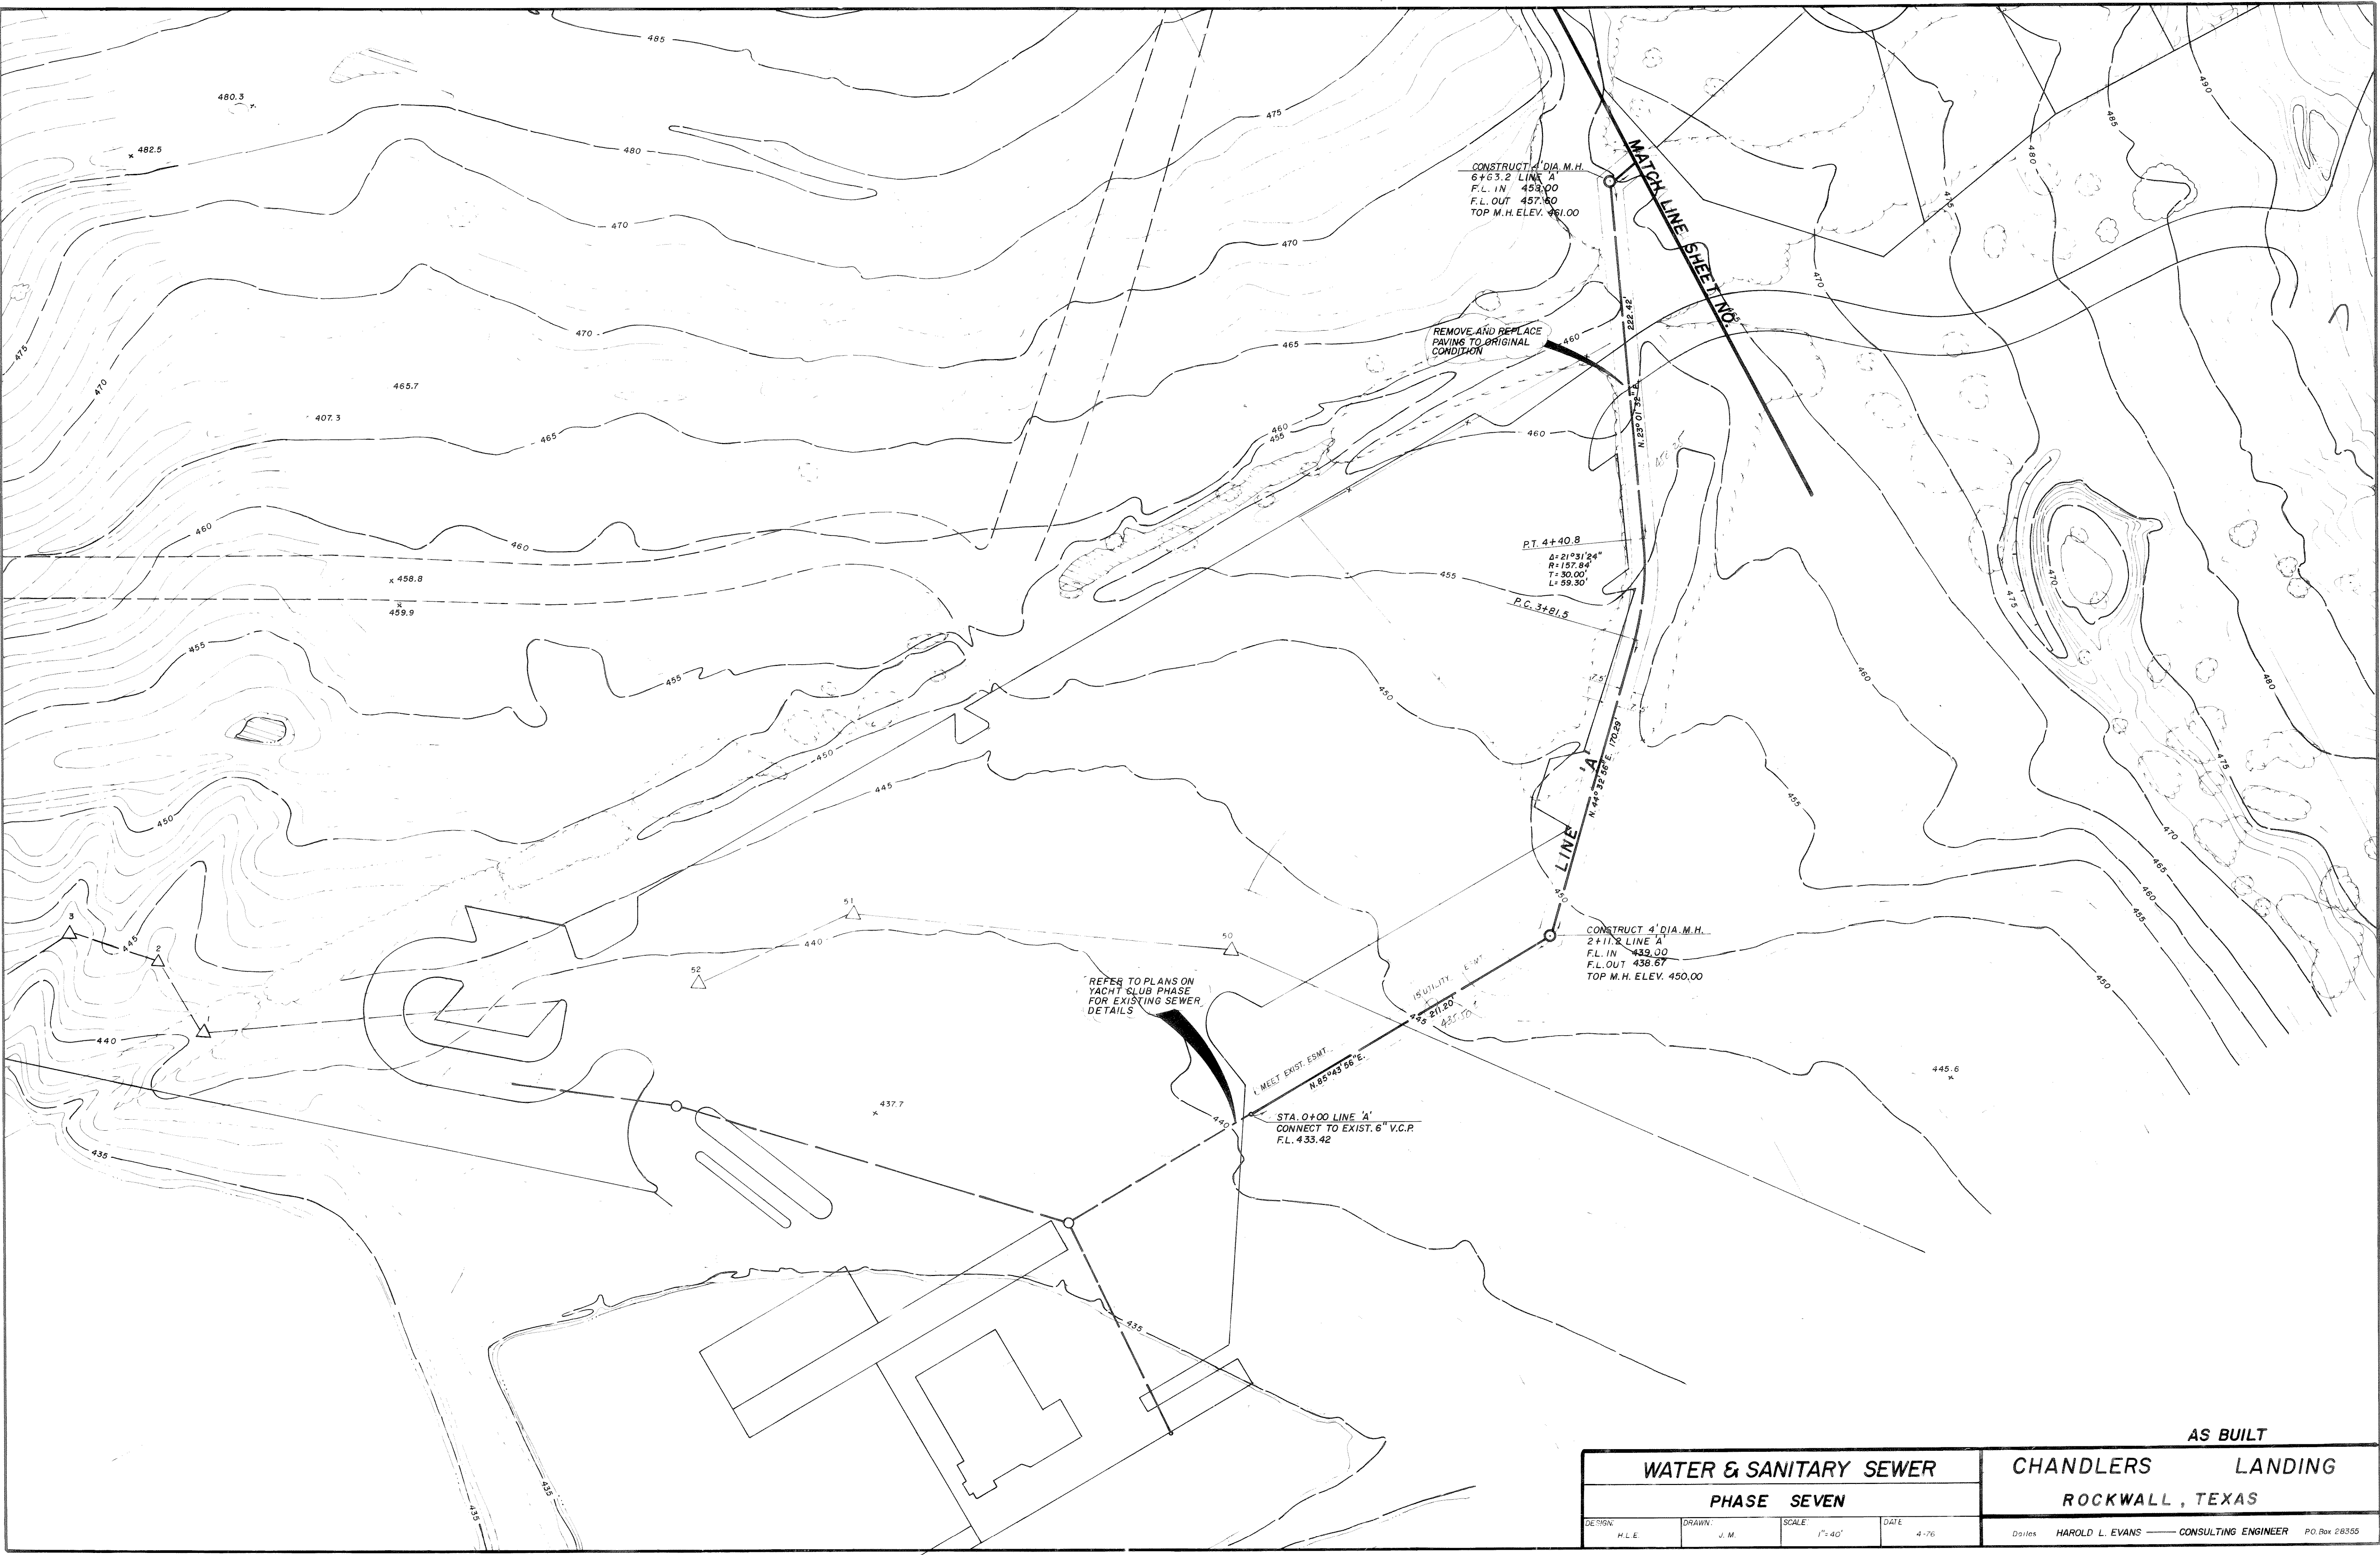

AS BUILT			
WATER & SANITARY SEWER		CHANDLERS LANDING	
PHASE SEVEN		ROCKWALL, TEXAS	
DESIGN: H.L.E.	DRAWN: J.M.	SCALE: 1"=40'	DATE: 4-76
Drafter: HAROLD L. EVANS — CONSULTING ENGINEER P.O. Box 28355			