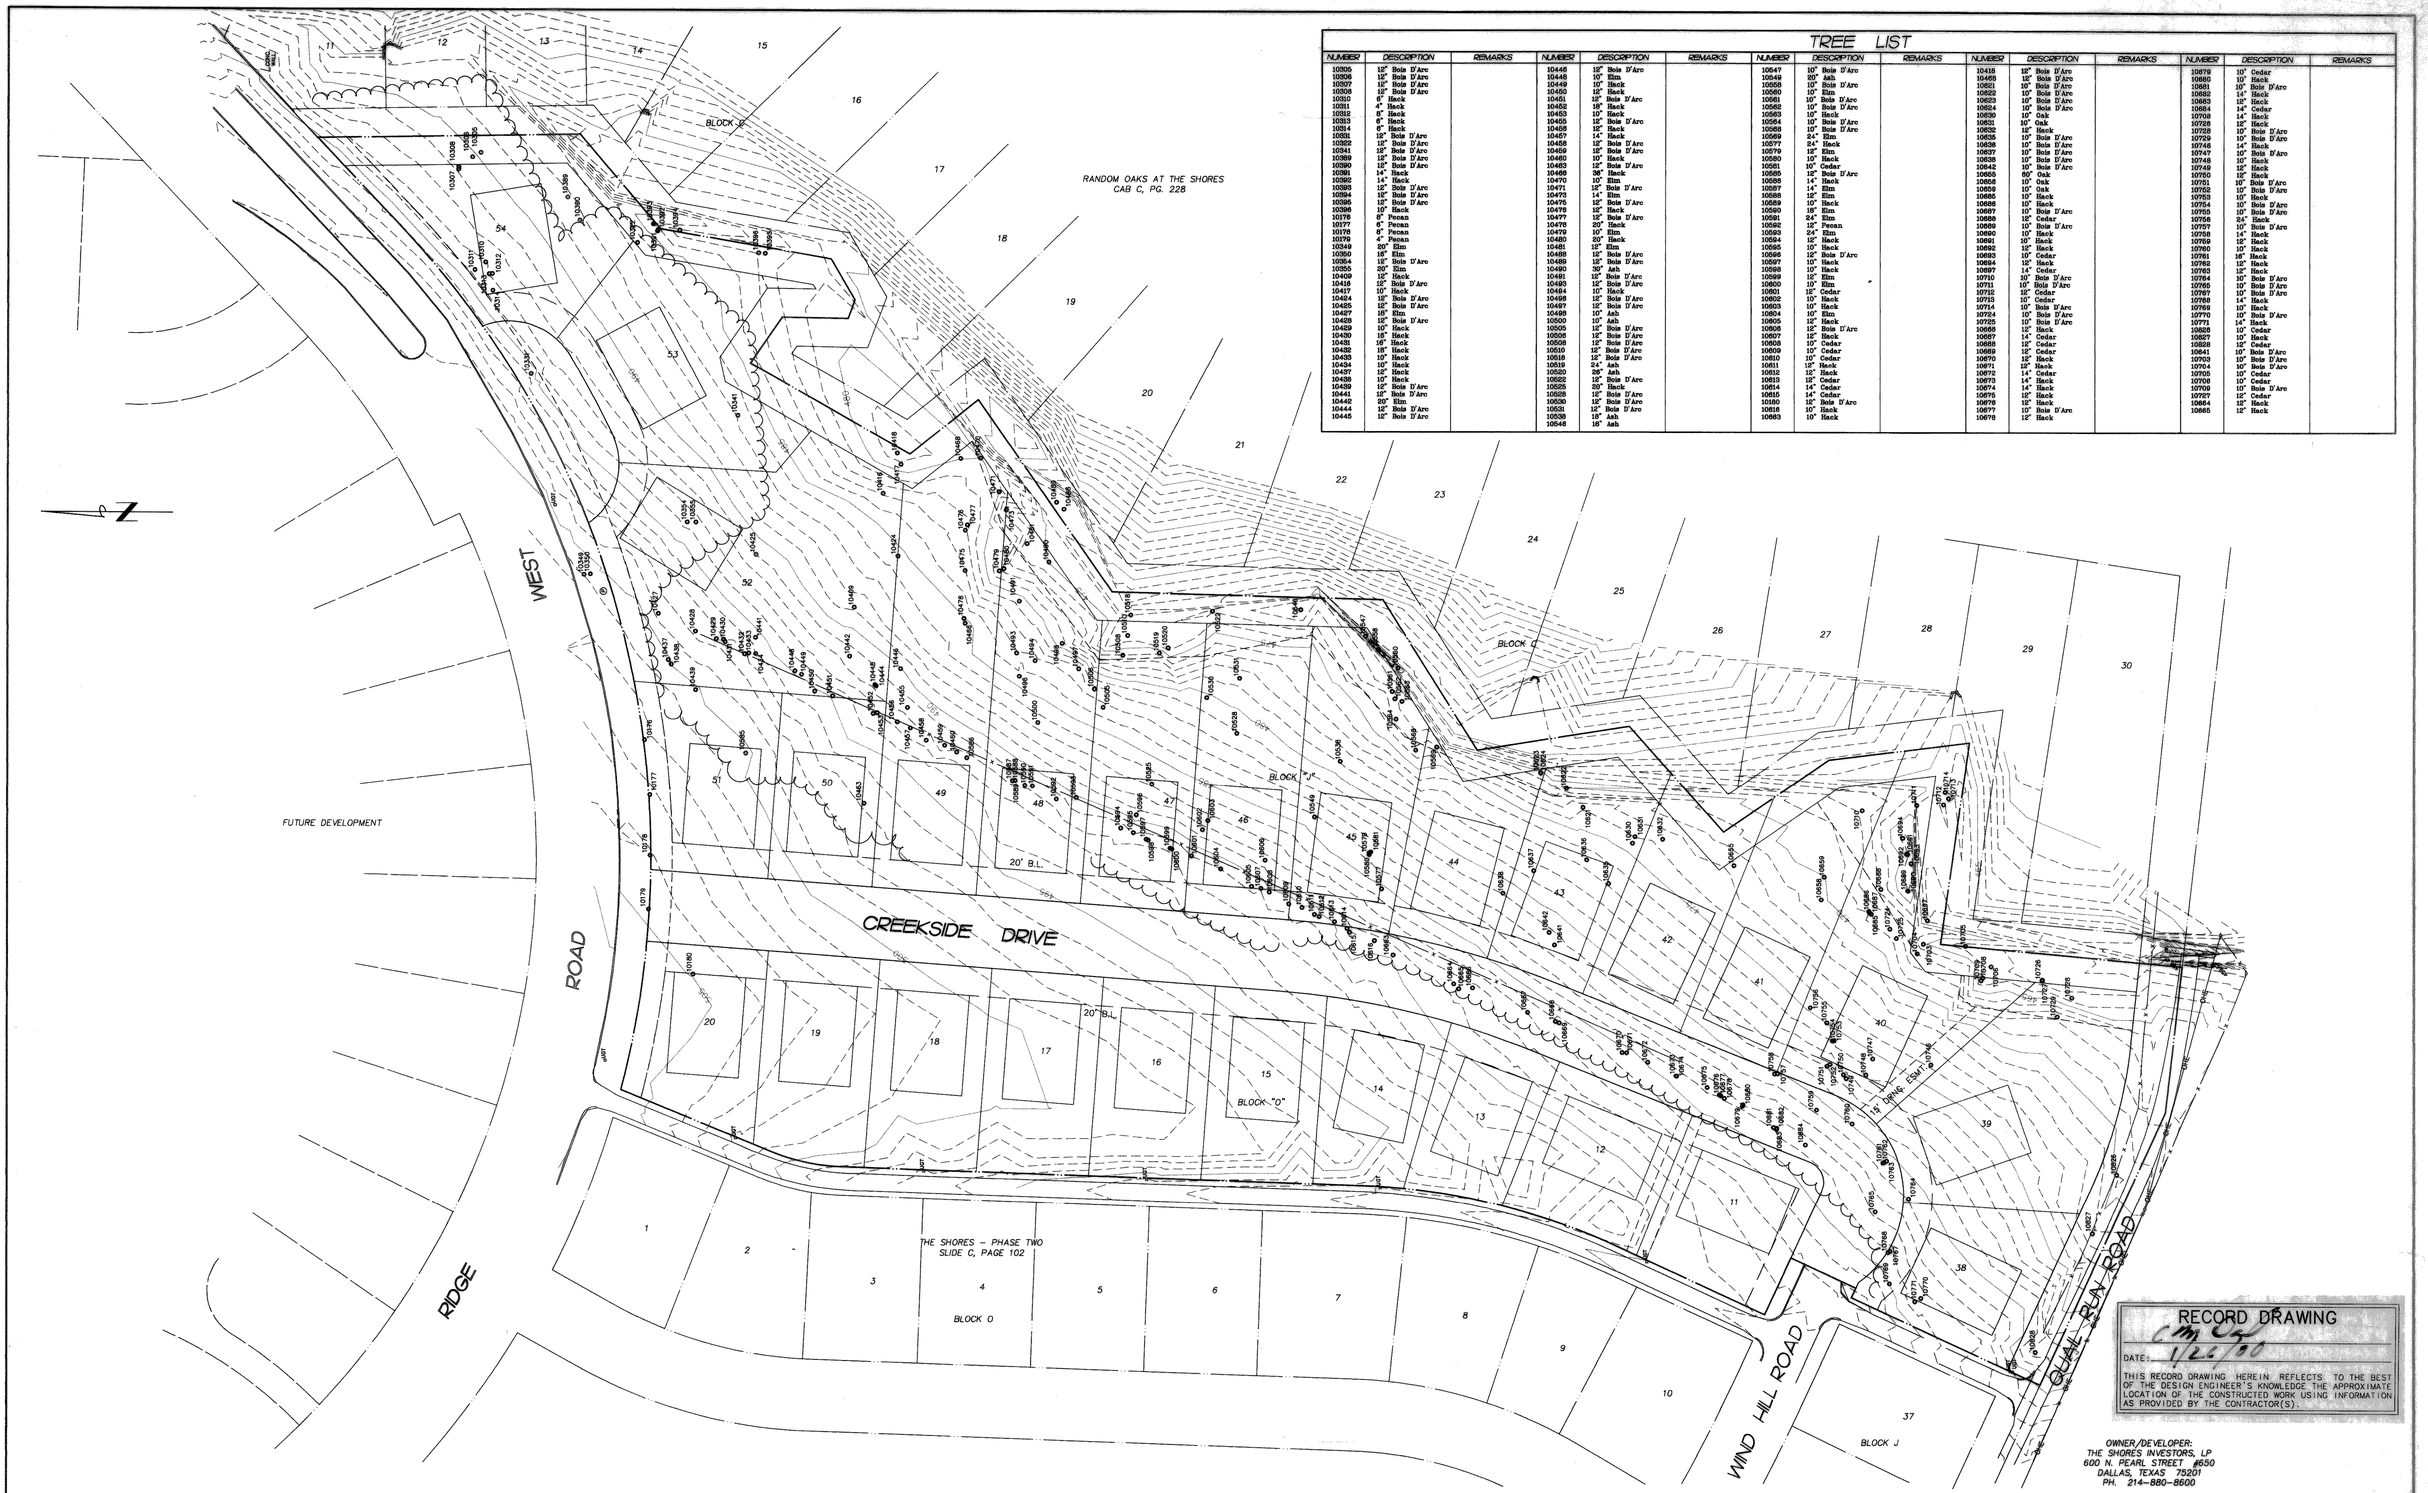

TREE LIST

NUMBER	DESCRIPTION	REMARKS	NUMBER	DESCRIPTION	REMARKS	NUMBER	DESCRIPTION	REMARKS	NUMBER	DESCRIPTION	REMARKS	NUMBER	DESCRIPTION	REMARKS
10305	12" Bois D'Arc		10446	18" Bois D'Arc		10547	10" Bois D'Arc		10418	12" Bois D'Arc		10878	10" Cedar	
10306	12" Bois D'Arc		10448	10" Elm		10549	20" Ash		10469	12" Bois D'Arc		10880	10" Hack	
10307	12" Bois D'Arc		10449	10" Hack		10558	10" Bois D'Arc		10521	10" Bois D'Arc		10881	18" Bois D'Arc	
10308	12" Bois D'Arc		10450	12" Hack		10560	10" Elm		10522	10" Bois D'Arc		10882	14" Hack	
10310	6" Hack		10451	18" Bois D'Arc		10561	10" Bois D'Arc		10523	10" Bois D'Arc		10883	12" Hack	
10311	4" Hack		10452	18" Hack		10562	10" Bois D'Arc		10524	10" Bois D'Arc		10884	14" Cedar	
10312	8" Hack		10453	10" Hack		10563	10" Hack		10530	10" Oak		10703	14" Hack	
10313	6" Hack		10455	12" Bois D'Arc		10564	10" Bois D'Arc		10531	10" Oak		10728	18" Hack	
10314	6" Hack		10459	12" Hack		10568	10" Bois D'Arc		10532	10" Hack		10729	10" Bois D'Arc	
10331	12" Bois D'Arc		10467	14" Hack		10569	24" Elm		10535	10" Bois D'Arc		10730	10" Bois D'Arc	
10332	12" Bois D'Arc		10468	12" Bois D'Arc		10577	24" Hack		10536	10" Bois D'Arc		10746	14" Hack	
10341	12" Bois D'Arc		10469	18" Bois D'Arc		10579	18" Elm		10537	10" Bois D'Arc		10747	10" Bois D'Arc	
10359	12" Bois D'Arc		10460	10" Hack		10580	10" Hack		10539	10" Bois D'Arc		10748	10" Hack	
10360	12" Bois D'Arc		10463	18" Bois D'Arc		10581	10" Cedar		10542	10" Bois D'Arc		10749	10" Hack	
10361	14" Hack		10469	36" Hack		10585	12" Bois D'Arc		10655	60" Oak		10750	18" Hack	
10362	14" Hack		10470	10" Elm		10586	14" Hack		10656	10" Oak		10751	10" Bois D'Arc	
10363	12" Bois D'Arc		10471	10" Bois D'Arc		10587	14" Elm		10659	10" Oak		10752	10" Bois D'Arc	
10364	12" Bois D'Arc		10473	14" Elm		10588	12" Elm		10665	10" Hack		10753	10" Hack	
10365	12" Bois D'Arc		10476	18" Bois D'Arc		10589	10" Hack		10666	10" Hack		10754	10" Bois D'Arc	
10366	10" Hack		10477	12" Hack		10590	12" Hack		10667	10" Bois D'Arc		10755	10" Elm	
10176	6" Pecan		10479	18" Bois D'Arc		10591	24" Elm		10688	12" Cedar		10756	24" Hack	
10177	6" Pecan		10470	20" Hack		10592	12" Pecan		10689	10" Bois D'Arc		10757	10" Bois D'Arc	
10178	6" Pecan		10479	10" Elm		10593	24" Elm		10690	10" Hack		10758	14" Hack	
10179	4" Pecan		10480	20" Hack		10594	12" Hack		10691	10" Hack		10759	12" Hack	
10349	20" Elm		10481	12" Elm		10595	10" Hack		10692	12" Hack		10760	10" Hack	
10350	16" Elm		10488	18" Bois D'Arc		10596	12" Bois D'Arc		10693	10" Cedar		10761	18" Hack	
10354	12" Bois D'Arc		10489	18" Bois D'Arc		10597	10" Hack		10694	12" Hack		10762	12" Hack	
10355	20" Elm		10490	30" Ash		10598	10" Hack		10696	14" Cedar		10763	12" Hack	
10409	12" Hack		10491	18" Bois D'Arc		10599	12" Elm		10697	14" Cedar		10764	10" Bois D'Arc	
10416	12" Bois D'Arc		10493	18" Bois D'Arc		10600	10" Elm		10710	10" Bois D'Arc		10765	10" Bois D'Arc	
10417	10" Hack		10494	10" Hack		10601	18" Cedar		10711	10" Bois D'Arc		10766	10" Bois D'Arc	
10424	12" Bois D'Arc		10498	18" Bois D'Arc		10602	10" Hack		10712	12" Cedar		10767	10" Bois D'Arc	
10425	12" Bois D'Arc		10497	18" Bois D'Arc		10603	10" Hack		10713	12" Cedar		10768	14" Hack	
10427	16" Elm		10498	10" Ash		10604	10" Elm		10714	10" Bois D'Arc		10769	18" Hack	
10428	12" Bois D'Arc		10500	10" Ash		10605	12" Hack		10724	10" Bois D'Arc		10770	10" Bois D'Arc	
10429	10" Hack		10505	18" Bois D'Arc		10606	12" Bois D'Arc		10725	10" Bois D'Arc		10771	14" Hack	
10430	10" Hack		10506	18" Bois D'Arc		10607	12" Hack		10668	12" Hack		10828	10" Cedar	
10431	16" Hack		10508	18" Bois D'Arc		10608	10" Cedar		10669	14" Cedar		10827	10" Hack	
10432	18" Hack		10510	18" Bois D'Arc		10609	10" Cedar		10670	12" Cedar		10828	12" Cedar	
10433	10" Hack		10518	18" Bois D'Arc		10610	10" Cedar		10671	12" Cedar		10829	12" Cedar	
10434	10" Hack		10519	24" Ash		10611	12" Hack		10672	12" Hack		10841	10" Bois D'Arc	
10437	12" Hack		10520	26" Ash		10612	12" Hack		10673	14" Cedar		10703	10" Bois D'Arc	
10438	10" Hack		10522	18" Bois D'Arc		10613	12" Cedar		10674	14" Hack		10704	10" Bois D'Arc	
10439	12" Bois D'Arc		10525	20" Hack		10614	14" Cedar		10675	12" Hack		10705	10" Cedar	
10441	10" Bois D'Arc		10528	18" Bois D'Arc		10615	14" Cedar		10676	12" Hack		10706	10" Cedar	
10442	20" Elm		10530	18" Bois D'Arc		10180	18" Bois D'Arc		10678	12" Hack		10709	10" Bois D'Arc	
10444	12" Bois D'Arc		10531	18" Bois D'Arc		10616	10" Hack		10677	10" Bois D'Arc		10727	12" Cedar	
10445	12" Bois D'Arc		10538	18" Ash		10663	10" Hack		10678	12" Hack		10884	12" Hack	
			10546	18" Ash								10885	12" Hack	

RECORD DRAWING
THIS RECORD DRAWING HEREIN REFLECTS TO THE BEST OF THE DESIGN ENGINEER'S KNOWLEDGE THE APPROXIMATE LOCATION OF THE CONSTRUCTED WORK USING INFORMATION AS PROVIDED BY THE CONTRACTOR(S).

OWNER/DEVELOPER:
THE SHORES INVESTORS, LP
600 N. PEARL STREET #650
DALLAS, TEXAS 75201
PH. 214-880-8600

BENCHMARK:
BRASS DISK IN CONC. MONUMENT, IN MEDIAN OF NORTH LAKESHORE DRIVE 150' ± NORTH OF ALAMO DRIVE (CITY OF ROCKWALL MONUMENT # 10).

ELEV.: 524.62

STATE OF TEXAS
C. MICHAEL DANIEL
82457
REGISTERED PROFESSIONAL ENGINEER

revisions	date
REVISED	8-21-97
REVISED	APRIL 1999

NDM
NATHAN D. MAIER
CONSULTING ENGINEERS, INC.
Three Northpark / 8800 N. Central Expwy. / Suite 300
Dallas, Texas 75231 / (214) 739-4741

TREE SURVEY
CREEKSIDE
THE SHORES
CITY OF ROCKWALL
ROCKWALL COUNTY, TEXAS

design	drawn	scale	date	notes
TWA	TWA	1" = 50'	2-10.97	L-TRESUR

sheet no. 13 / 17

job number 95-05-036L