GRAPHIC SCALE

20 0 10 20 40 80

(IN FEET)
1 inch = 20 ft.
1"=4' VERT

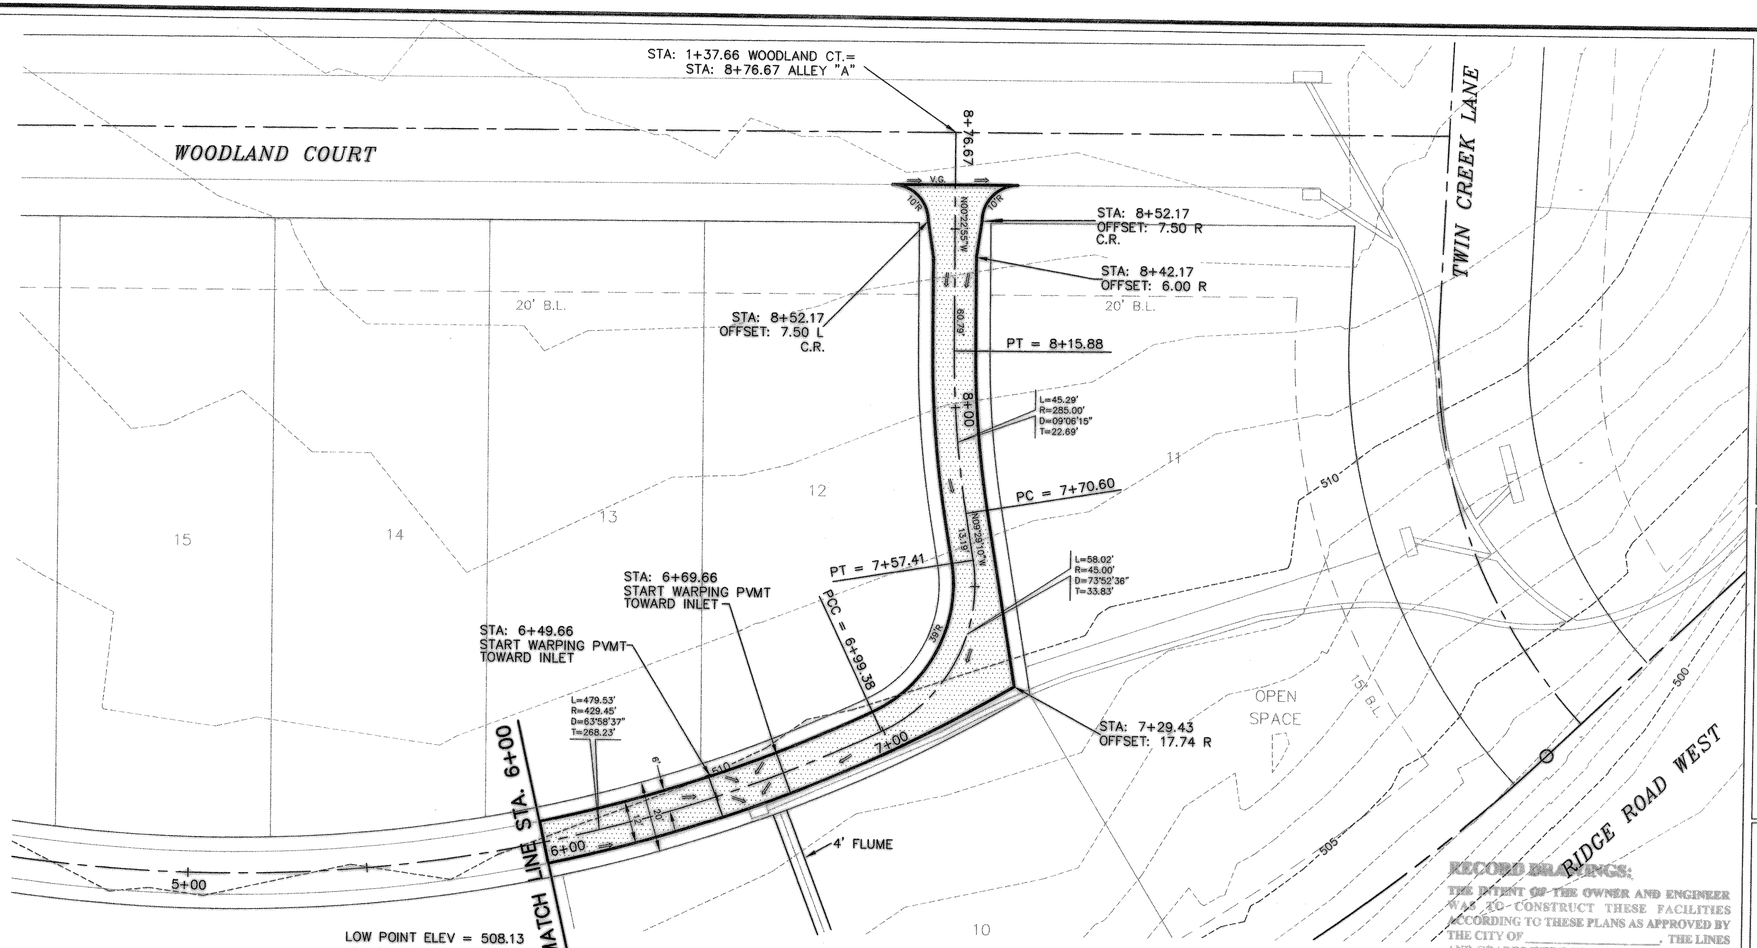

LOW POINT ELEV = 508.13
LOW POINT STA = 6+62.17
PVI STA = 7+00.11
PVI ELEV = 507.70
A.D. = 3.49
K = 40.12

ALLEY "A"

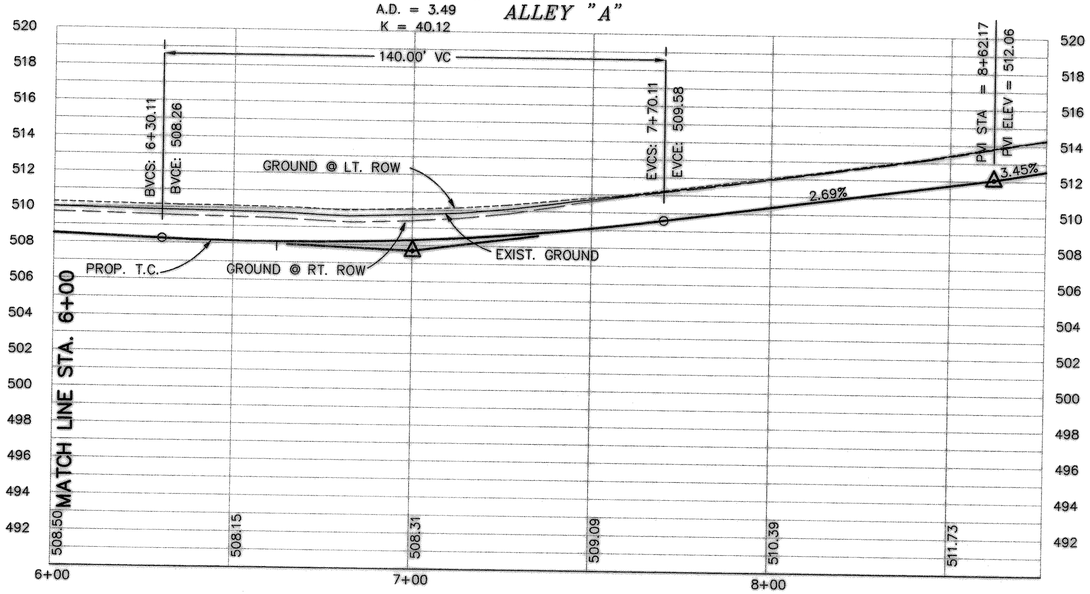

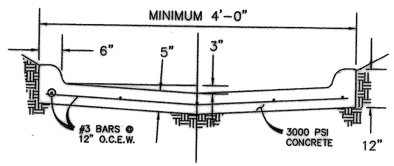

CURBED OVER FLOW FLUME

RECORD DRAWINGS:
THE INTENT OF THE OWNER AND ENGINEER WAS TO CONSTRUCT THESE FACILITIES ACCORDING TO THESE PLANS AS APPROVED BY THE CITY OF _____. THE LINES AND GRADES WERE SET ON THE GROUND FOR CONSTRUCTION ACCORDING TO SAID PLANS. THE CITY OF _____ INSPECTED THE CONSTRUCTION. THE OWNER NOR ENGINEER DID NOT VERIFY LINES OR GRADES AFTER CONSTRUCTION. WE ARE NOT AWARE OF ANY CHANGES OR REVISIONS TO THESE PLANS DURING CONSTRUCTION EXCEPT AS NOTED

THE SEAL APPEARING ON THIS DOCUMENT WAS AUTHORIZED BY WILL DOUPHRATE II TEXAS P.E. NO. 60102 ON 7/19/00

DOUPHRATE & ASSOCIATES, INC.
ENGINEERING + PROJECT MANAGEMENT + SURVEYING
2231 RIDGE RD., # 200 ROCKWALL, TEXAS 75087
PHONE: (972)771-9004 FAX: (972)771-9005

PAVING PLAN & PROFILE
ALLEY 'A'
CREEKSIDE VILLAGE, PHASE II
CITY OF ROCKWALL, ROCKWALL COUNTY, TEXAS

REVISION	
W.L.D.	CHECKED
A.L.W.	DRAWN
3/15/00	DATE
9960 PV6	PROJECT
11 OF 21	