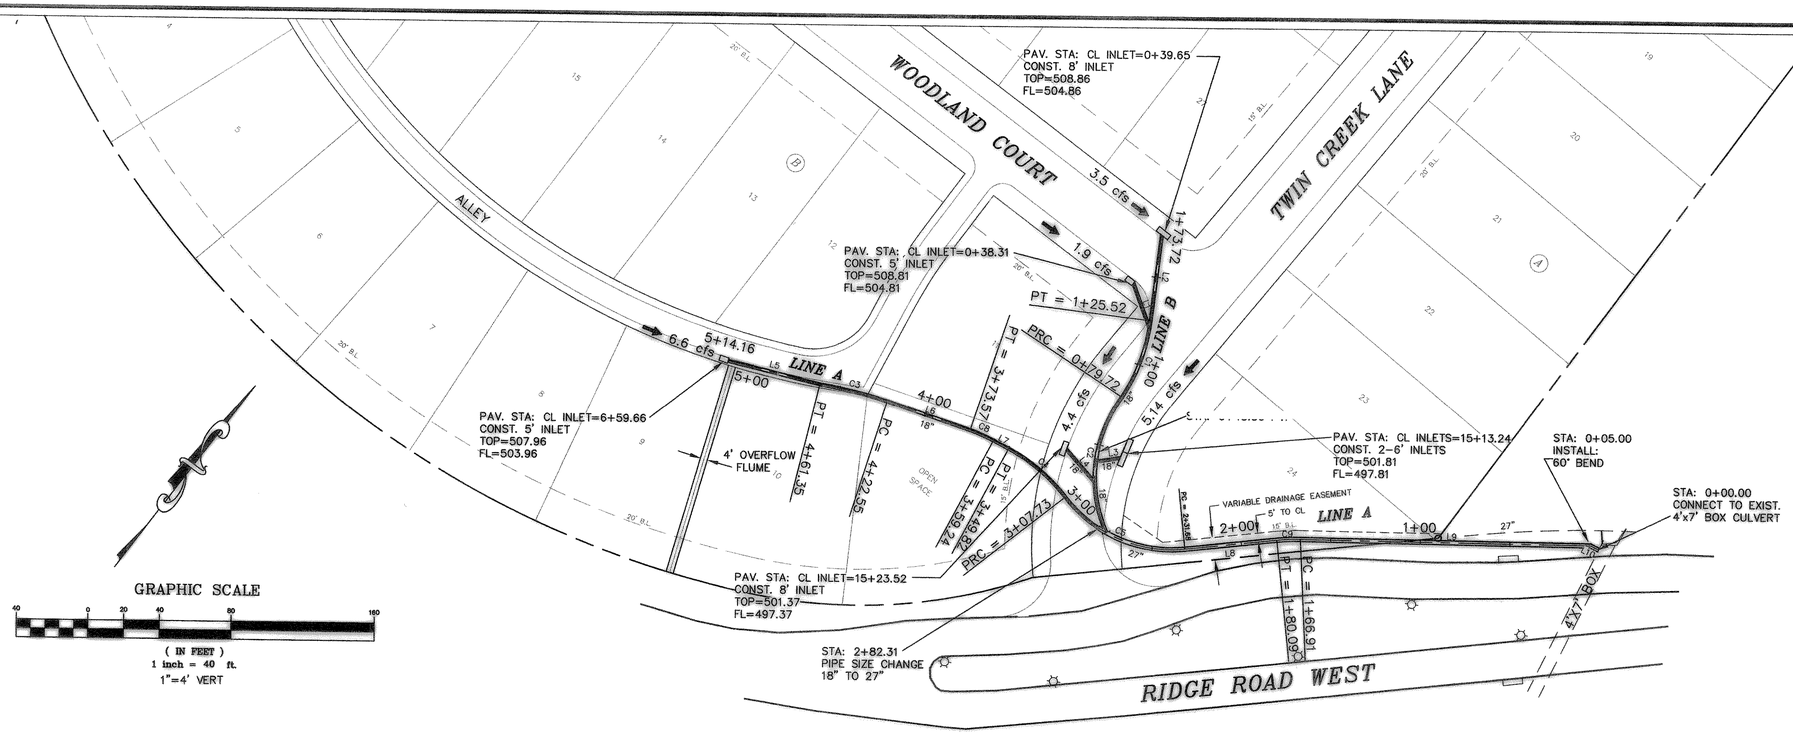

LINE TABLE		
LINE	LENGTH	BEARING
L1	26.46'	S57°43'35"E
L2	48.20'	S30°22'55"E
L3	13.75'	S43°39'36"W
L4	24.21'	S78°38'05"E
L5	52.81'	N66°25'02"E
L6	48.98'	N71°07'52"E
L7	9.43'	N80°30'41"E
L8	51.59'	S46°31'37"W
L9	161.91'	N52°18'52"E
L10	5.00'	S78°48'54"W

CURVE TABLE						
CURVE	LENGTH	RADIUS	TANGENT	CH BRG	CH DIST	DELTA
C1	45.80	100.06	23.31	N17°15'38"W	45.40	26°13'38"
C2	79.72	75.00	44.09	S31°15'48"E	76.02	60°53'53"
C3	38.80	267.37	19.43	S66°06'32"W	38.76	08°18'50"
C4	42.09	100.00	21.36	N87°25'54"W	41.78	24°06'50"
C5	76.05	75.00	41.66	N75°34'34"E	72.83	58°05'54"
C6	14.33	100.00	7.18	S76°24'24"W	14.32	08°12'33"
C7	13.18	100.00	6.60	S50°18'11"W	13.17	07°33'08"

LINE A

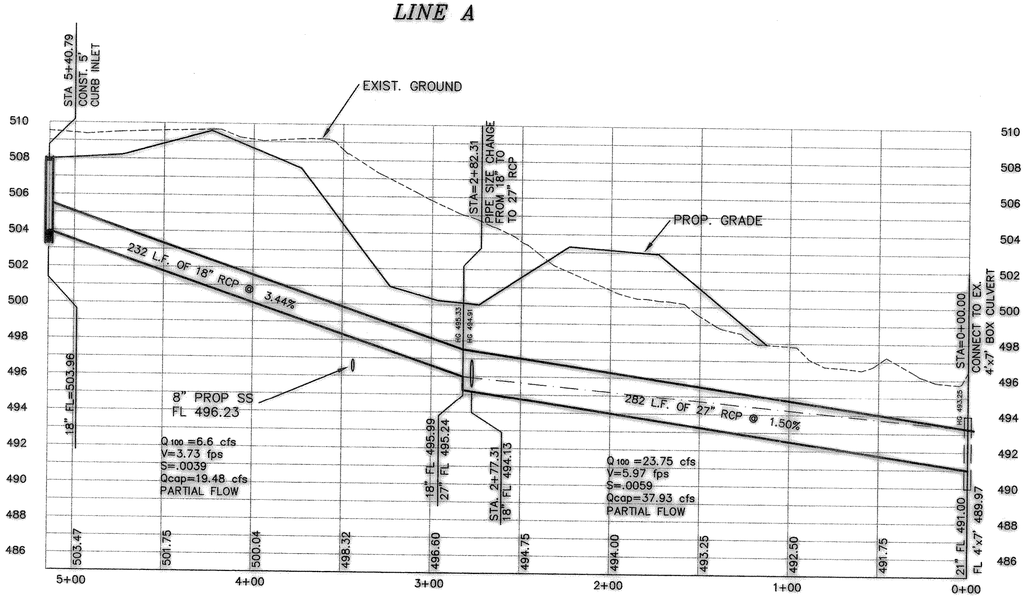

LINE B

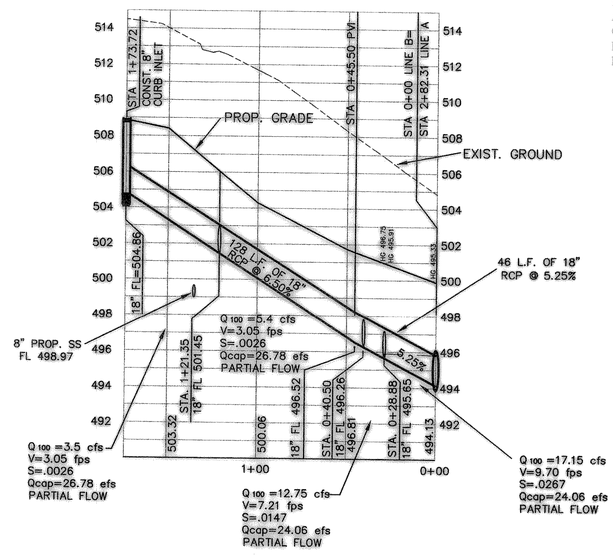

RECORD DRAWINGS:

THE INTENT OF THE OWNER AND ENGINEER WAS TO CONSTRUCT THESE FACILITIES ACCORDING TO THESE PLANS AS APPROVED BY THE CITY OF _____. LINES AND GRADES WERE SET ON THE GROUND FOR CONSTRUCTION ACCORDING TO SAID PLANS. THE CITY OF _____ INSPECTED THE CONSTRUCTION. THE OWNER AND ENGINEER DID NOT VERIFY LINES OR GRADES AFTER CONSTRUCTION. WE ARE NOT AWARE OF ANY CHANGES OR REVISIONS TO THESE PLANS DURING CONSTRUCTION EXCEPT AS NOTED

THE SEAL APPEARING ON THIS DOCUMENT WAS AUTHORIZED BY W.L. DOUPHRATE II TEXAS P.E. NO. 60102 ON 6/29/00

DOUPHRATE & ASSOCIATES, INC.
ENGINEERING • PROJECT MANAGEMENT • SURVEYING
2231 RIDGE RD., # 200 ROCKWALL, TEXAS 75087
PHONE: (972)771-9004 FAX: (972)771-9005

STORM SEWER PLAN & PROFILES
LINES A & B
CREEKSIDE VILLAGE, PHASE II
CITY OF ROCKWALL, ROCKWALL COUNTY, TEXAS

REVISION	
W.L.D.	CHECKED
K.E.B.	DRAWN
3/29/00	DATE
9960 STM1	PROJECT
16 OF 21	