NOTE:
INSTALL PAVEMENT MARKERS TYPE II-A-A. AS PER DETAIL SHOWN ON THIS SHEET
1. AT THE CENTER OF FM 1141 FROM STA. 0+17.51 TO STA 29+59.09
2. ON THE STRIPES

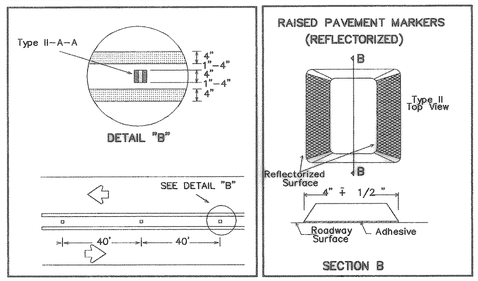

PAVEMENT MARKER DETAIL
N.T.S.

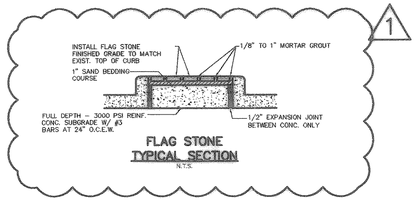

FLAG STONE
TYPICAL SECTION
N.T.S.

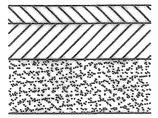

2" TYPE "D" FINE GRADED SURFACE COURSE
ITEM 334 PER TXDOT 1993 SPECIFICATIONS

4" TYPE "A" COURSE GRADED BASE COURSE
ITEM 334 PER TXDOT 1993 SPECIFICATIONS

6" LIME STABILIZED SUBGRADE
TO BE EXTENDED 2 FT. BEYOND EDGE OF PVMT.

ASPHALT PAVEMENT SECTION
(CONNECTION TO F.M. 1141 & F.M. 552)

Typical TWLTL Transition
at Two-Way Cross Street

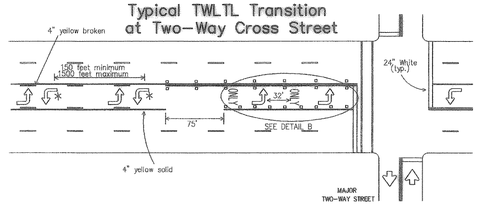

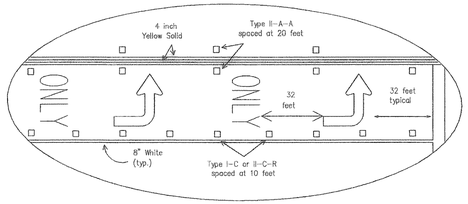

DETAIL B

BENCHMARK 1 USGS Monument-stamped Boren 1986
Located approximately 1.25 miles east of Rockwall at the Rockwall Municipal Airport, in the north end of a circular grass area at the end of a taxiway.
ELEVATION = 574.77

BENCHMARK 2 USGS Monument-5" cap stamped N 1495/1986
Located 24.6 feet west of the center of a paved road leading to the Rockwall Municipal Airport, 16.4 feet south of a utility pole with a transformer and light, 2 feet west of the north leg of a sign. Access to datum point is through a 5 inch logo cap.
ELEVATION = 567.44

AS BUILT
To the best of our knowledge "Winkelmann and Associates, Inc." hereby states that this plan is "As-Built". The information is based on surveying conducted at the site and modification information provided by "the Contractor".

WINKELMANN & ASSOCIATES, INC. DATE 9/25/07

NO.	DATE	REVISION	APPROV.
4	08/01/07	REVISED CONCRETE BRICK PAVERS	N.K.

Winkelmann & Associates, Inc.
CONSULTING CIVIL ENGINEERS ▪ SURVEYORS
8750 HILLCREST PLAZA DRIVE, SUITE 100
DALLAS, TEXAS 75225
(972) 485-7880
(972) 485-7899 FAX

STATE OF TEXAS · NAIM UDDIN KHAN · 87776 · REGISTERED PROFESSIONAL ENGINEER

THESE CONSTRUCTION PLANS WERE PREPARED UNDER THE RESPONSIBLE SUPERVISION OF MD. NAIM UDDIN KHAN, REGISTERED PROFESSIONAL ENGINEER NO. 87776 9/25/07

THE SEAL APPEARING ON THIS DOCUMENT WAS AUTHORIZED BY MD. NAIM UDDIN KHAN, P.E. #87776

JOHN M. GLASS SURVEY ABSTRACT No. 88
CITY OF ROCKWALL
ROCKWALL COUNTY, TEXAS

D R HORTON
4306 MILLER ROAD, SUITE A
ROWLETT, TEXAS 75088
214-607-4244

LEGEND

TC	TOP OF CURB
TP	TOP OF PAVEMENT
CR	CURB RETURN
FL	FLOW LINE
2 / 1	STREET STATION
	HANDICAP RAMP @ STREET & STREET INTERSECTION
	HANDICAP RAMP @ STREET & ALLEY INTERSECTION
	FLOW ARROWS
	Existing Concrete Pavement
	ASPHALT PAVING
	EXTENDED ASPH. AREA
PP	Power Pole
MH	Manhole
WV	Water Valve
TP	Telephone Pedestal
WM	Water Meter
FH	Fire Hydrant
LP	Light Pole
CO	Clean Out
AC	Air Conditioner
TV	Cable Box
SB	Signal Box
SP	Signal Pole
SN	Sign
SS	Sanitary Sewer
W	Water Line
OH	Overhead Power Lines
EBOX	Electrical Box
TXU	Texas Utilities
SWB	South Western Bell
GAS	Gas Line
RCP	Reinforced Concrete Pipe
TSN	Traffic Signs
WMH	Water Manhole
TMK	Telephone Marker
WMK	Water Marker
GMK	Gas Marker

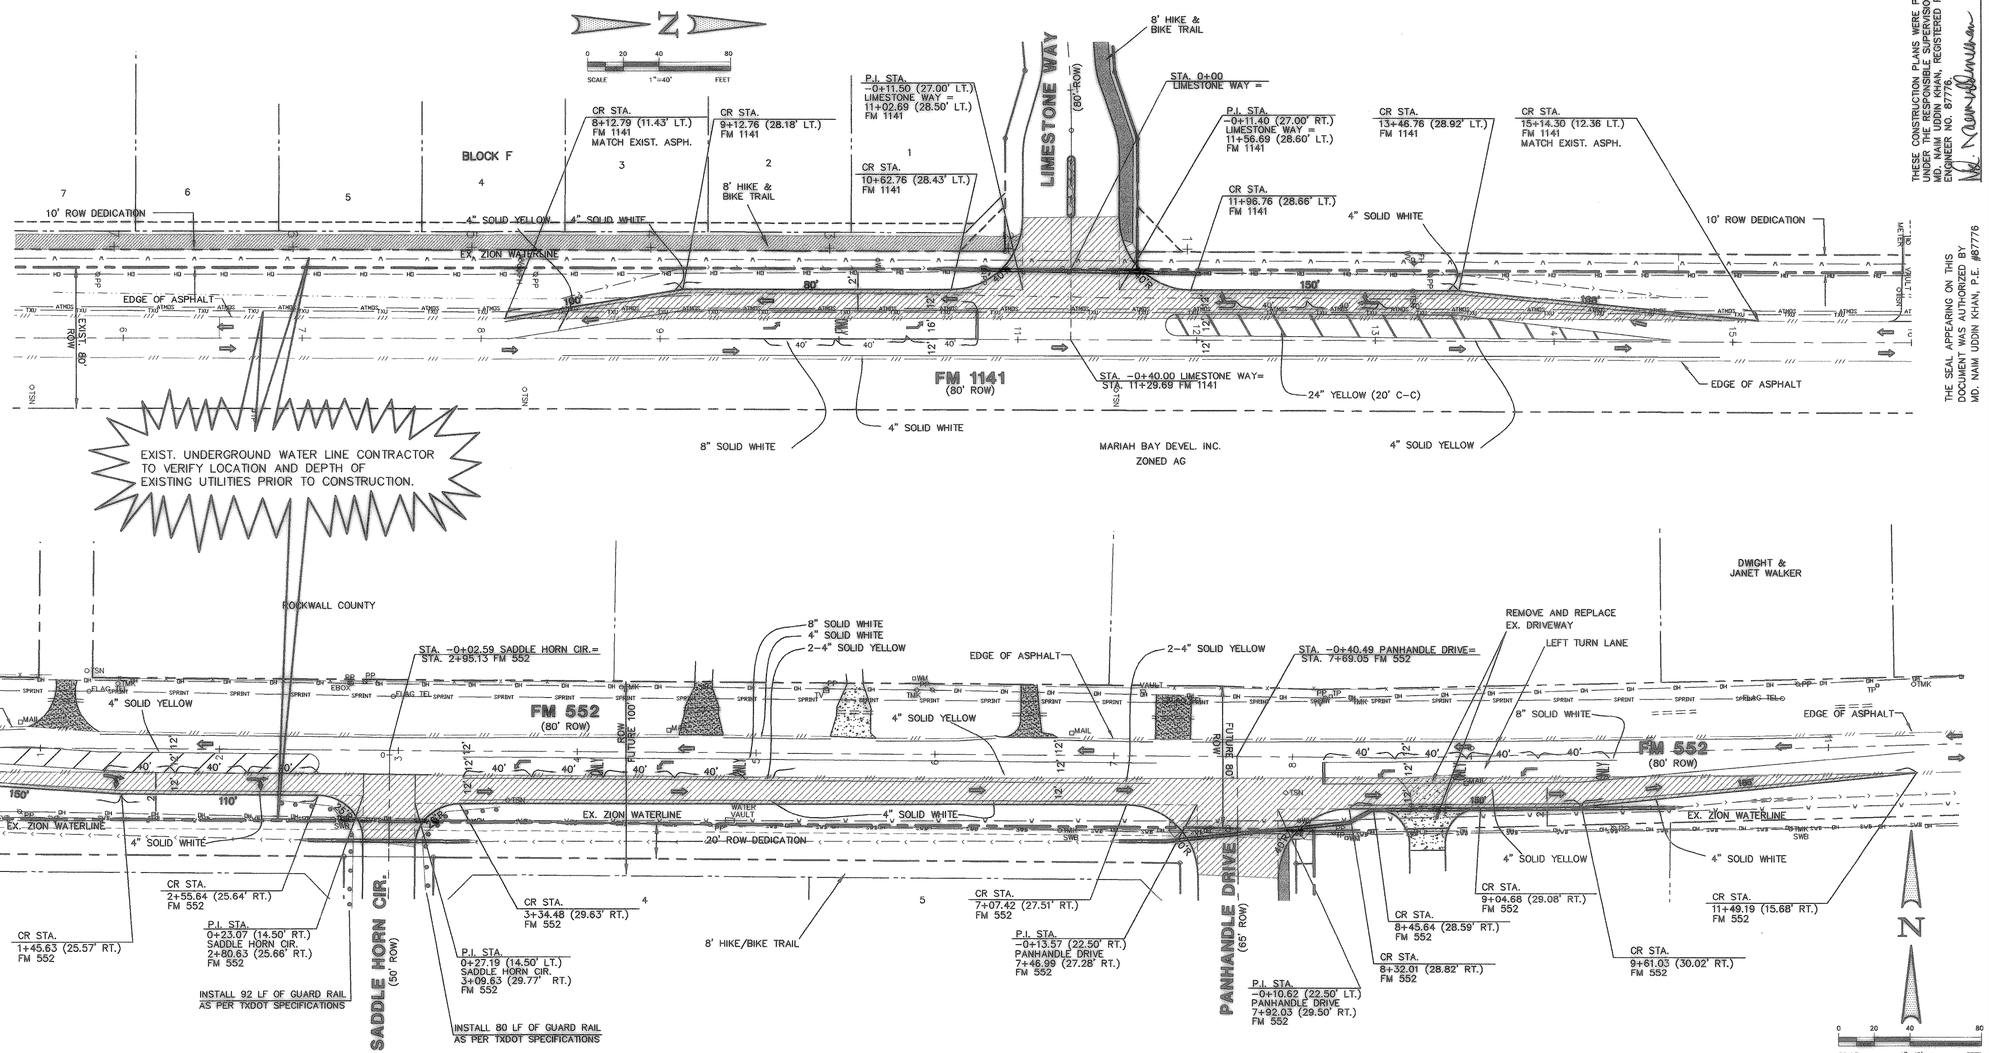

PAVING & STRIPING PLAN
FM 1141 & FM 552

Scale : 1"=40'
Date : 08/25/06
Designed By : IT
Drawn By : IT
Checked By : NK
File : 40709PAV.DWG
View : P14
Project No. : 40709.00

SHEET 16 OF 45

G:\40709\Design\40709sl.dwg 8/25/2007 11:49:17 AM, 8HASL