NOTES:

KEYED NOTES DESIGNATED BY: (3)

1. REFER TO SHEET 8 FOR OFFSITE DRAINAGE.
2. NOTE ALL OFF-SITE DRAINAGE REFERENCED IN APARTMENT ENGINEERING WAS ACCOMMODATED IN FORD DEALERSHIP DESIGN.

(3) SAW TOOTH CURB.

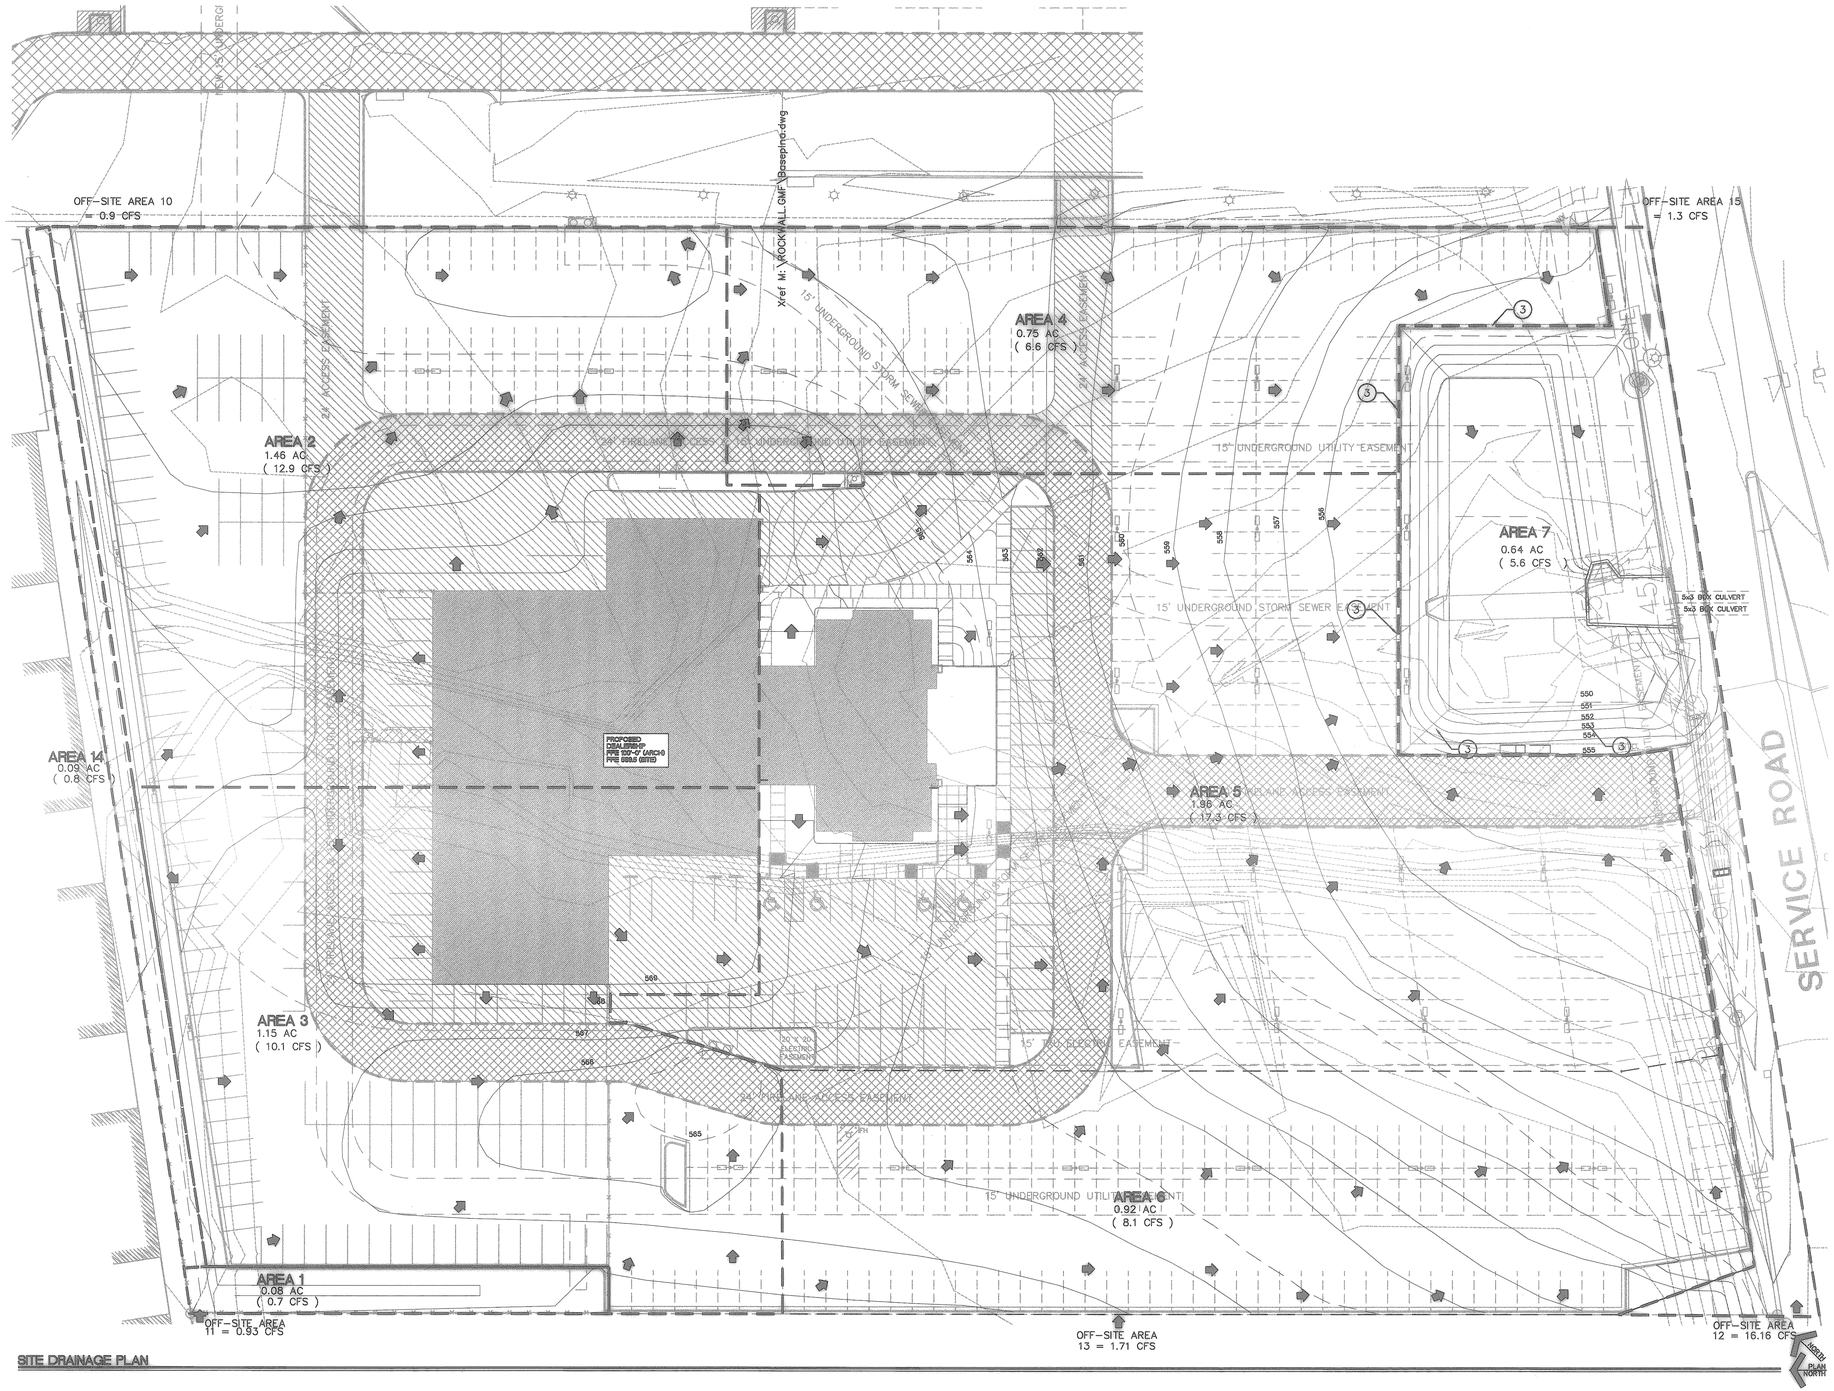

SITE DRAINAGE PLAN

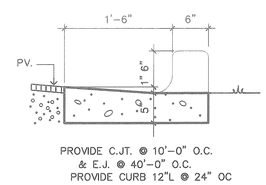

PROVIDE C.JT. @ 10'-0" O.C.
& E.J. @ 40'-0" O.C.
PROVIDE CURB 12"L @ 24" OC

TYPICAL SAWTOOTH CURB

3 SECTION

SCALE: 1" = 1'-0"

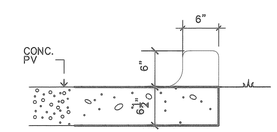

PROVIDE C.JT. @ 10'-0" O.C.
& E.J. @ 40'-0" O.C.
PROVIDE CURB 12"L @ 24" OC

TYPICAL SAWTOOTH CURB

4 SECTION

SCALE: 1" = 1'-0"

0 15' 30' 60'

SCALE: 1"=30'-0"

RECORD DOCUMENTS

STATE OF TEXAS
S.P. DAUGHTRY
60172
REGISTERED
PROFESSIONAL ENGINEER
12-17-01

ALLIED ASSOCIATES CONSULTING ENGINEERS
STRUCTURAL • MECHANICAL • ELECTRICAL
2525 74th ST., LUBBOCK, TX 79423 (806) 745-1103

Architectural Resources
2525 74TH ST., SUITE 200
(806) 745-1103
LUBBOCK, TX 79423
BBS/FAX (806) 745-1225

PROPOSED
DODGE
CAR DEALERSHIP
ROCKWALL TEXAS

[redacted]

PROJECT NO.	P99-
DATE :	03/13/00
REVISIONS :	
DATE :	11/08/00
RECORD DOCUMENTS	12/17/01

SHEET NO.
6