Area = 33.75 Sq. Ft.
Wp = 21.33
R = 2.05
V = 1.486/0.030 (2.05)^⅔(0.008)^½ = 7.15
C = 7.15 (33.75) = 241

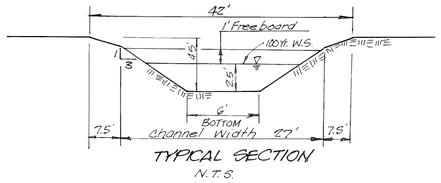

TYPICAL SECTION
N.T.S.

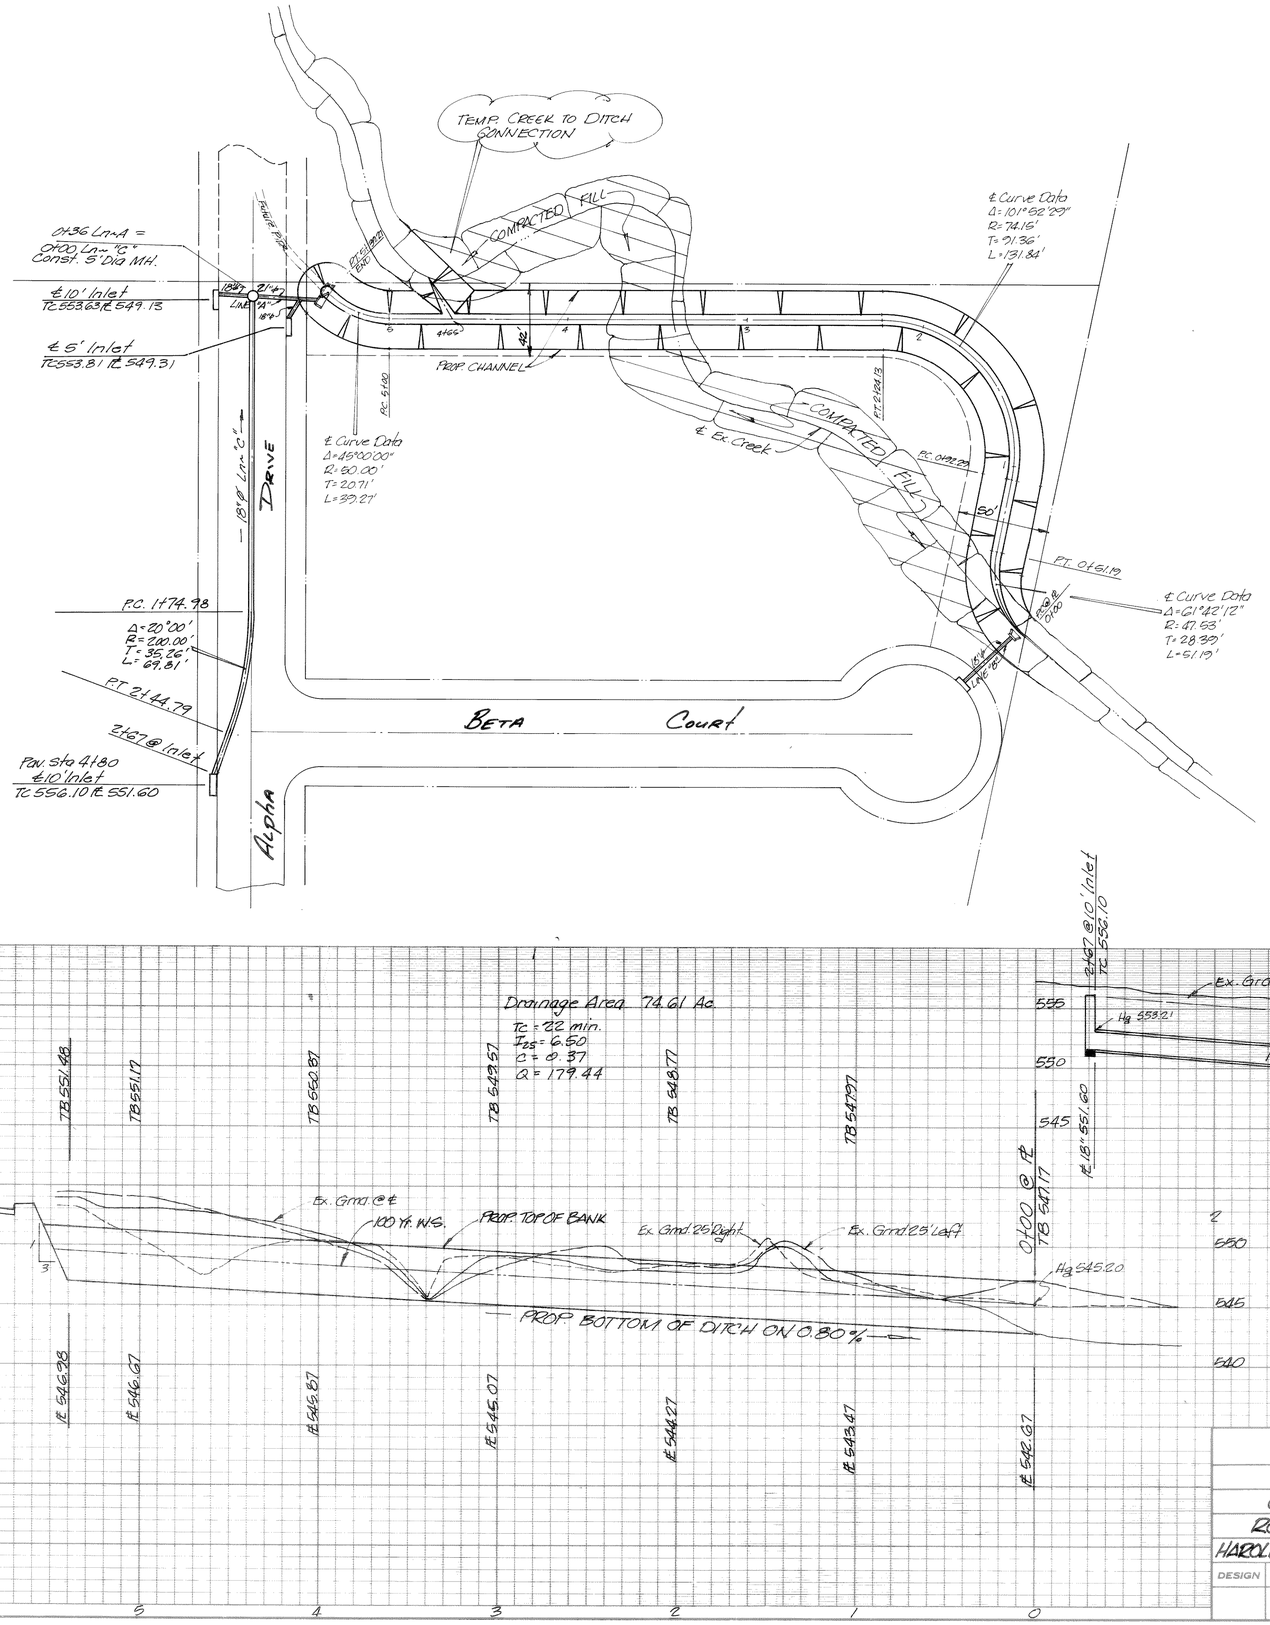

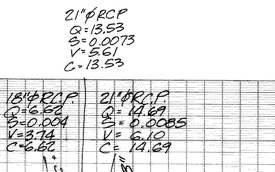

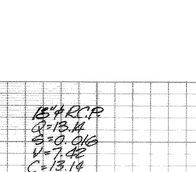

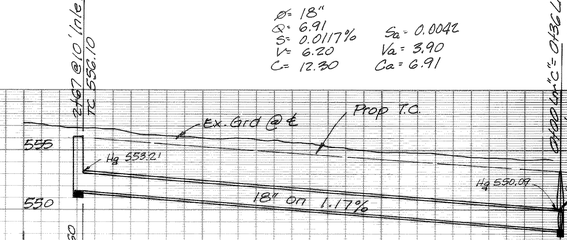

AS BUILT

4/6

DRAINAGE PLAN
ELLIS CENTRE
CITY OF ROCKWALL
ROCKWALL COUNTY, TEXAS
HAROLD L. EVANS & CONSULTING ENGINEER

DESIGN	DRAWN	DATE	SCALE	NOTES	FILE	JOB NO.
	TKA	1-10-84	1"=40' H. 1"=6' V.			83204

Rev. 2-29-84

D/S