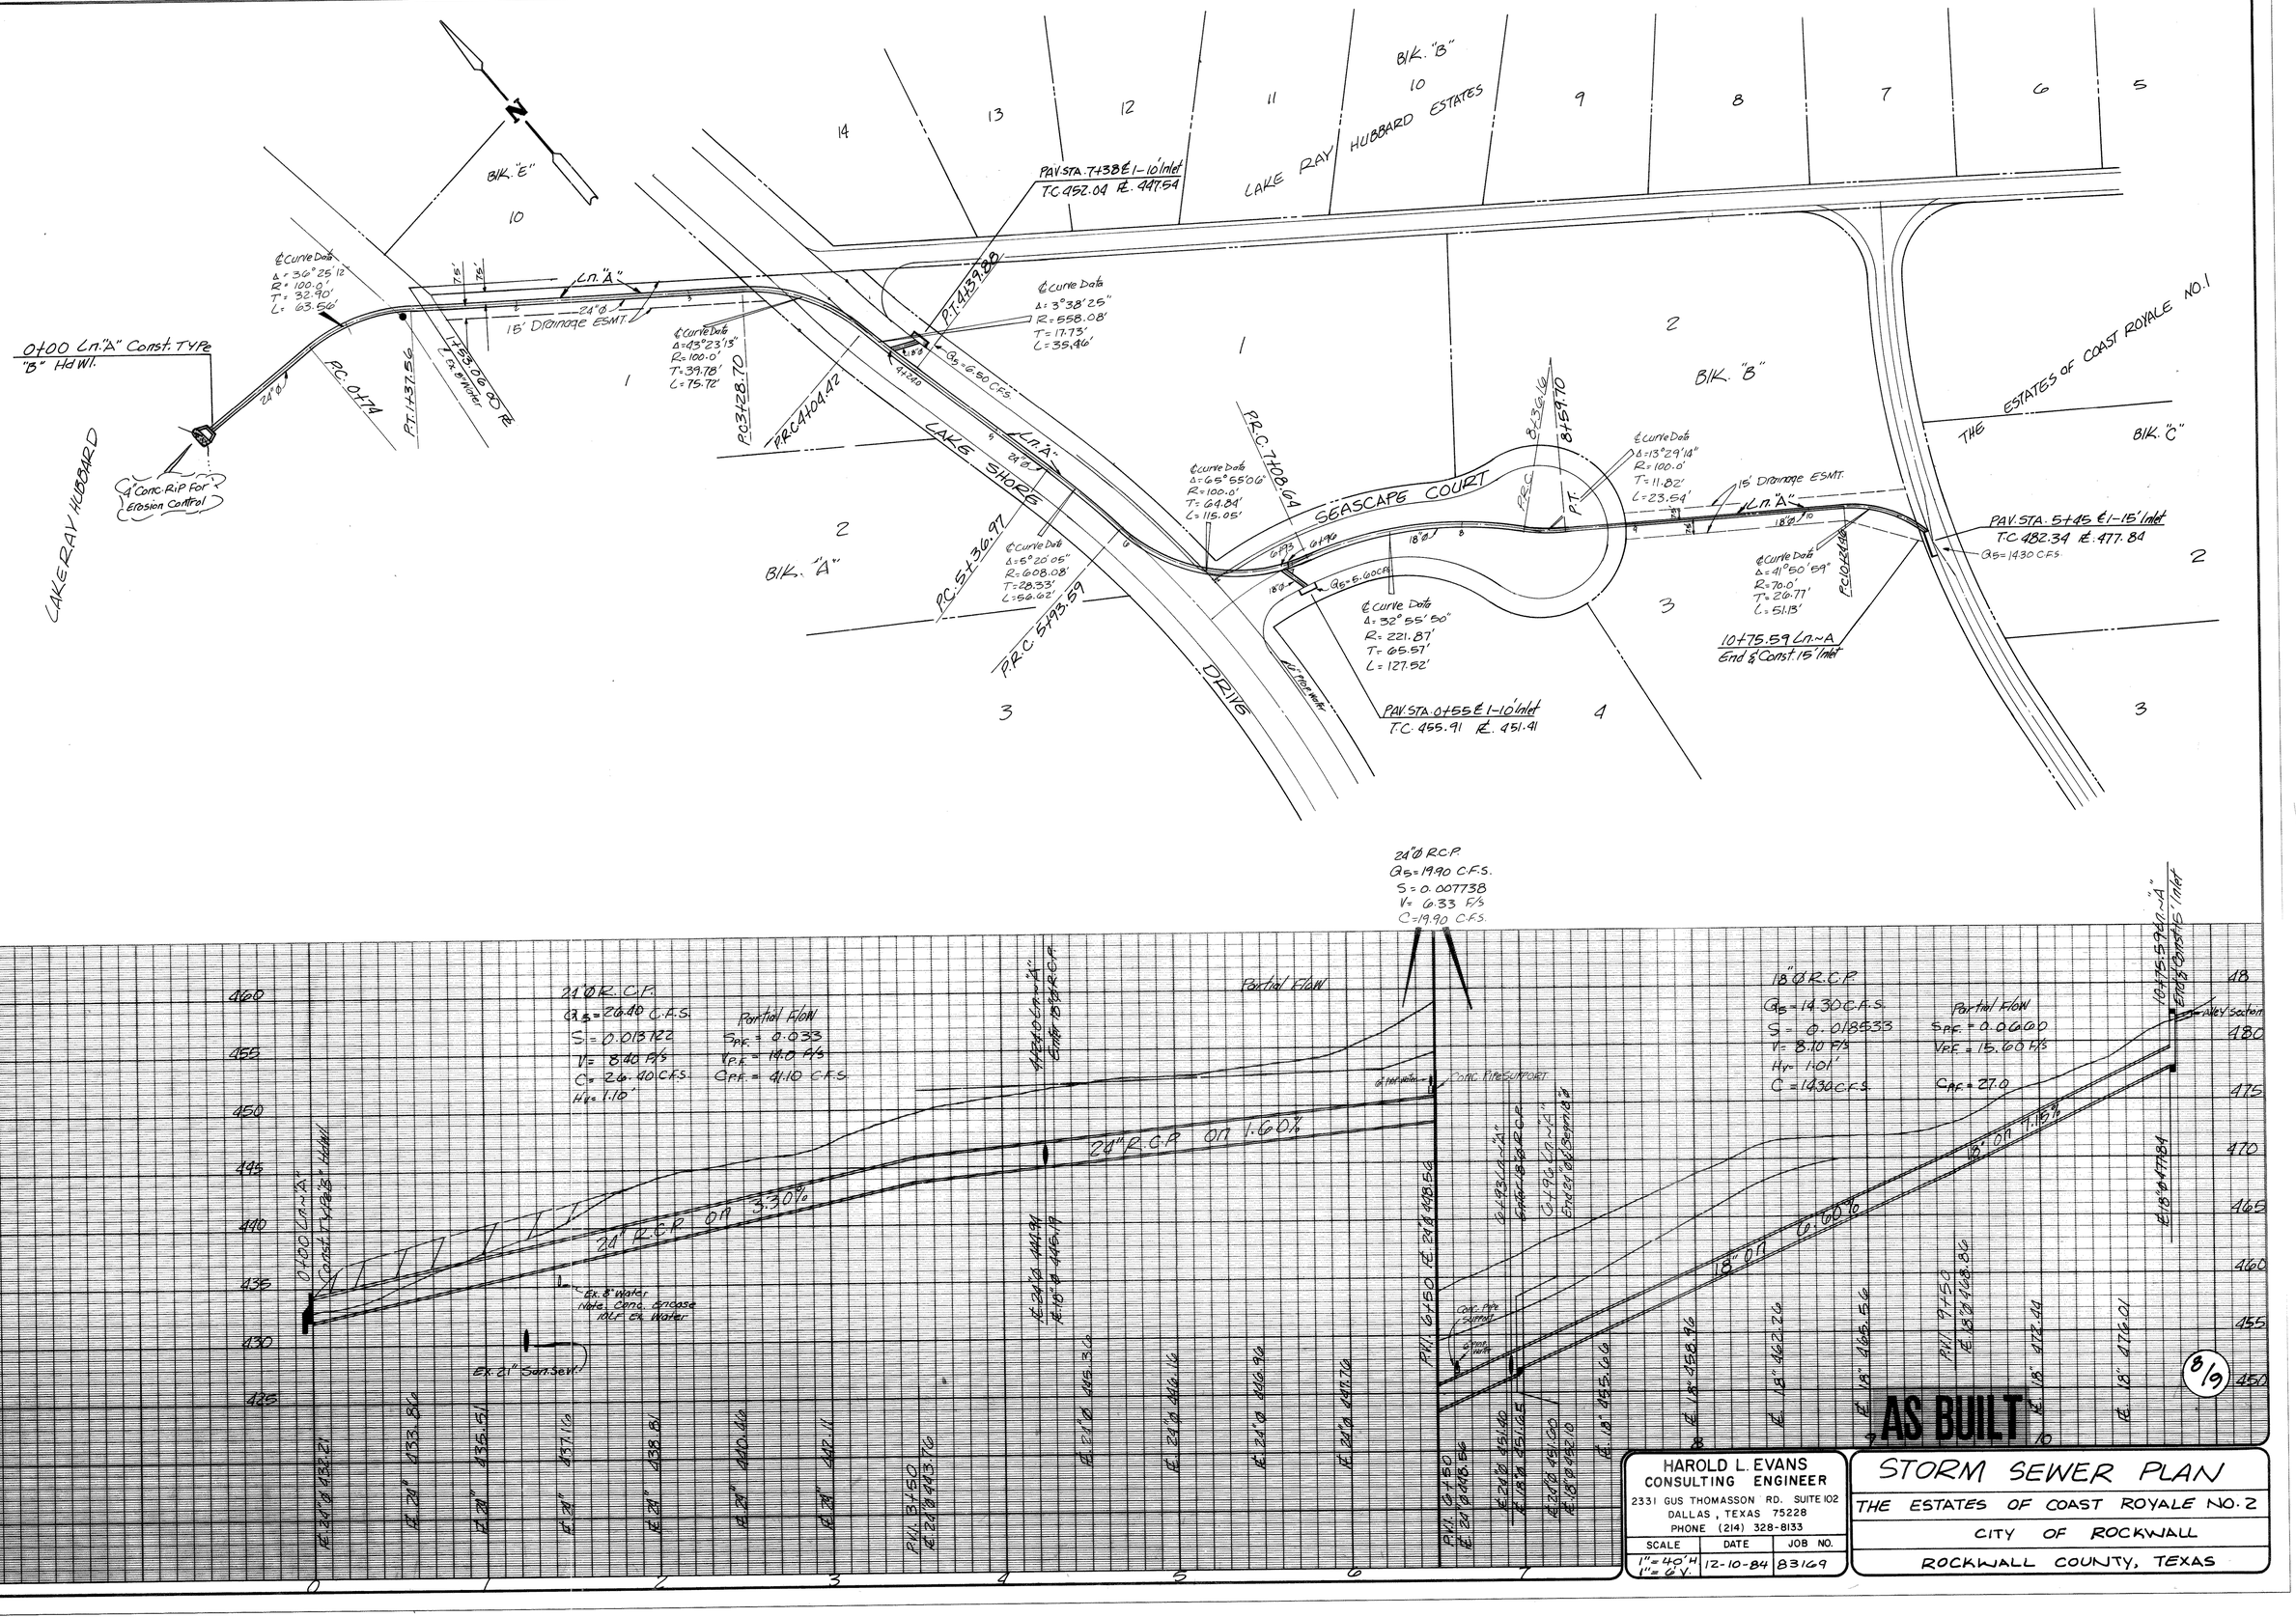

24"Ø R.C.P. Q6 = 19.90 C.F.S. S = 0.007738 V = 6.33 F/S C = 19.90 C.F.S.
21"Ø R.C.P. Q6 = 26.40 C.F.S. S = 0.013122 V = 8.40 F/S C = 26.40 C.F.S. Hv = 1.16'
Partial FLOW Spf. = 0.033 Vpf. = 14.0 F/S Qpf. = 41.10 C.F.S.
18"Ø R.C.P. Q6 = 14.30 C.F.S. S = 0.018533 V = 8.10 F/S Hv = 1.01' C = 14.30 C.F.S.
Partial FLOW Spf. = 0.00600 Vpf. = 15.60 F/S Qpf. = 27.0
21" R.C.P. on 3.30%
24" R.C.P. on 1.60%
18" on 6.60%
18" on 1.10%
Ex. 8" Water Note: Conc. Encase 10LF ex. Water
Ex. 21" San. Sew.
Conc. Pipe Support
Ex. 8" Water
Alley Section
Ln."A" Const. TYPE "B" Hd Wl.
