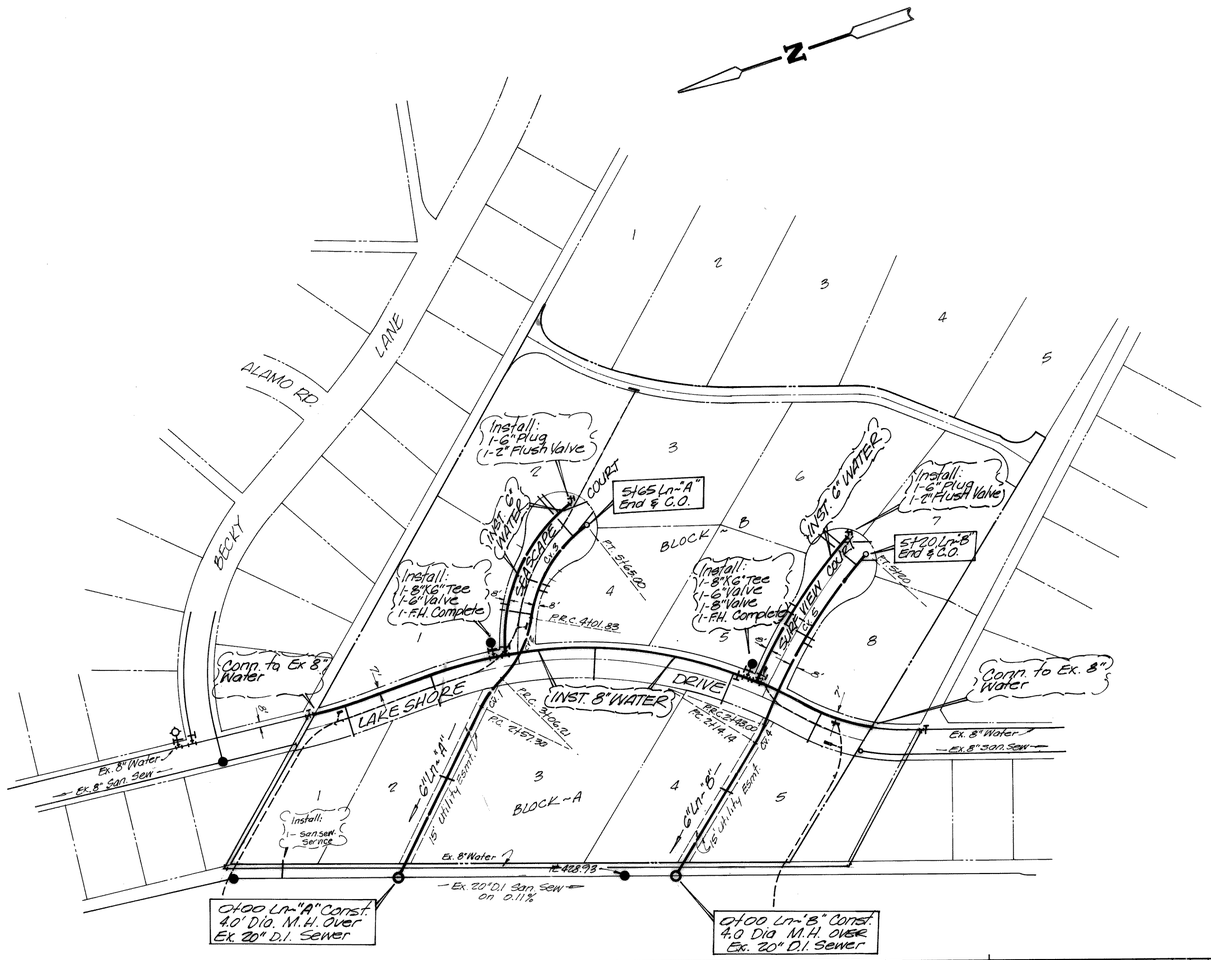

SANITARY SEWER CURVE DATA

1 Δ = 15°40'58"
R = 150.00'
T = 24.67'
L = 48.91'

2 Δ = 36°31'33"
R = 150.00'
T = 49.50'
L = 95.62'

3 Δ = 45°38'00"
R = 204.87'
T = 86.19'
L = 163.17

4 Δ = 11°01'30"
R = 150.00'
T = 14.48'
L = 28.86'

5 Δ = 20°59'13"
R = 756.23'
T = 140.07'
L = 277.00'

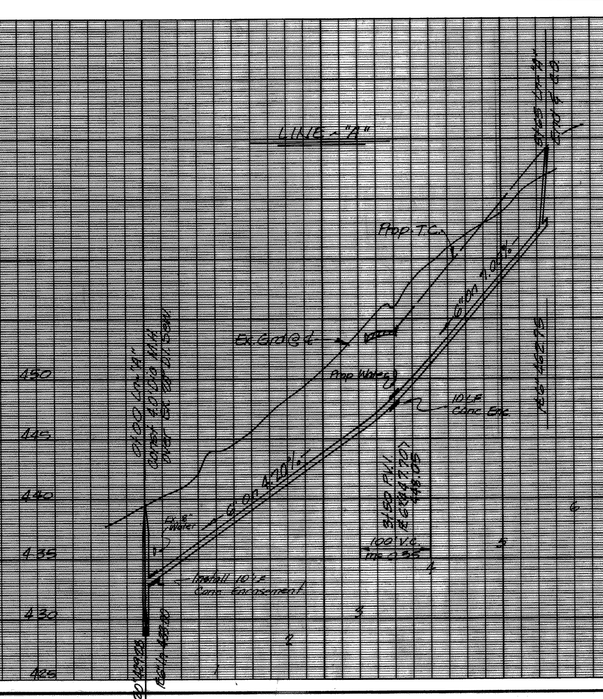

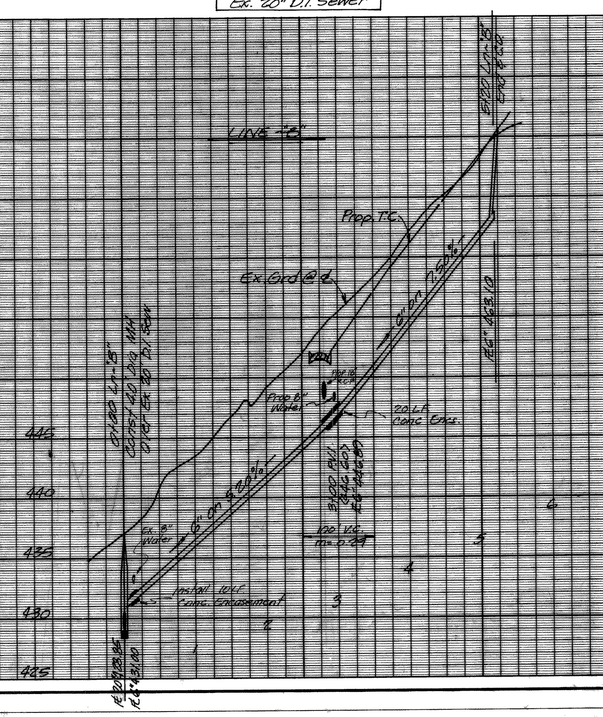

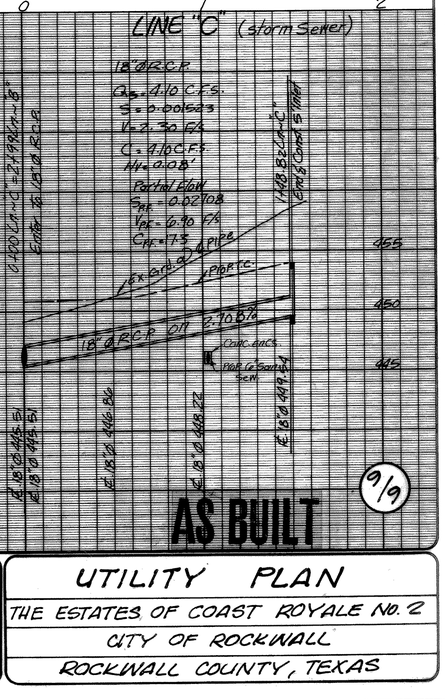

AS BUILT

9/9

HAROLD L. EVANS
CONSULTING ENGINEER
2331 GUS THOMASSON RD. SUITE 102
DALLAS, TEXAS 75228
PHONE (214) 328-8133

SCALE	DATE	JOB NO.
1"=100' H. 1"=6' V.	12-7-84	83169

UTILITY PLAN

THE ESTATES OF COAST ROYALE NO. 2

CITY OF ROCKWALL

ROCKWALL COUNTY, TEXAS