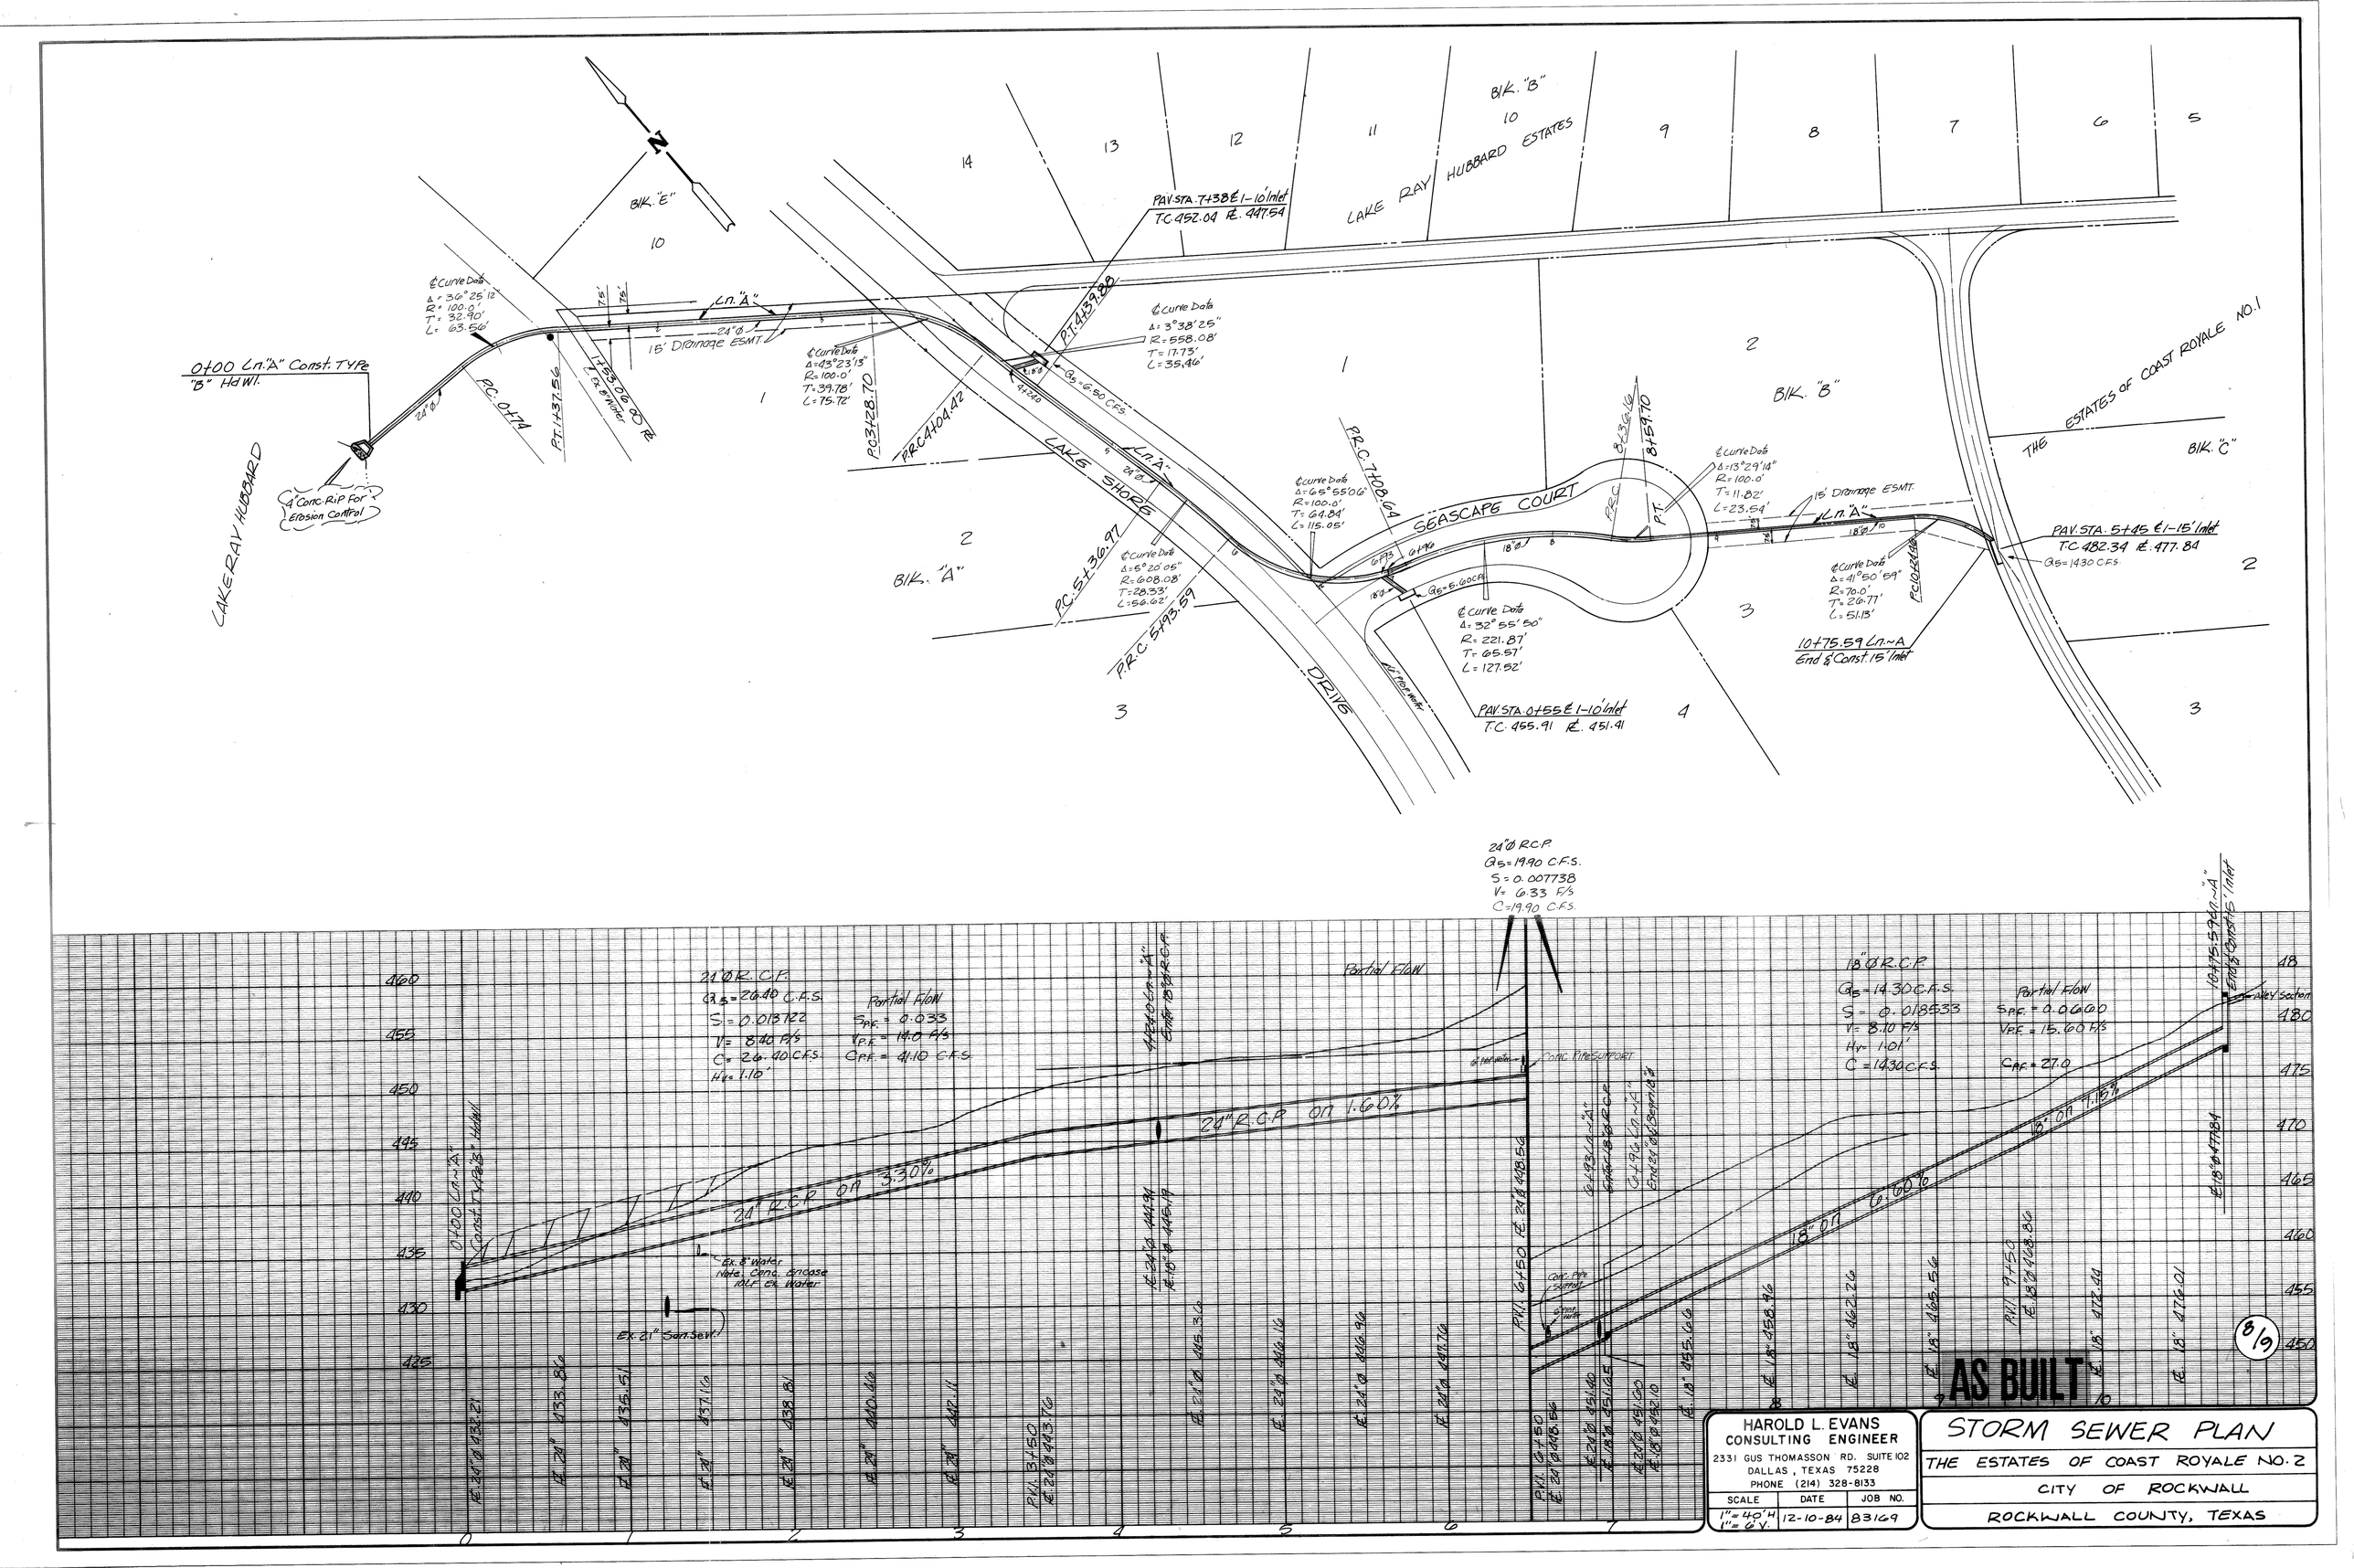

HAROLD L. EVANS CONSULTING ENGINEER		
2331 GUS THOMASSON RD. SUITE 102 DALLAS, TEXAS 75228 PHONE (214) 328-8133		
SCALE	DATE	JOB NO.
1"=40'H 1"=8'V.	12-10-84	83169

STORM SEWER PLAN

THE ESTATES OF COAST ROYALE NO. 2

CITY OF ROCKWALL

ROCKWALL COUNTY, TEXAS