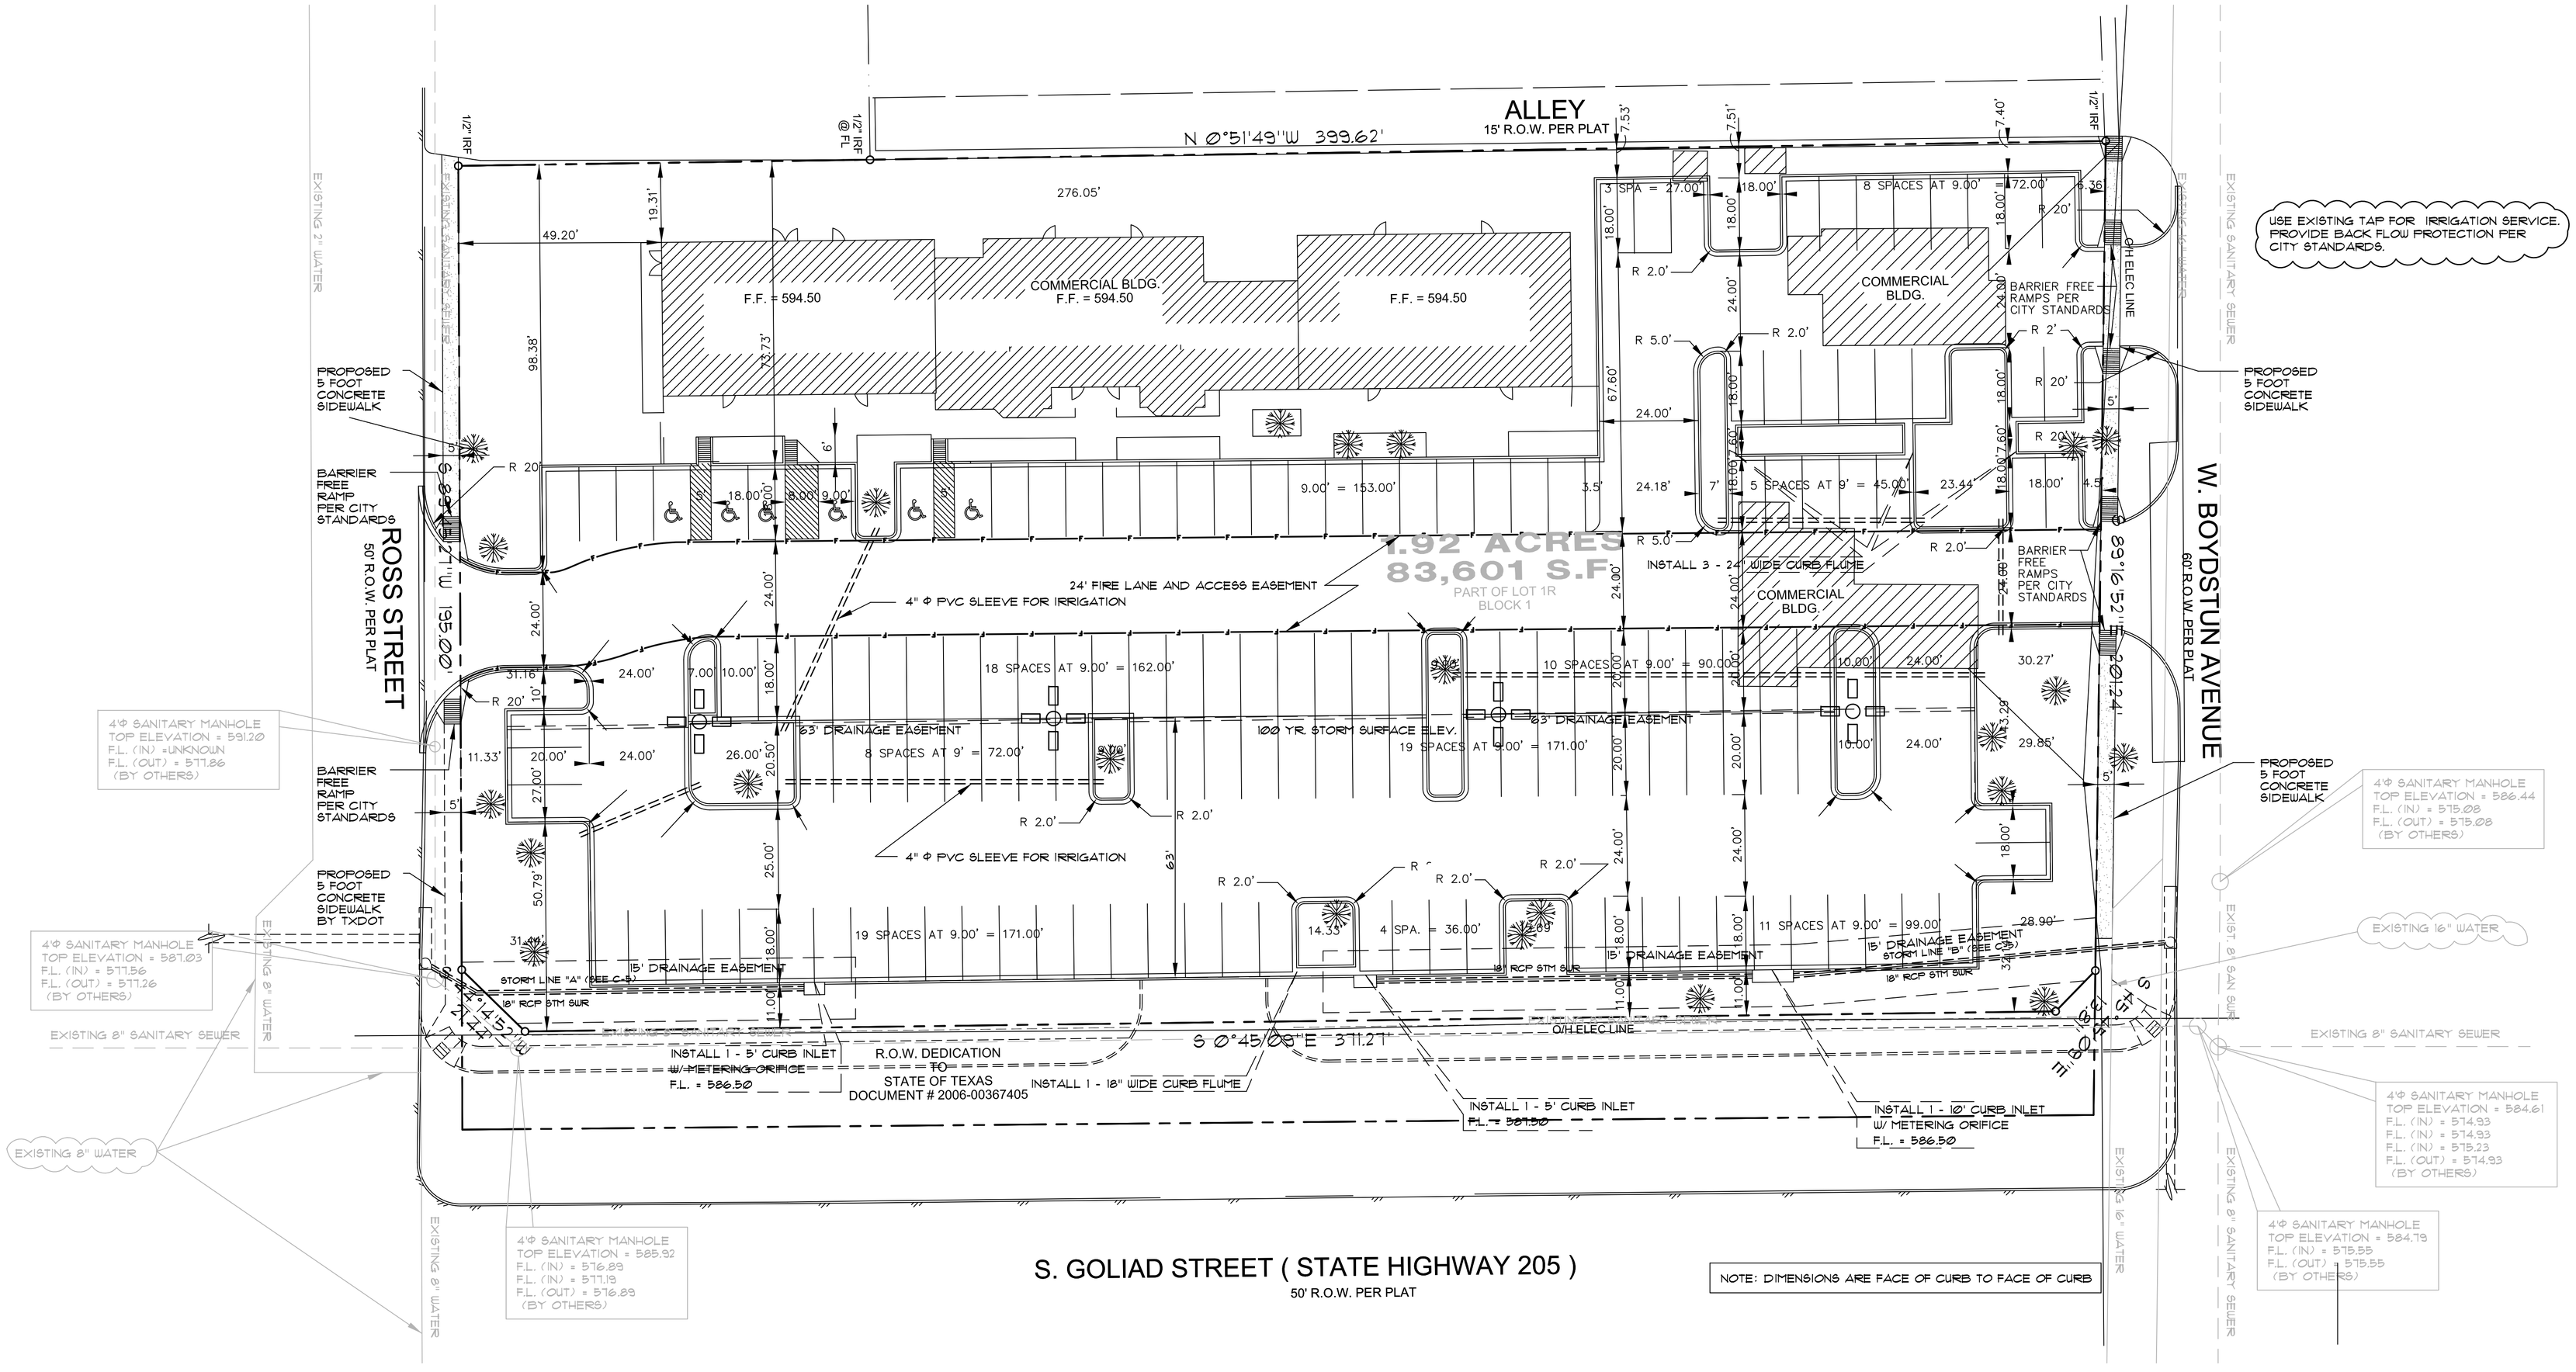


N

SCALE 1"= 20'

0 20 40 60 80 100

RECORD DRAWINGS
FEBRUARY 10, 2010

STATE OF TEXAS
JOSEPH T. PITT
33944
REGISTERED PROFESSIONAL ENGINEER
08/28/08

TMBP
CONSULTING ENGINEERS INC.
2301 NORTH AKARD ST. SUITE 405
DALLAS, TEXAS 75201
(214) 871-2302 (214) 871-8716 FAX

| REV. NO. | TYPE OF WORK | ENG. | DATE | CITY OF ROCKWALL | DATE |
|---|---|---|---|---|---|
| | | | | | |

# DIMENSION CONTROL PLAN

## 2008 PARKING ADDITION

## FIRST BAPTIST CHURCH – ROCKWALL, TX

## PUBLIC WORKS DEPARTMENT

## CITY OF ROCKWALL, TEXAS

| DESIGN | DRAWN | DATE | SCALE | NOTES | FILE | NO. |
|---|---|---|---|---|---|---|
| J. PITT | R.MITCH | AUG 28 2008 | | | | C-1 |

FIRST BAPTIST CHURCH PARKING ADDITION