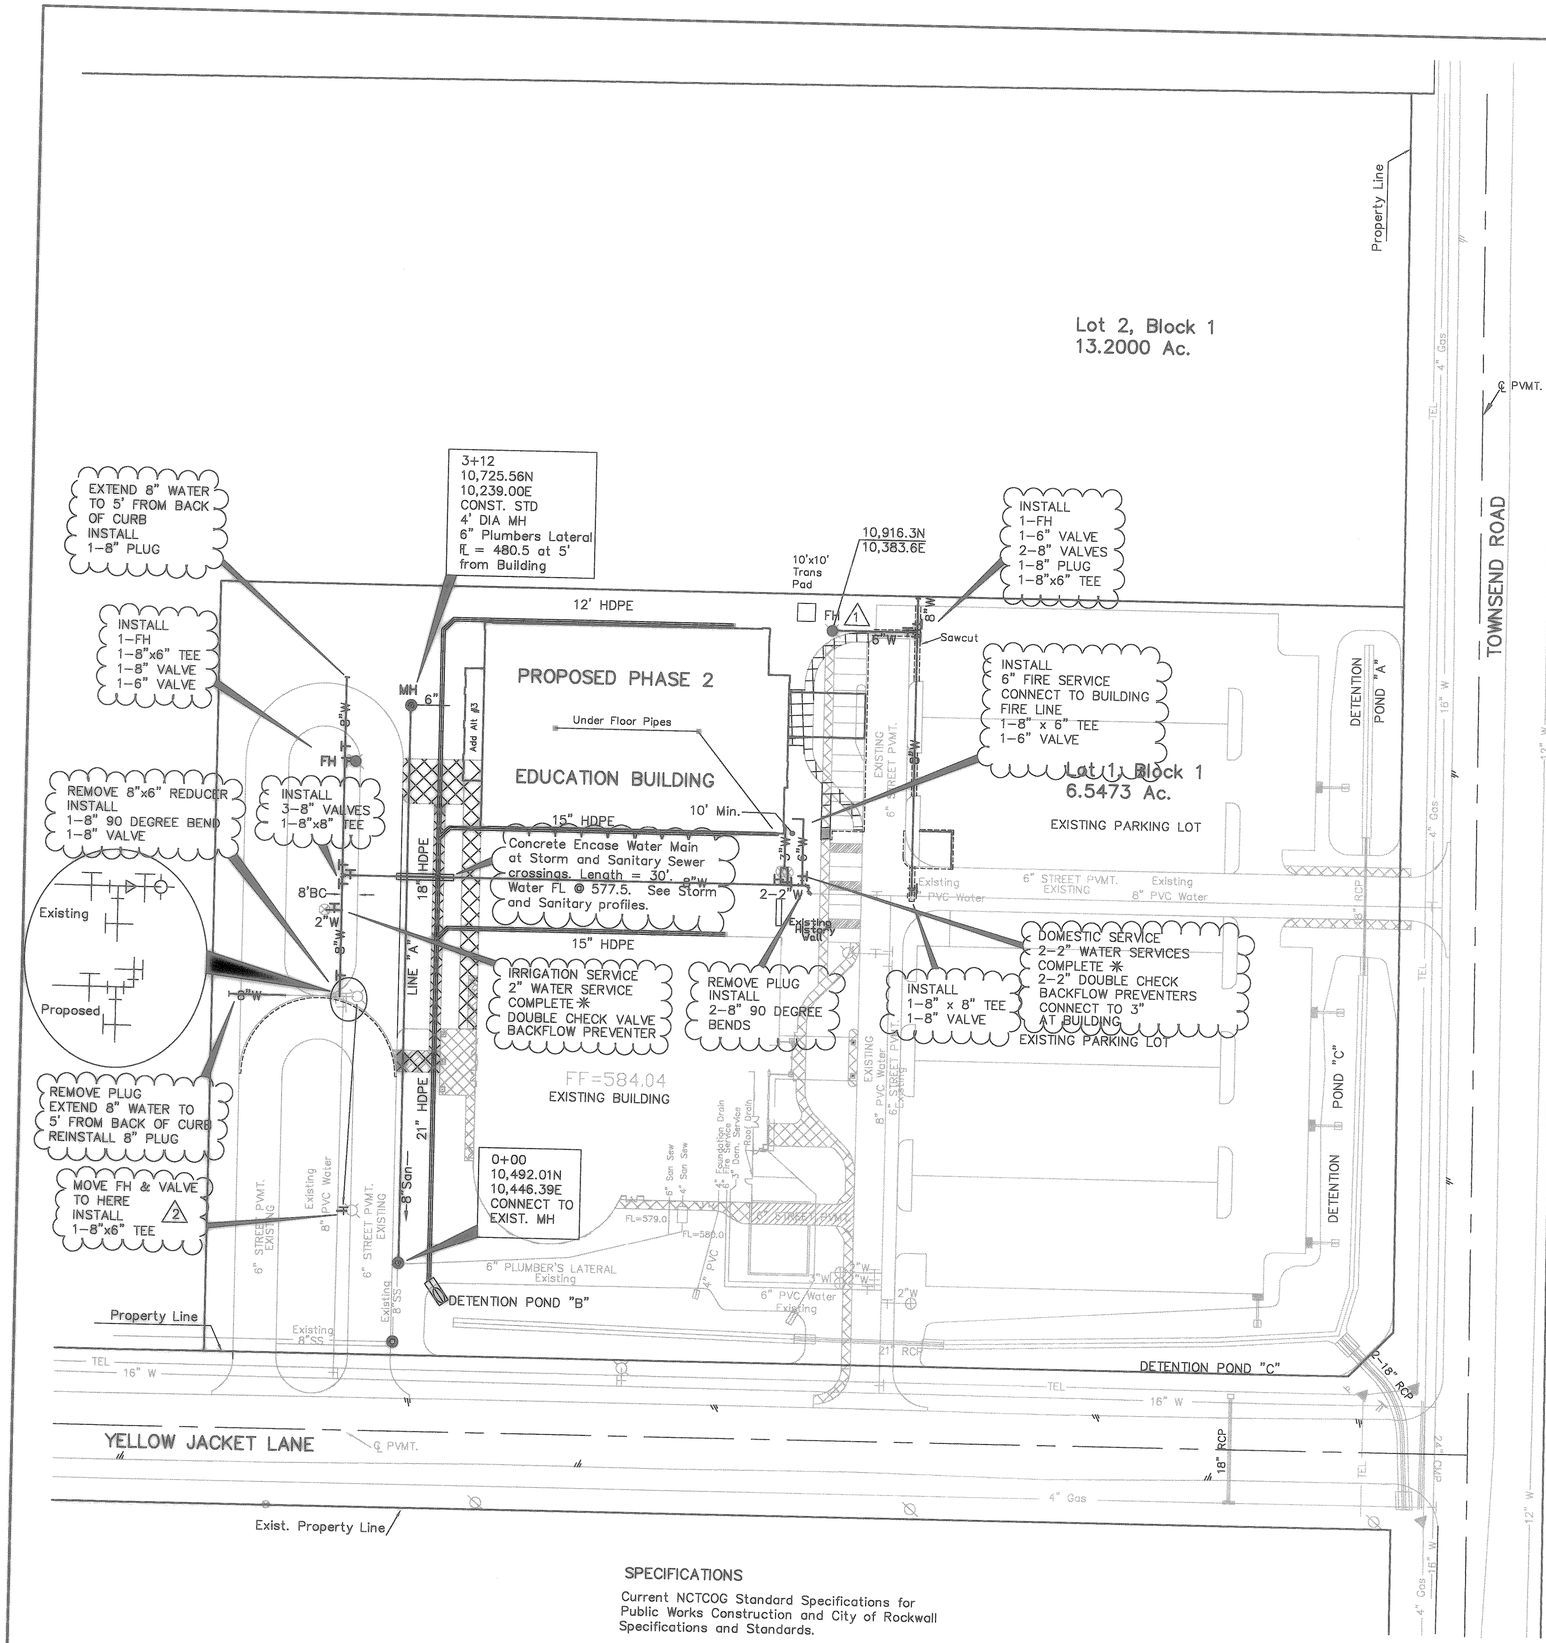

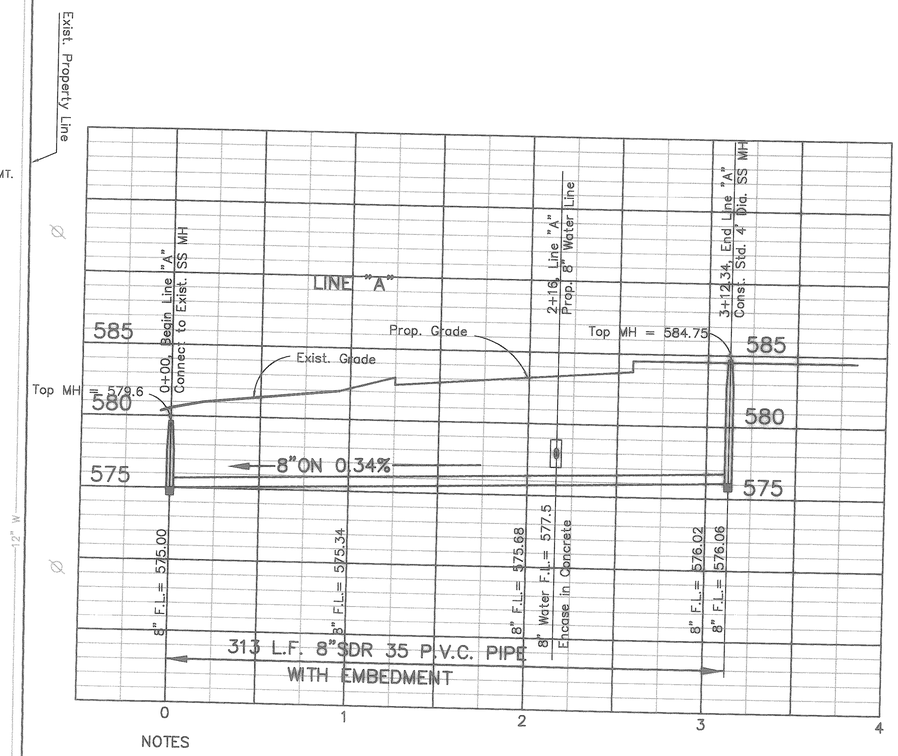

NOTES

1. For additional information see Dimensional Control Sheet.
2. For Details and Construction notes, see Water & Sewer Details sheet.
3. Contractor shall make all connections to site mains, to meters supplied by City of rOckwall, and to building stubouts for both water and sanitary sewers.
4. Fire Sprinkler Line shall be sized and installed by a State Licensed Fire Sprinkler Contractor.
5. Water mains shall be AWWA C-900, PVC, DR14, Class 200.
6. Sanitary sewer shall be SDR 35 PVC with embedment.
7. Pavement sawcuts shall be full depth cuts.
8. Encase water main in 6" - 3000 psi concrete at storm sewer and sanitary sewer crossings.
9. All fire hydrants shall have 5 foot clearance all around.
10. Green EMS disk shall be installed on the sanitary sewer line at every change in direction, manhole, cleanout, and service.

RECORD DRAWINGS
5-24-07

SPECIFICATIONS

Current NCTCOG Standard Specifications for Public Works Construction and City of Rockwall Specifications and Standards.

*WATER SERVICE COMPLETE INCLUDES Tapping pipe, double strap tapping saddle, corporation stop, curb stop, polyethylene service line (SDR-9), (NO COPPER Service line allowed), and meter box. See detail on Water & Sewer Details sheet.

2 9-7-06 Move FH to miss play yard

1 6-5-06 Move Fire Hydrant 18' toward building.

STATE OF TEXAS
Arthur F. Stock
13845
PROFESSIONAL ENGINEER

6/9

July 11, 2006

PHASE 2

WATER & SEWER PLAN/PROFILE
FIRST UNITED METHODIST CHURCH,
ROCKWALL
CITY OF ROCKWALL, TEXAS
F&S PARTNERS and BSM ENGINEERS

DESIGN	DRAWN	DATE	SCALE	NOTES	FILE	NO
F&S	BSM	4-06		BSM		552