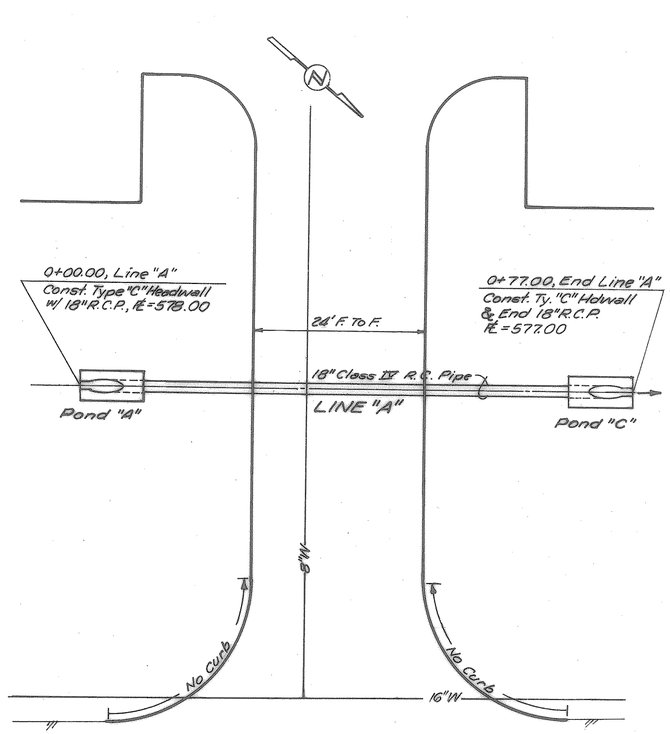

TOWNSEND ROAD

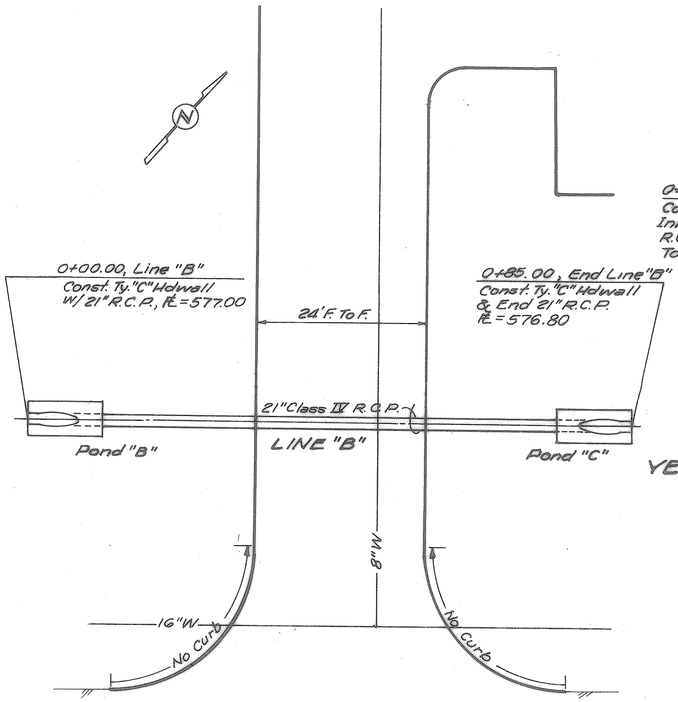

YELLOWJACKET LANE

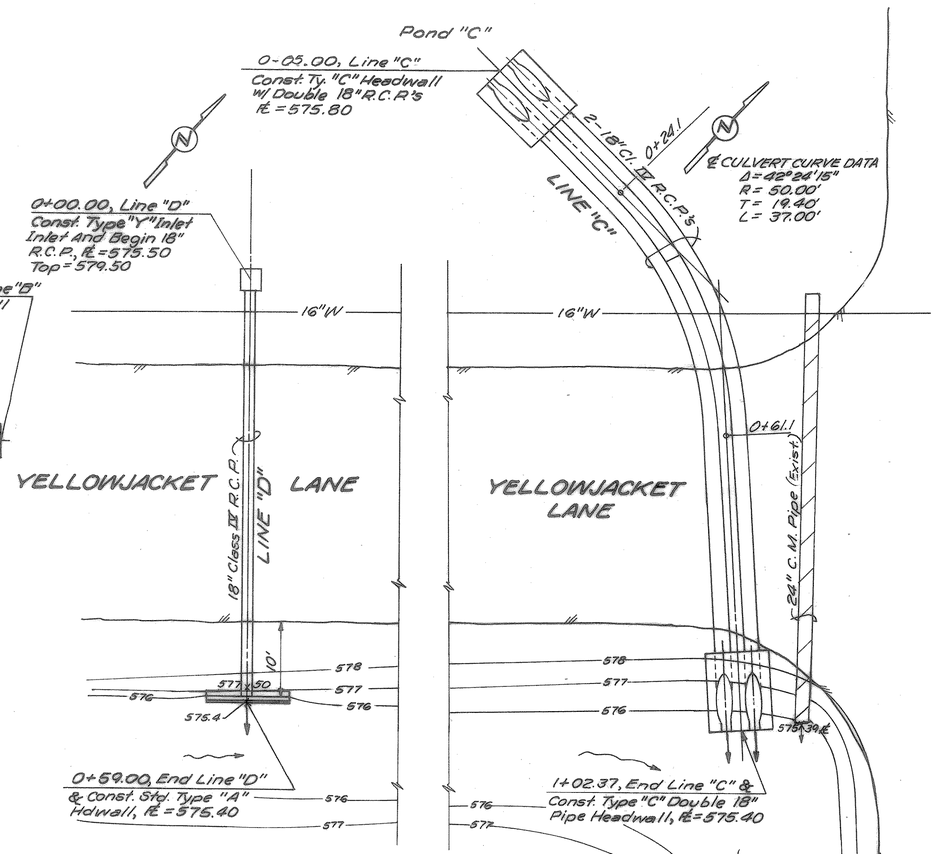

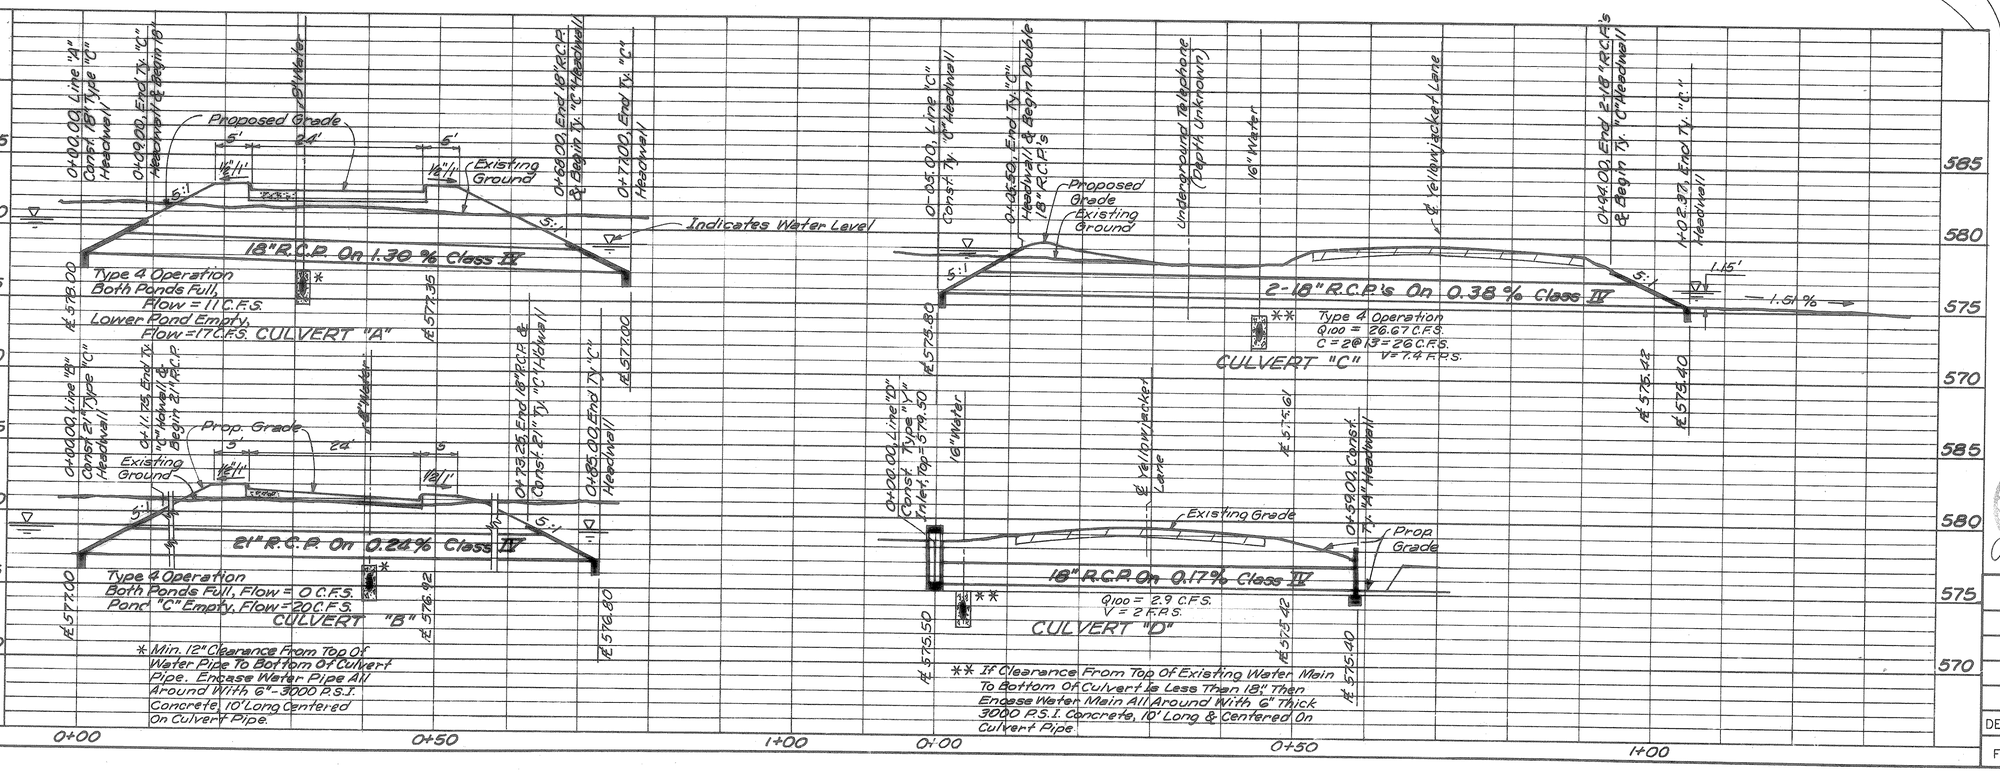

BENCH MARKS:

ELEV. 575.10 "D" cut on northwest corner of headwall at east entrance to Ridge Point Athletic Club on south side of Yellow Jacket

ELEV. 579.03 "D" cut on nose of median, east side of Townsend Road at entrance to high school stadium, aligned with center line of Yellow Jacket Lane.

5-20-03
AS BUILT
ARTHUR F. BECK 13645
11-2-01

C-5

NOV. 19, 2001

CULVERT DETAILS

FIRST UNITED METHODIST CHURCH,
ROCKWALL
CITY OF ROCKWALL, TEXAS
F&S PARTNERS and BSM ENGINEERS

DESIGN	DRAWN	DATE	SCALE	NOTES	FILE	NO
F&S	BSM	11-01	1"=10' H. 1"= 5', V.	BSM		103