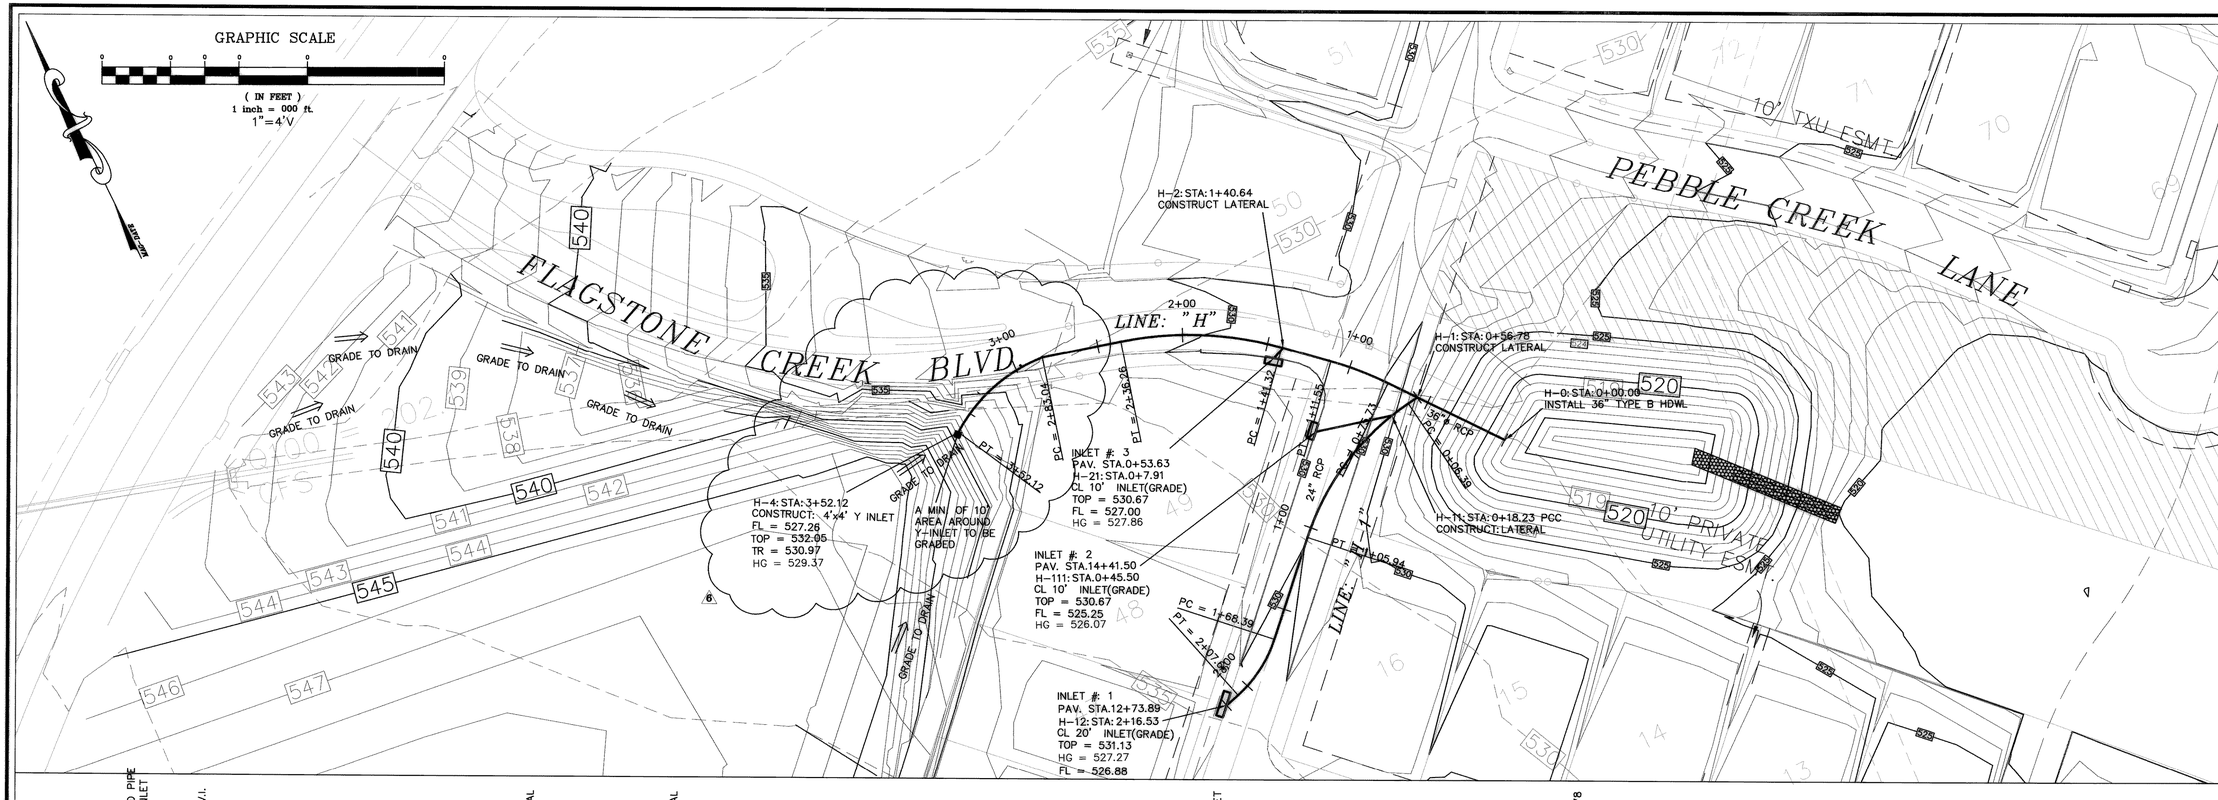

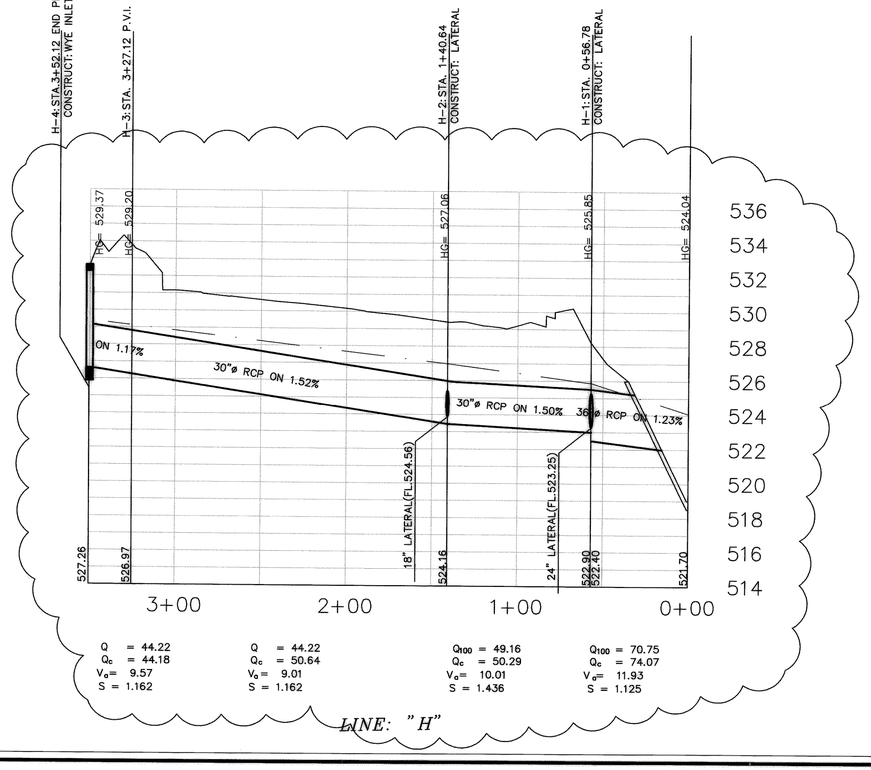

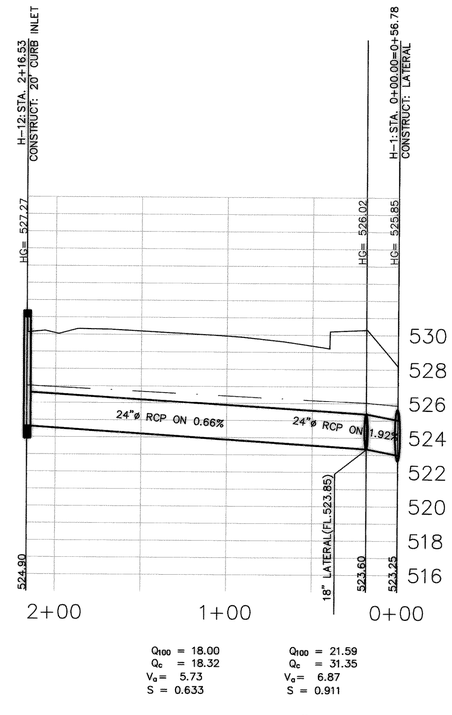

GENERAL NOTES

1. ALL STORM WATER PIPES MUST BE RCP UNLESS NOTED OTHERWISE.

2. WHERE LATERAL JOINS AT PIPE JOINTS OF DIFFERENT DIAMETERS, THE DOWNSTREAM/BIGGER DIA. PIPE IS TO BE EXTENDED 4.0' UPSTREAM.

REVISED TO CONFORM TO CONSTRUCTION RECORDS.
DATE: 10/27/06

THE SEAL APPEARING ON THIS DOCUMENT WAS AUTHORIZED BY W.L. DOUPHRATE II TEXAS P.E. NO. 60102 ON 9/23/06

DOUPHRATE & ASSOCIATES, INC.
ENGINEERING - PROJECT MANAGEMENT - SURVEYING
2235 RIDGE RD. # 200 ROCKWALL, TEXAS 75087
PHONE: (972)771-9004 FAX: (972)771-9005

STORM SEWER PLAN & PROFILE (LINE H & H-1)
FLAGSTONE ESTATES
CITY OF ROCKWALL
ROCKWALL COUNTY, TEXAS

REVISION	
6	05-08-06
1	11-15-05

CHECKED	K.E.B.
DRAWN	D.L.B.
DATE	9/04
SHEET	
PROJECT	33A1
OF	