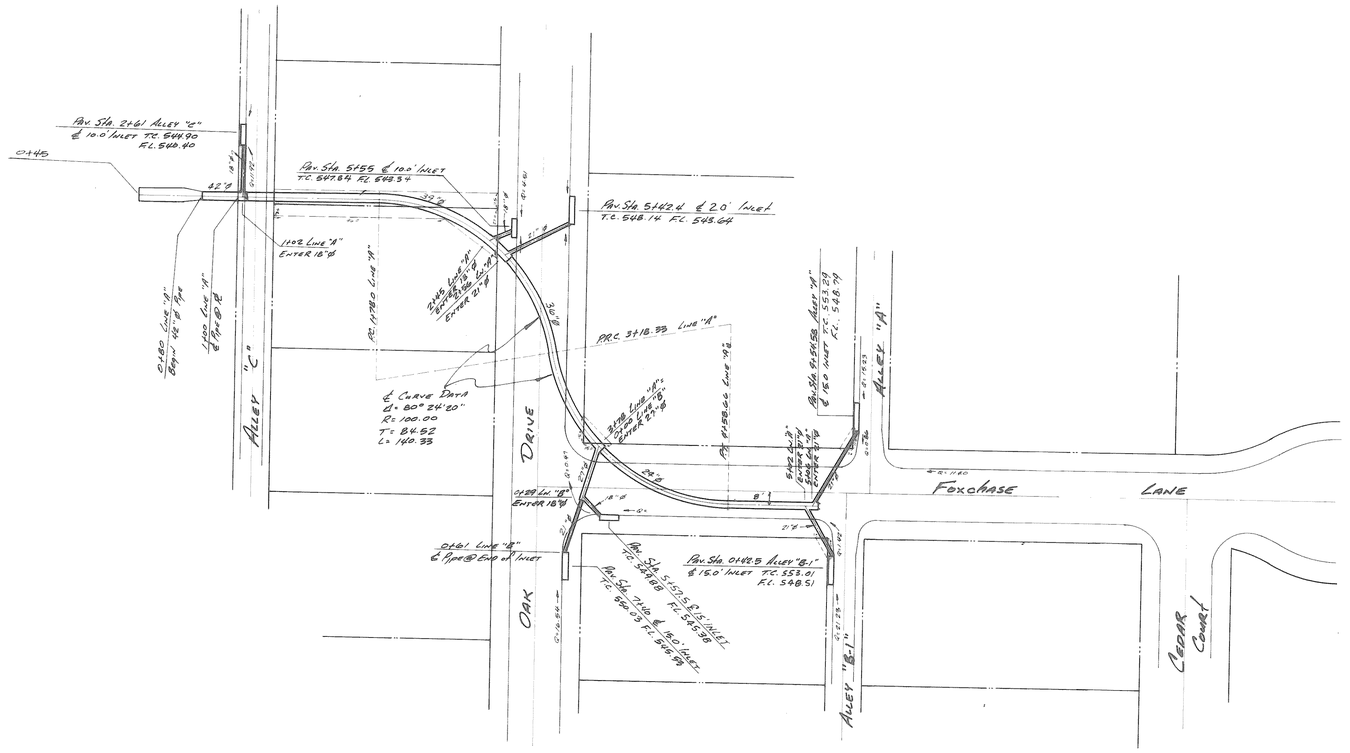

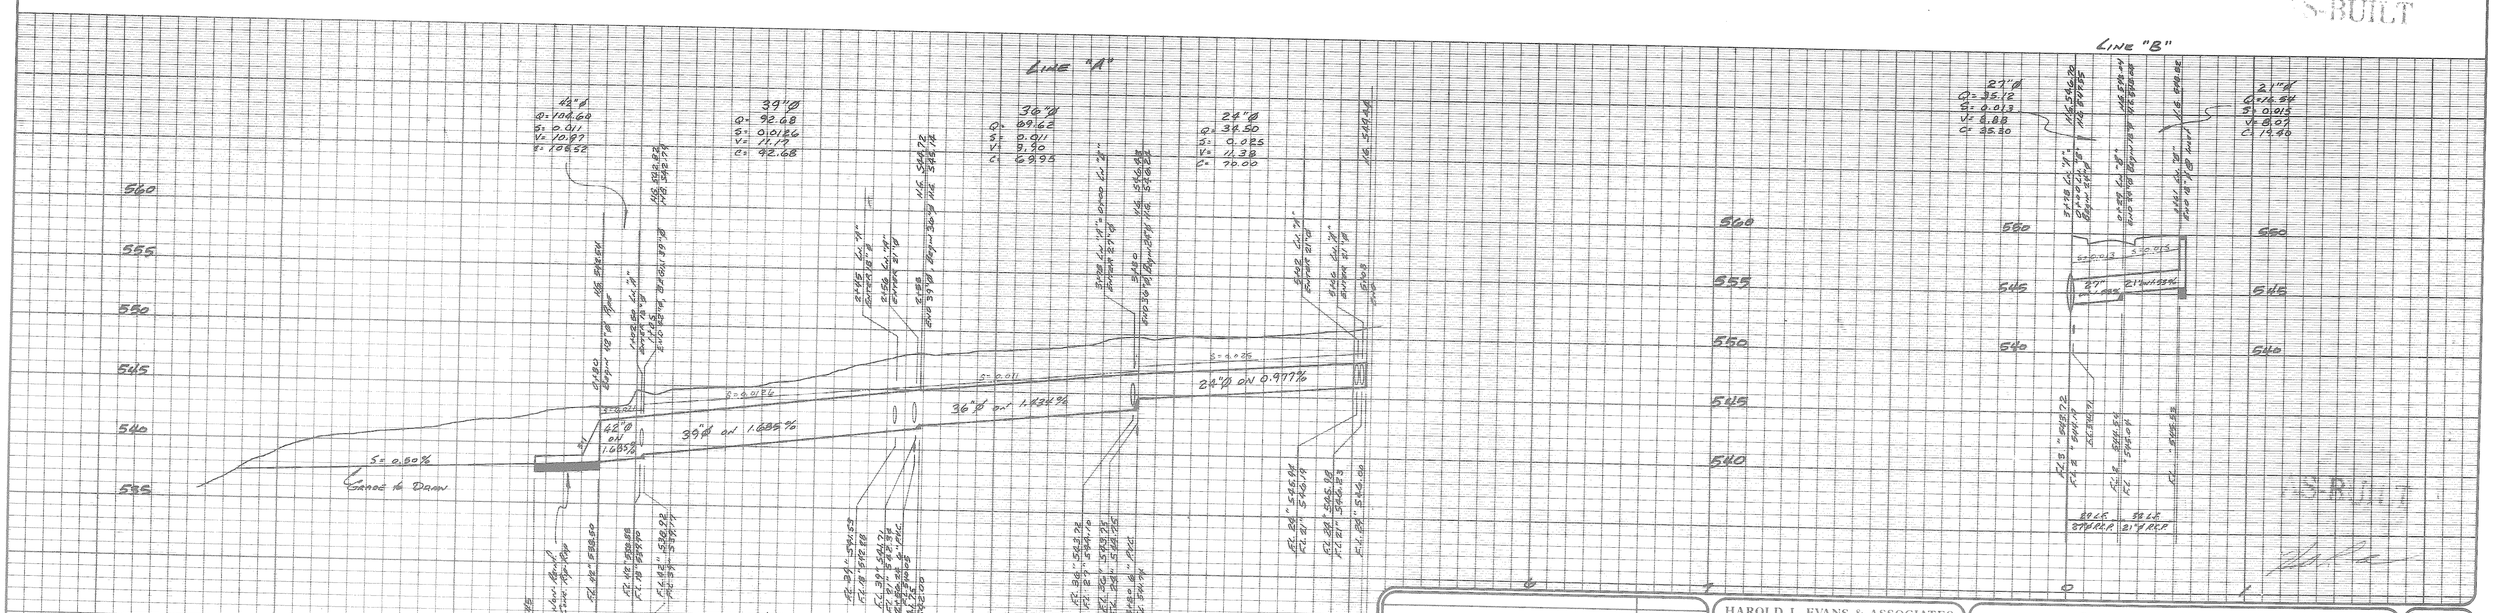

AS-BUILT

REVISION DESCRIPTION	DATE	SCALE	DESIGN	DRAWN
Revised Flow Lines Grades Inlets 3-21-89	7-9-88	1"=40' H. 1"=5' V.	H.L.E.	L.R.

HAROLD L. EVANS & ASSOCIATES
Consulting Engineers
P. O. Box 28355
2331 Gus Thomasson Road, Suite 102
Dallas, Texas 75228 (214) 328-8133

Storm Sewer Plans
Foxchase — Phase One
City of Rockwall
Rockwall County, Texas

SHEET NO. 9/9

JOB NO. 87201