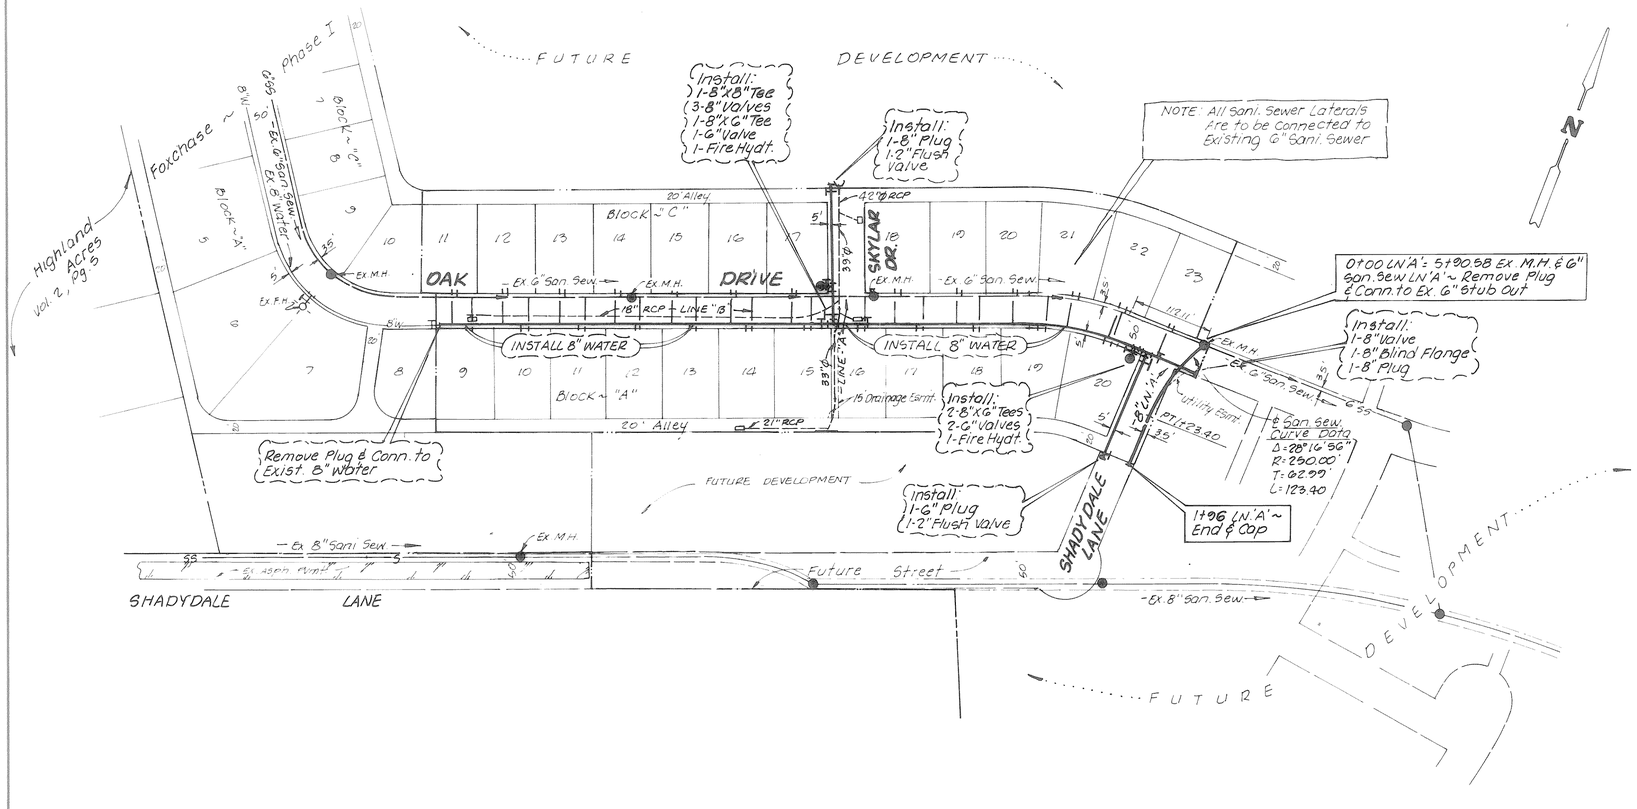

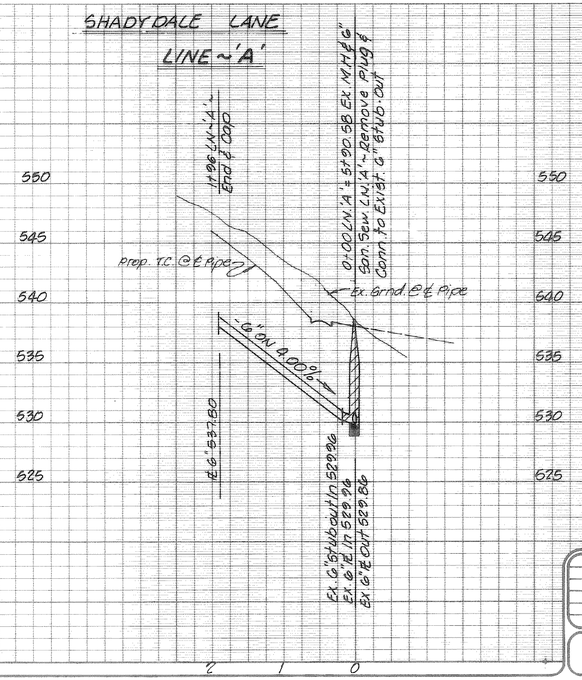

REVISION DESCRIPTION	DATE	SCALE	DESIGN	DRAWN
	11-15-03	1"=100' Horiz. 1"=6' Vert.	H.L.E.	BLS

HAROLD L. EVANS & ASSOCIATES
Consulting Engineers
P. O. Box 28355
2331 Gus Thomasson Road, Suite 102
Dallas, Texas 75228
(214) 328-8133

WATER & SANITARY SEWER PLAN
FOXCHASE - PHASE II
CITY OF ROCKWALL
ROCKWALL COUNTY, TEXAS

SHEET NO. 7/8

JOB NO. 93121