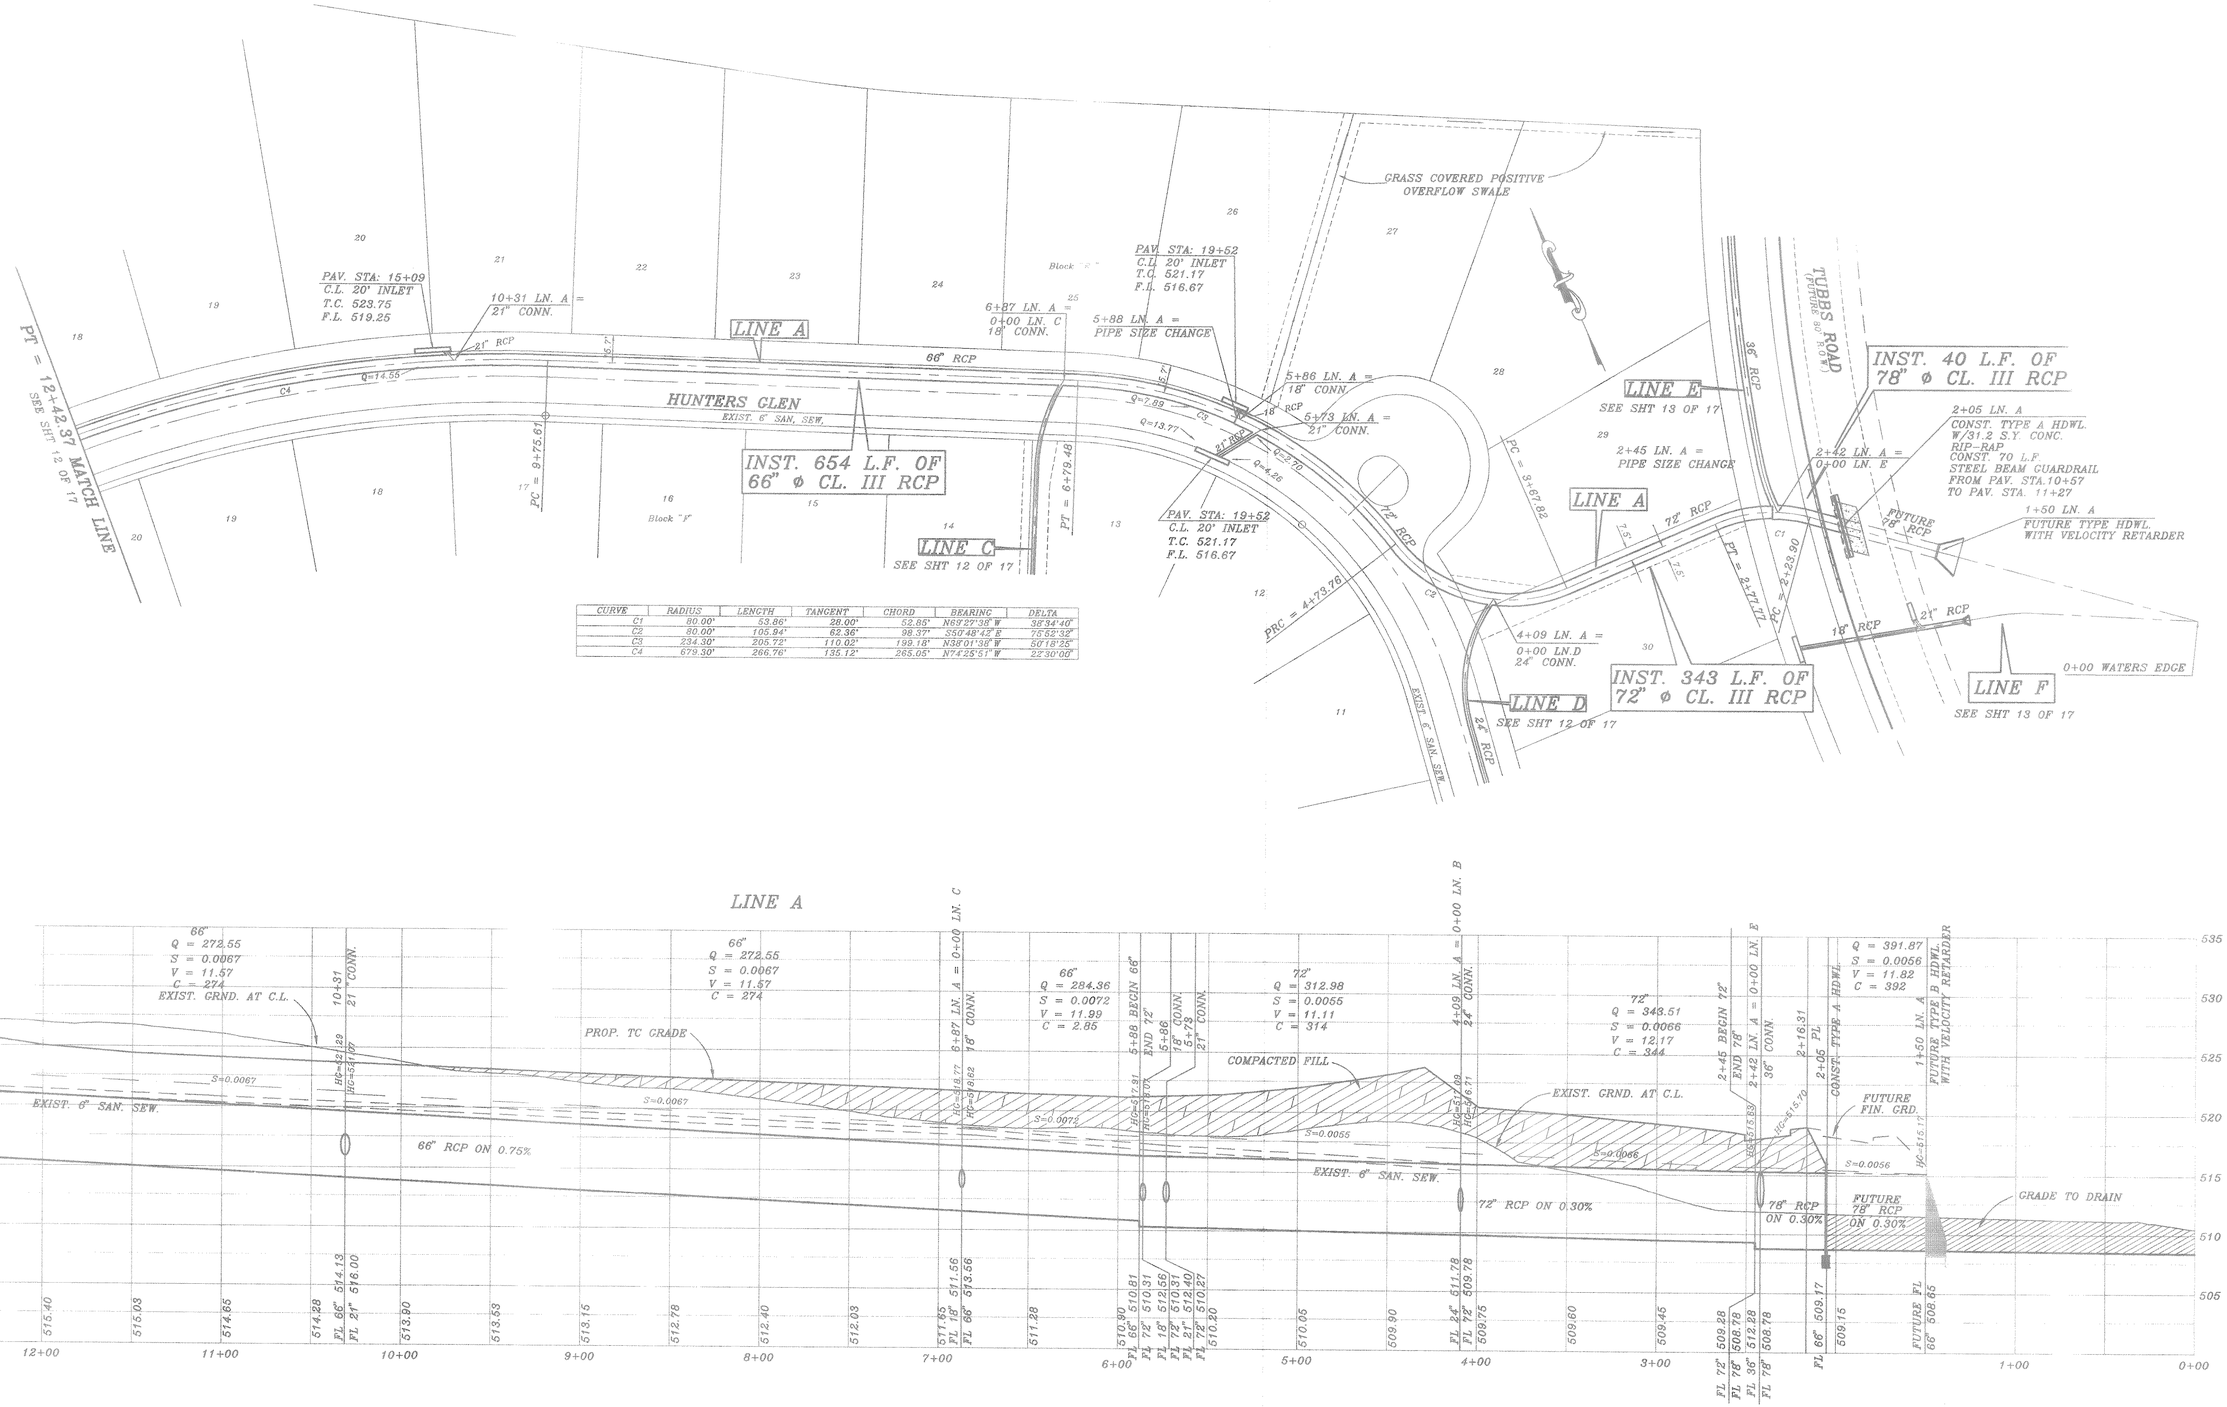

CURVE	RADIUS	LENGTH	TANGENT	CHORD	BEARING	DELTA
C1	80.00'	53.86'	28.00'	52.85'	N69°27'38" W	38°34'40"
C2	80.00'	105.94'	62.36'	98.37'	S50°48'42" E	75°52'32"
C3	234.30'	205.72'	110.02'	199.18'	N38°01'38" W	50°18'25"
C4	679.30'	266.76'	135.12'	265.05'	N74°25'51" W	22°30'00"

B.M.
CITY OF ROCKWALL BRASS DISK ON N.E. CORNER OF 20' INLET ON WEST SIDE STEEPLE CHASE LANE, 1,040' +/- SOUTH OF THE INTERSECTION OF STEEPLE CHASE LANE AND OAK DRIVE.
ELEV.: 540.50

B.M.
CITY OF ROCKWALL BRASS DISK ON N.W. CORNER OF 20' INLET ON WEST SIDE SKYLAR DRIVE, 75' +/- NORTH OF THE INTERSECTION OF SKYLAR DRIVE AND HUNTERS GLEN.
ELEV.: 532.63

STATE OF TEXAS
HAROLD L. EVANS
23155
REGISTERED PROFESSIONAL ENGINEER
6-98

REVISION DESCRIPTION	DATE
REV. PER 4th. CITY REVIEW	6/24/98
REV. PER 2nd. CITY REVIEW	1/28/97
REV. PER CITY REVIEW	1/28/97
FOXSST11	

HAROLD L. EVANS
CONSULTING ENGINEER
P.O. BOX 28355
2331 GUS THOMASSON ROAD, SUITE 102
DALLAS, TEXAS 75228, (214) 328-3133

DATE	SCALE	DESIGN	DRAWN
10/10/97	1" = 40' 1" = 6'	H.L.E.	

PROPOSED STORM SEWER
LINE A
FOXCHASE PHASE 5
CITY OF ROCKWALL

SHEET NO. 11 / 17
JOB NO. 9781