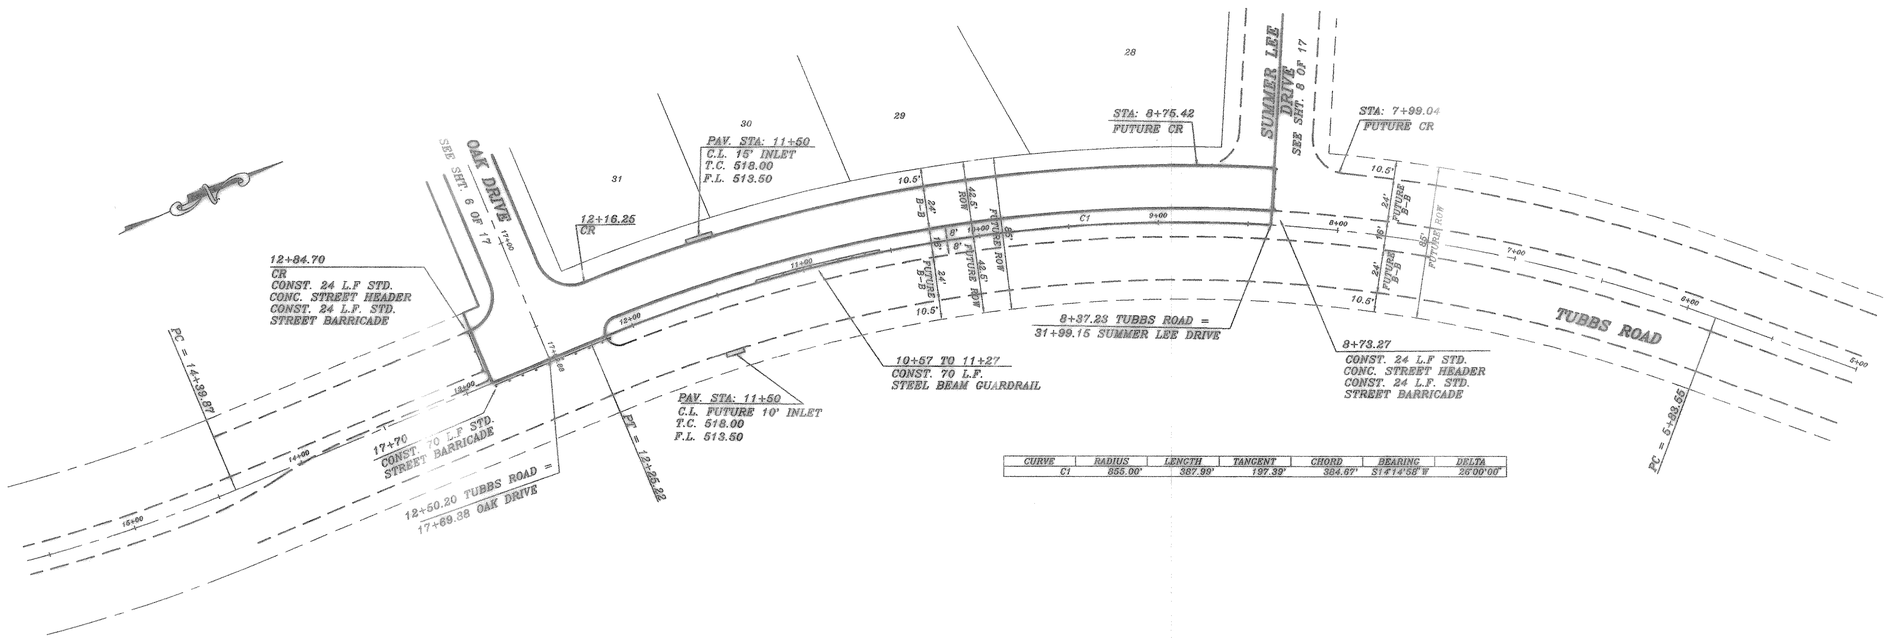

CURVE	RADIUS	LENGTH	TANGENT	CHORD	BEARING	DELTA
C1	855.00'	387.99'	197.39'	384.67'	S1°14'58"W	26°00'00"

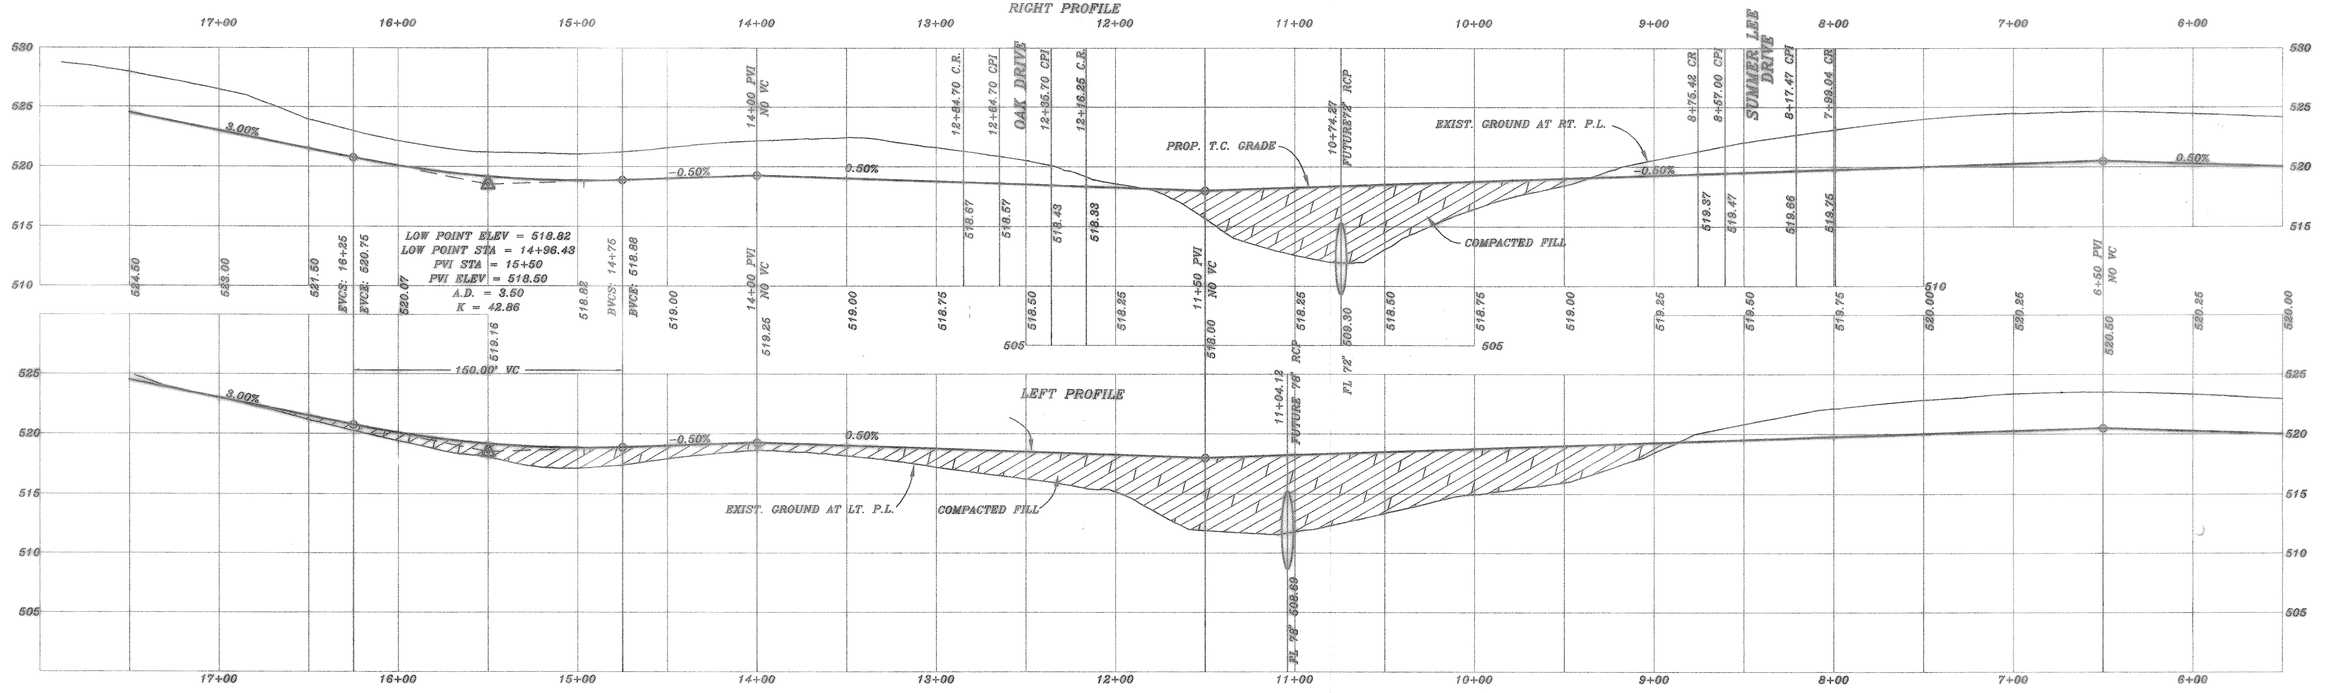

B.M.
CITY OF ROCKWALL BRASS DISK ON N.E. CORNER OF 20' INLET ON WEST SIDE STEEPLE CHASE LANE, 1,040' +/- SOUTH OF THE INTERSECTION OF STEEPLE CHASE LANE AND OAK DRIVE.
ELEV.: 540.50

B.M.
CITY OF ROCKWALL BRASS DISK ON N.W. CORNER OF 20' INLET ON WEST SIDE SKYLAR DRIVE, 75' +/- NORTH OF THE INTERSECTION OF SKYLAR DRIVE AND HUNTERS GLEN.
ELEV.: 532.63

STATE OF TEXAS
HAROLD L. EVANS
23155
REGISTERED
PROFESSIONAL ENGINEER
6-98

REVISION DESCRIPTION	DATE
REV. PER 4th. CITY REVIEW	6/24/98
REV. PER 3rd. CITY REVIEW	5/12/98
REV. PER 2nd. CITY REVIEW	3/24/98
REV. PER CITY REVIEW	12/26/97

FOXGPY6

DATE	SCALE	DESIGN	DRAWN
10/10/97	1" = 40' / 1" = 6'	H.L.E.	

HAROLD L. EVANS
CONSULTING ENGINEER
P.O. BOX 28355
2331 GUS THOMASSON ROAD, SUITE 102
DALLAS, TEXAS 75228, (214) 328-8133

PROPOSED PAVING
TUBBS ROAD
FOXCHASE PHASE 5
CITY OF ROCKWALL

SHEET NO. 9 / 17

JOB NO. 9761