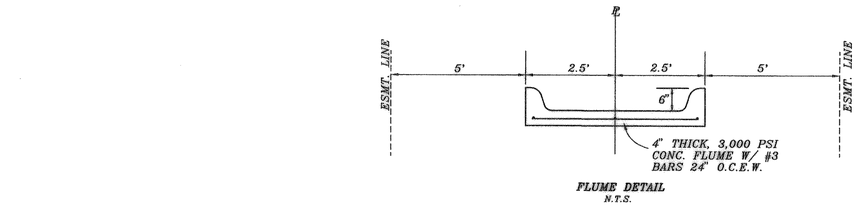

FLUME DETAIL
N.T.S.

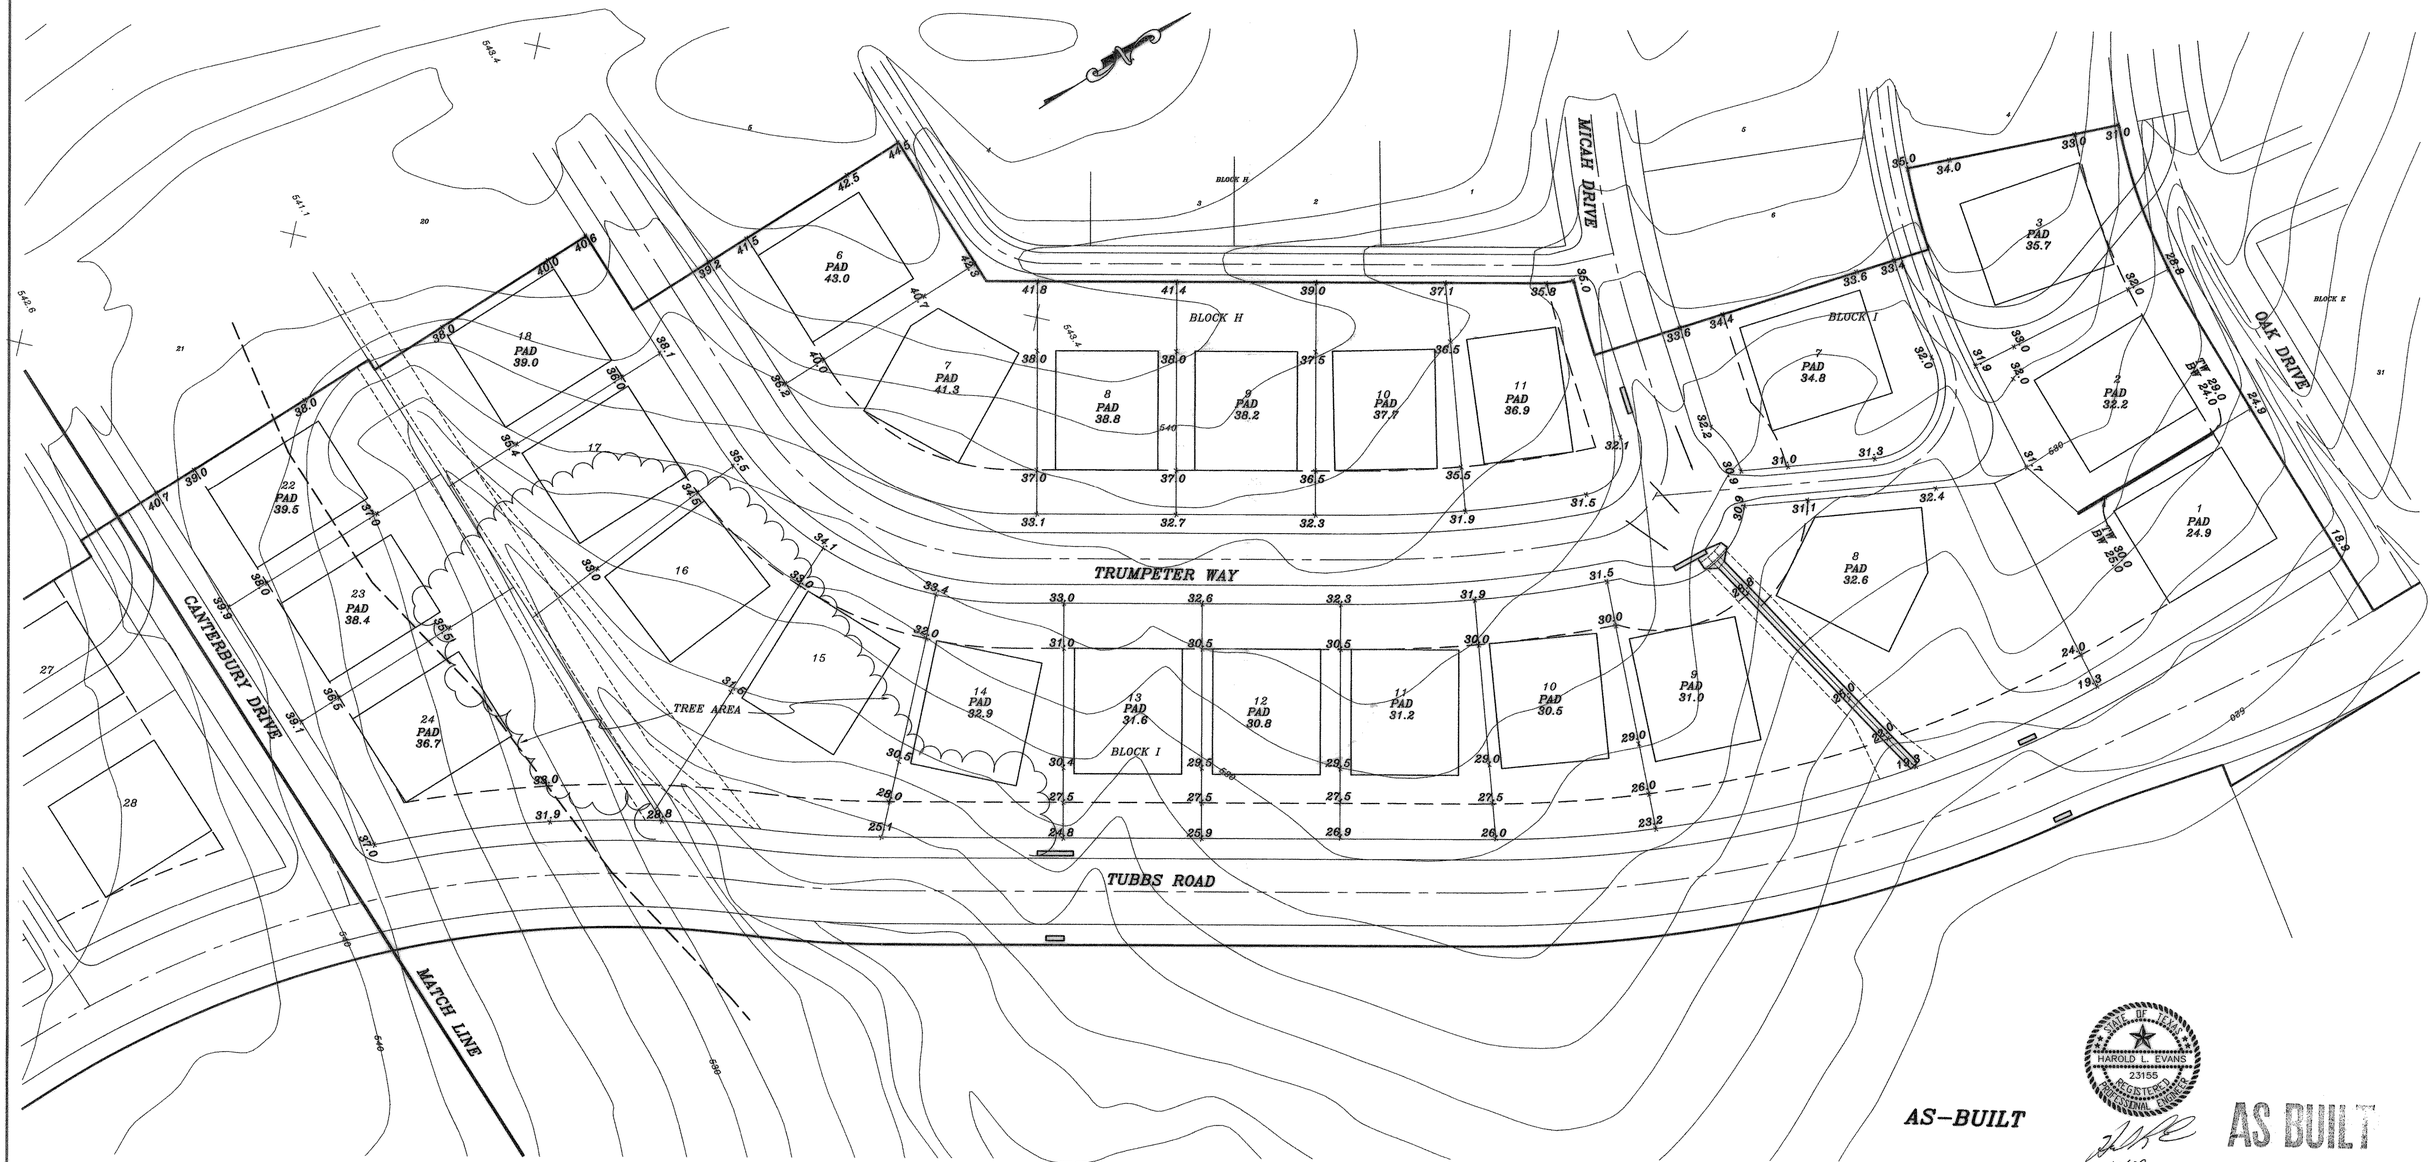

AS-BUILT

STATE OF TEXAS
HAROLD L. EVANS
23155
REGISTERED
PROFESSIONAL ENGINEER
10/99

AS BUILT

REVISION DESCRIPTION	DATE	SCALE	DESIGN / DRAWN
FOXSGRD1	8/19/99	1" = 40'	H.L.E. /

HAROLD L. EVANS
CONSULTING ENGINEER
P.O. BOX 28355
2331 GUS THOMASSON ROAD, SUITE 102
DALLAS, TEXAS 75228, (214) 328-8133

LOT GRADING PLAN

FOXCHASE NO. 6
CITY OF ROCKWALL

SHEET NO. 12 / 14

JOB NO. 98111