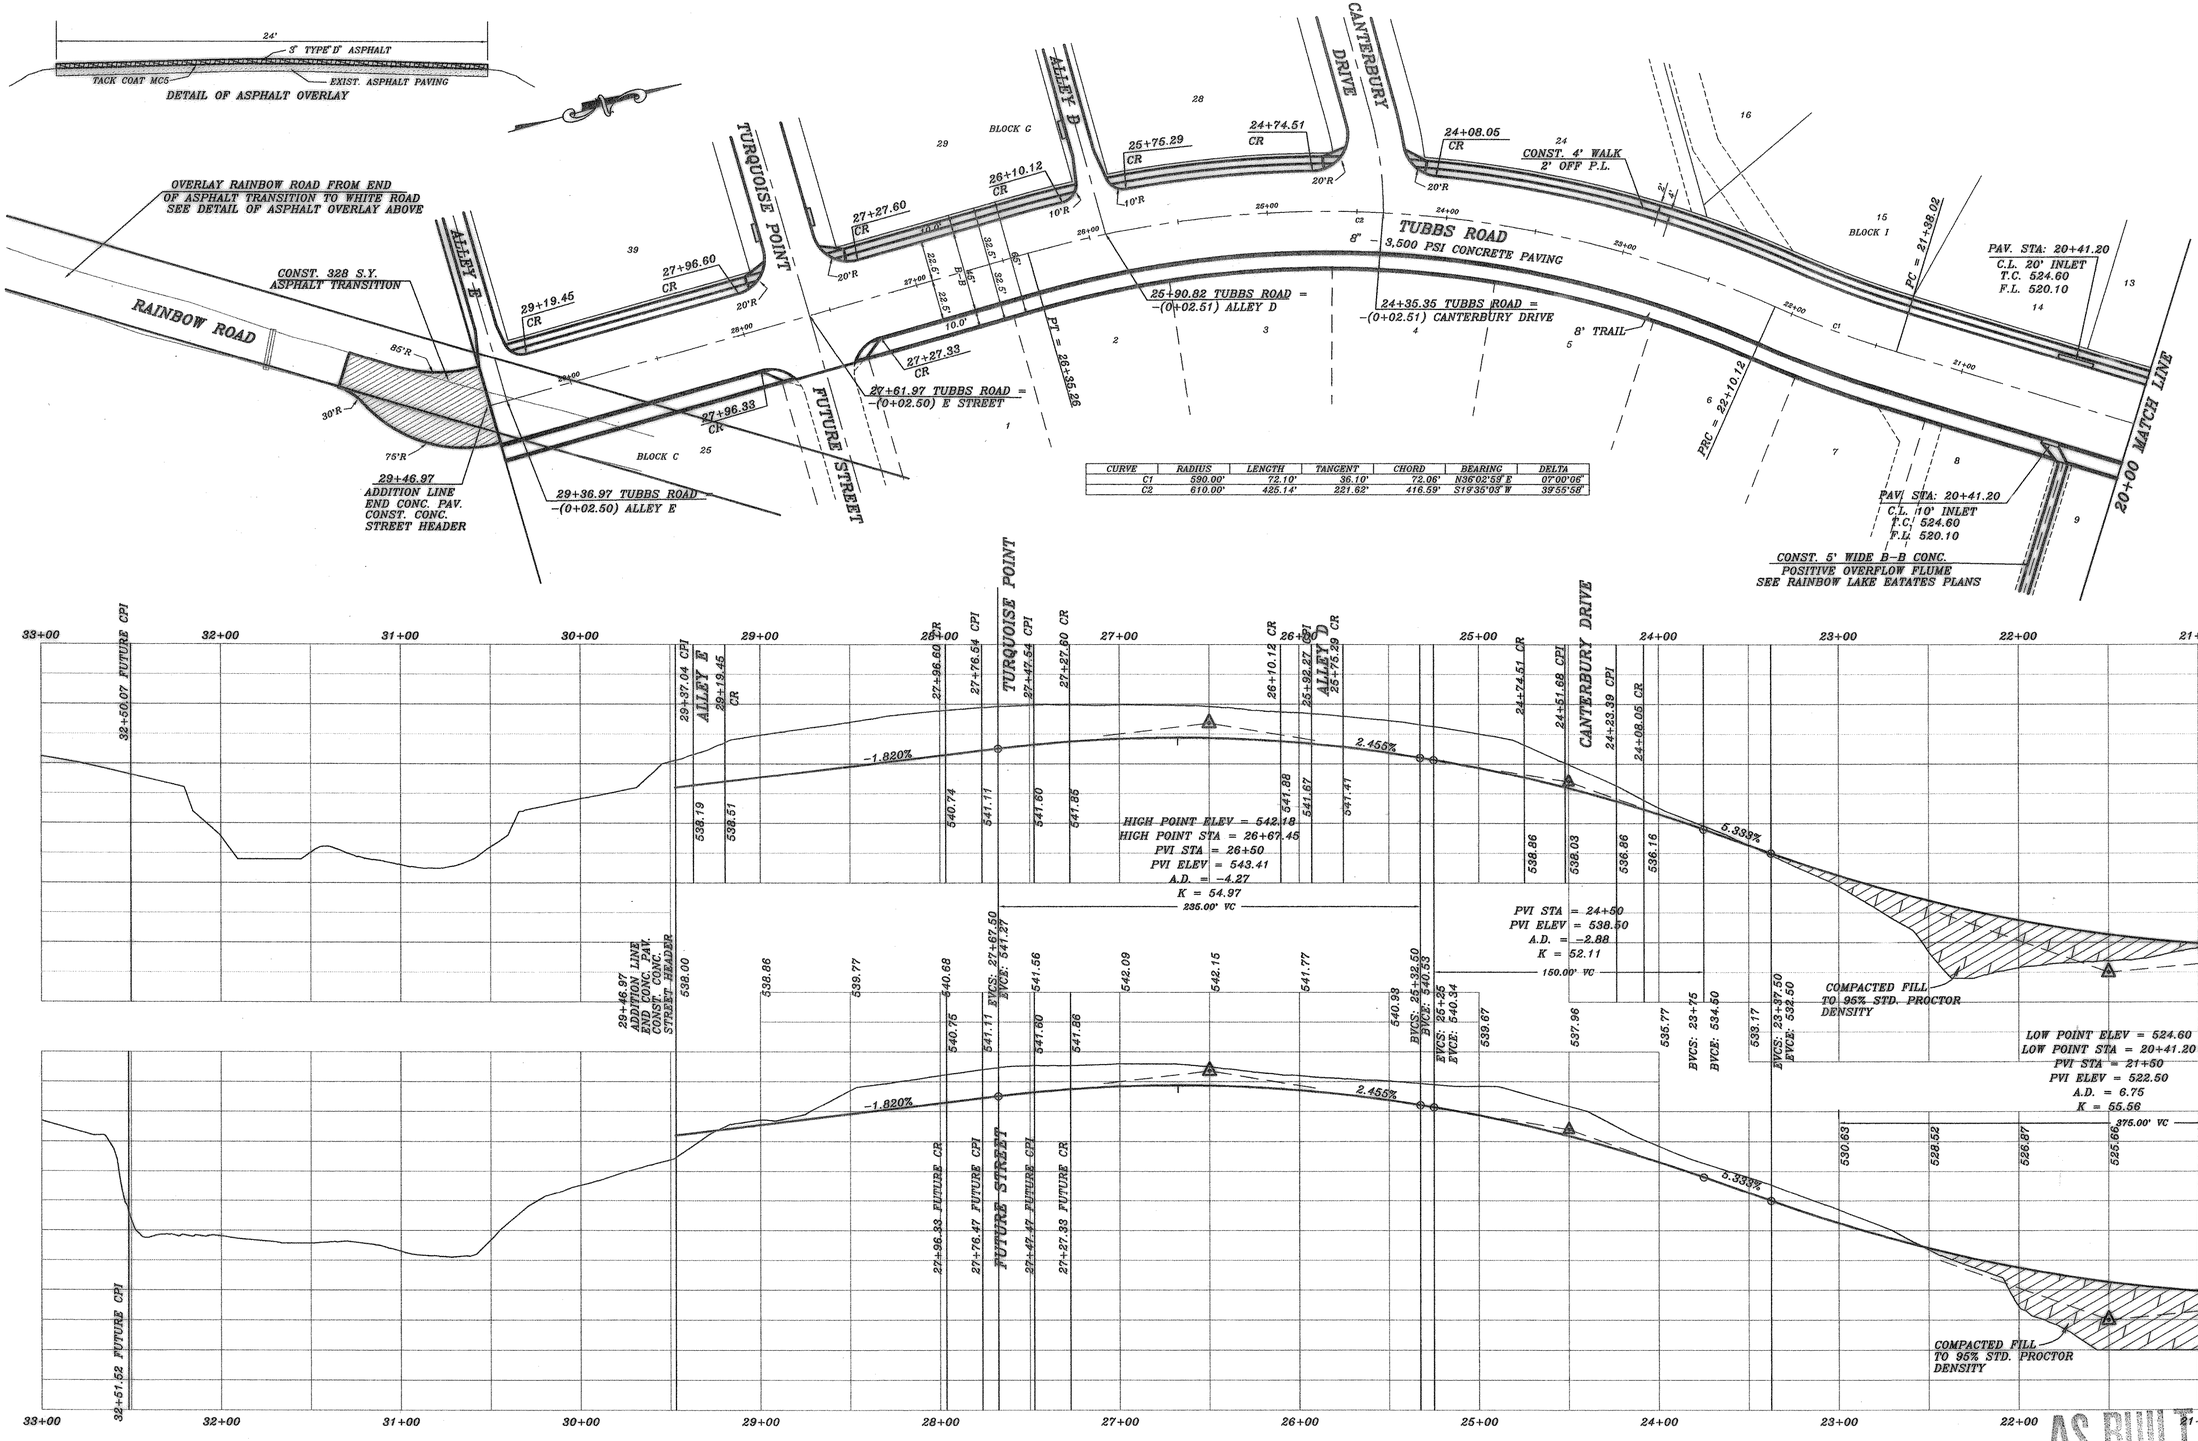

CURVE	RADIUS	LENGTH	TANGENT	CHORD	BEARING	DELTA
C1	590.00'	72.10'	36.10'	72.06'	N36°02'59" E	07°00'06"
C2	610.00'	425.14'	221.62'	416.59'	S19°35'03" W	39°55'58"

AS BUILT

HAROLD L. EVANS
CONSULTING ENGINEER
P.O. BOX 28355
2331 GUS THOMASSON ROAD, SUITE 102
DALLAS, TEXAS 75228, (214) 328-8133

REVISION DESCRIPTION	DATE
REV. PER 2nd. CITY REVIEW	1/26/00
REV. PER CITY REVIEW	10/29/99
REV. PAV. WIDTH	8/27/99

FOXSPVZ

DATE	SCALE	DESIGN	DRAWN
8/19/99	1" = 40' 1" = 6'	H.L.E.	

PROPOSED PAVING
TUBBS ROAD
FOXCHASE NO. 6
CITY OF ROCKWALL

SHEET NO. 4 / 14

JOB NO. 98111