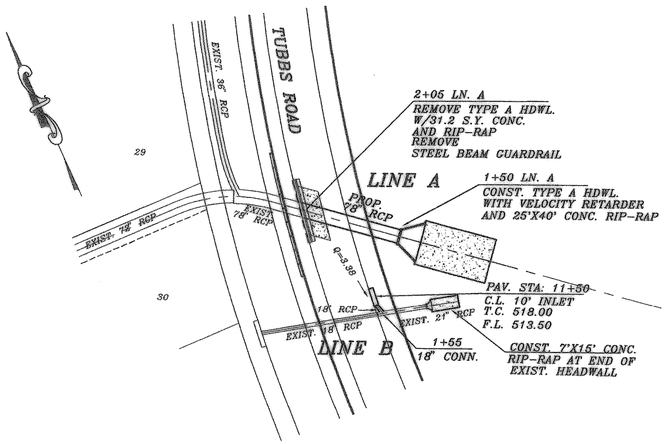

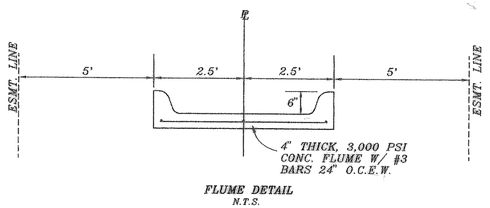

FLUME DETAIL
N.T.S.

CURVE	RADIUS	LENGTH	TANGENT	CHORD	BEARING	DELTA
C1	100.00'	100.24'	54.79'	96.10'	S44°53'21" W	57°26'04"
C2	486.70'	49.22'	24.63'	49.20'	S13°16'29" W	05°47'35"
C3	100.00'	119.08'	67.74'	112.16'	N44°29'25" E	68°13'31"
C4	100.00'	45.67'	23.24'	45.28'	S88°18'44" E	26°10'10"

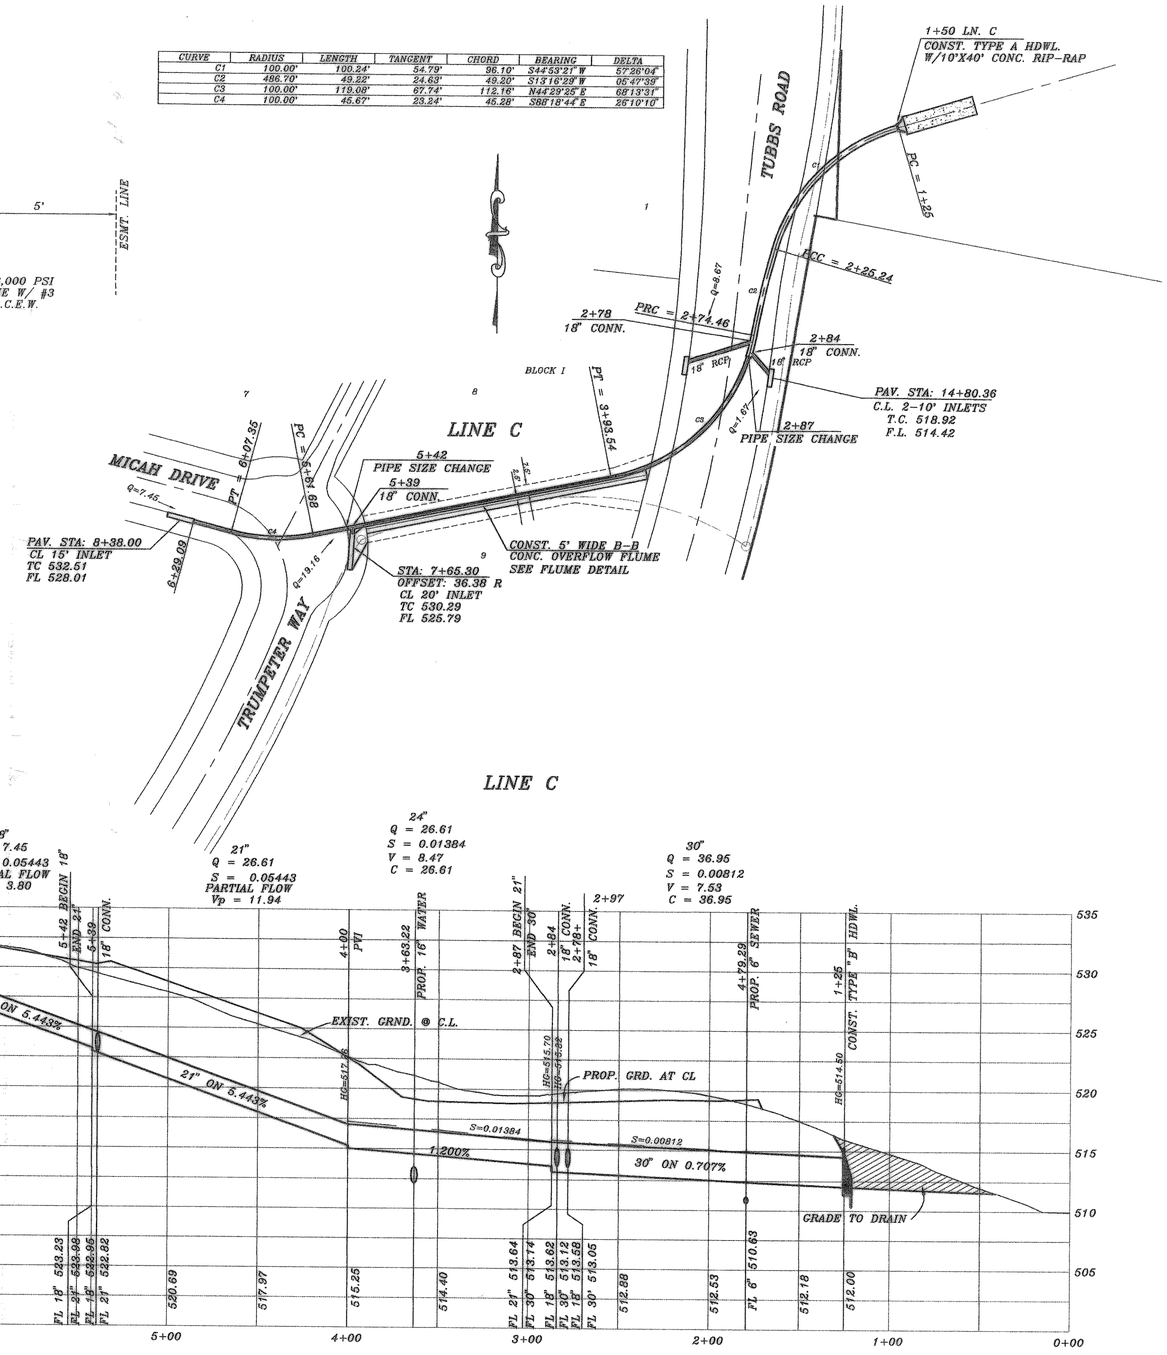

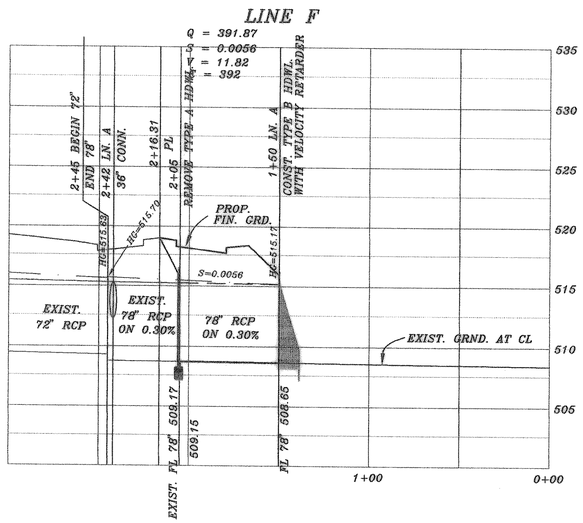

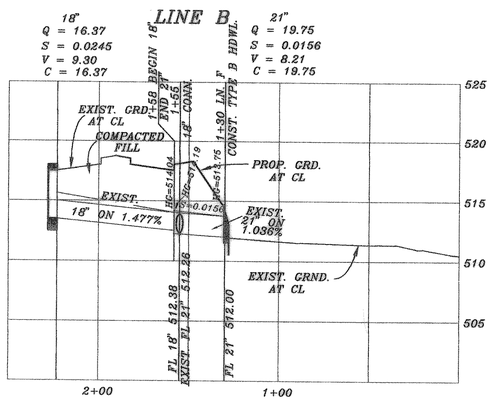

AS BUILT

STATE OF TEXAS
HAROLD L. EVANS
23155
REGISTERED PROFESSIONAL ENGINEER

11-99

REV.	DATE
REV. PER CITY REVIEW	10/30/99
REV.	8/28/99

REVISION DESCRIPTION

FOXSSTM1

HAROLD L. EVANS
CONSULTING ENGINEER
P.O. BOX 28355
2331 GUS THOMASSON ROAD, SUITE 102
DALLAS, TEXAS 75228, (214) 328-8133

DATE	SCALE	DESIGN	DRAWN
8/919/99	1" = 40' 1" = 6'	H.L.E.	

PROPOSED DRAINAGE
LINE A, F,
FOXCHASE NO. 6
CITY OF ROCKWALL

SHEET NO. 9 / 14

JOB NO. 98111