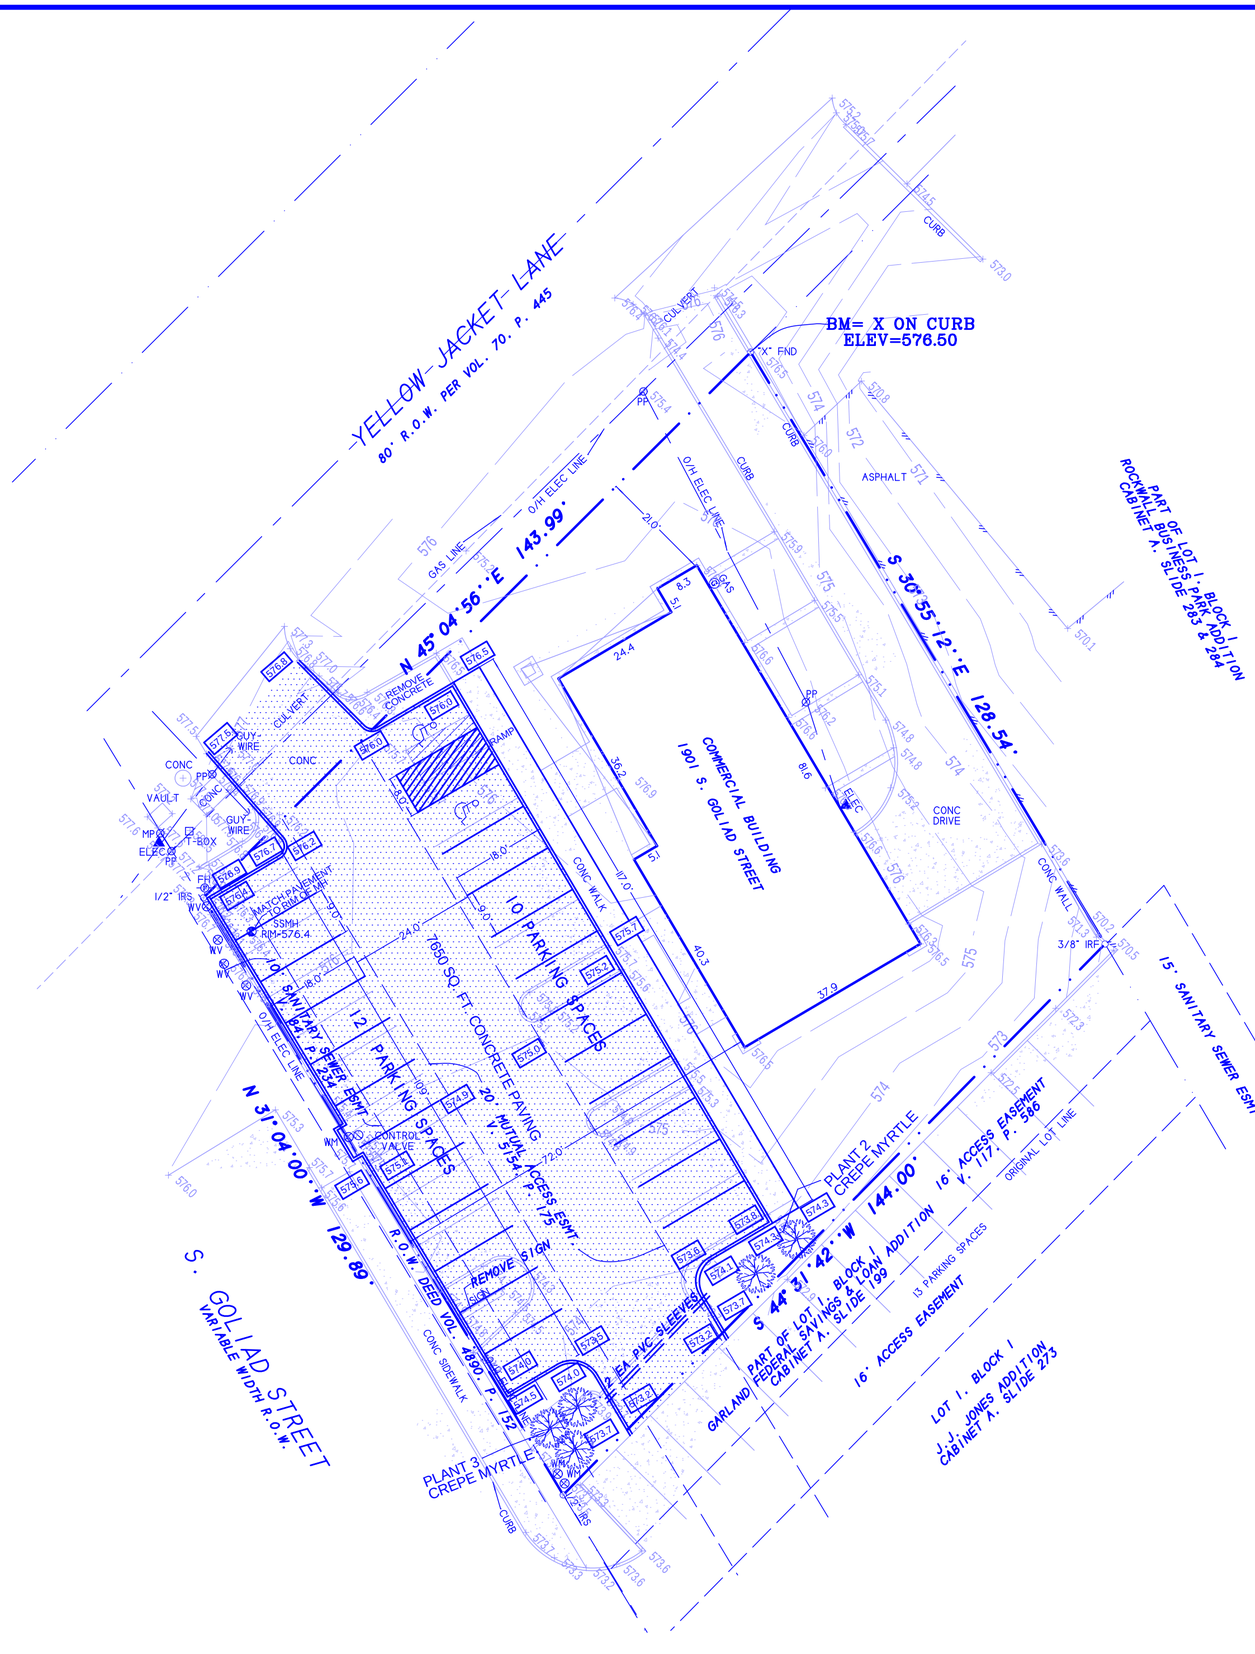

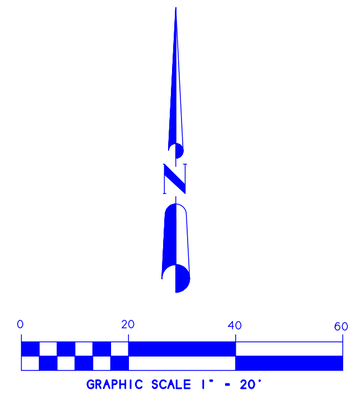

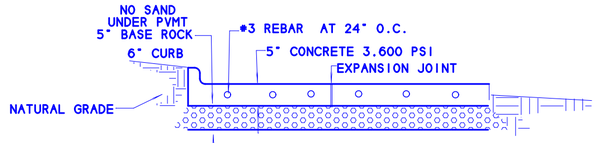

TYPICAL
CONCRETE PAVEMENT
CROSS SECTION

AS BUILT

SITE PLAN
LOT 1, BLOCK 1
GARLAND FEDERAL SAVINGS & LOAN ADDITION

A PART OF THE JOSEPH CADLE
SURVEY, ABSTRACT NO. 65
CITY OF ROCKWALL
ROCKWALL COUNTY, TEXAS

OWNERS:
DONNA CULLINS PRITCHARD
KIMBERLY COLLICHIO
1610 SHORES BLVD.
ROCKWALL, TX 75087
972-771-3060

SYMBOL LEGEND

TV TELEVISION CABLE RISER	GAS GAS METER	TEL PHONE RISER	FH FIRE HYDRANT	PP POWER POLE
ELEC ELECTRIC METER	TU ELEC BOX SUBSURFACE JUNCTION BOX	WM WATER METER	1/2" IRF IRON ROD FOUND CORNER	
FENCE		A/C AIR COND. UNIT	LP LIGHT POLE	PROPANE TANK

PROPERTY LINES

R.S.C.I
ROCKWALL SURVEYING CO., INC. LAND SURVEYING
1984 S. FM 551 ROYSE CITY, TX 75189 972-772-5434 PHONE 972-772-5443 FAX

SURVEY DATE	JULY 9, 2008		
SCALE	1" = 20'	FILE #	200805475P
CLIENT	PRITCHARD	GF #	NONE