**NOTES TO CONTRACTOR:**

CONTRACTOR TO CALL CITY FOR EX. UTILITIES LOCATIONS

CONTRACTOR TO MAINTAIN EXISTING ROADWAY DITCHES

CONTRACTOR TO USE BENCHMARKS SHOWN ON THESE PLANS

CONTRACTOR TO PLACE FIRE LANE MARKING PER DETAIL ON CE-1.

THERE SHALL BE NO OBSTRUCTION TO THE REQUIRED FIRE LANE INCLUDING GATES WITHOUT FIRE DEPARTMENT APPROVAL

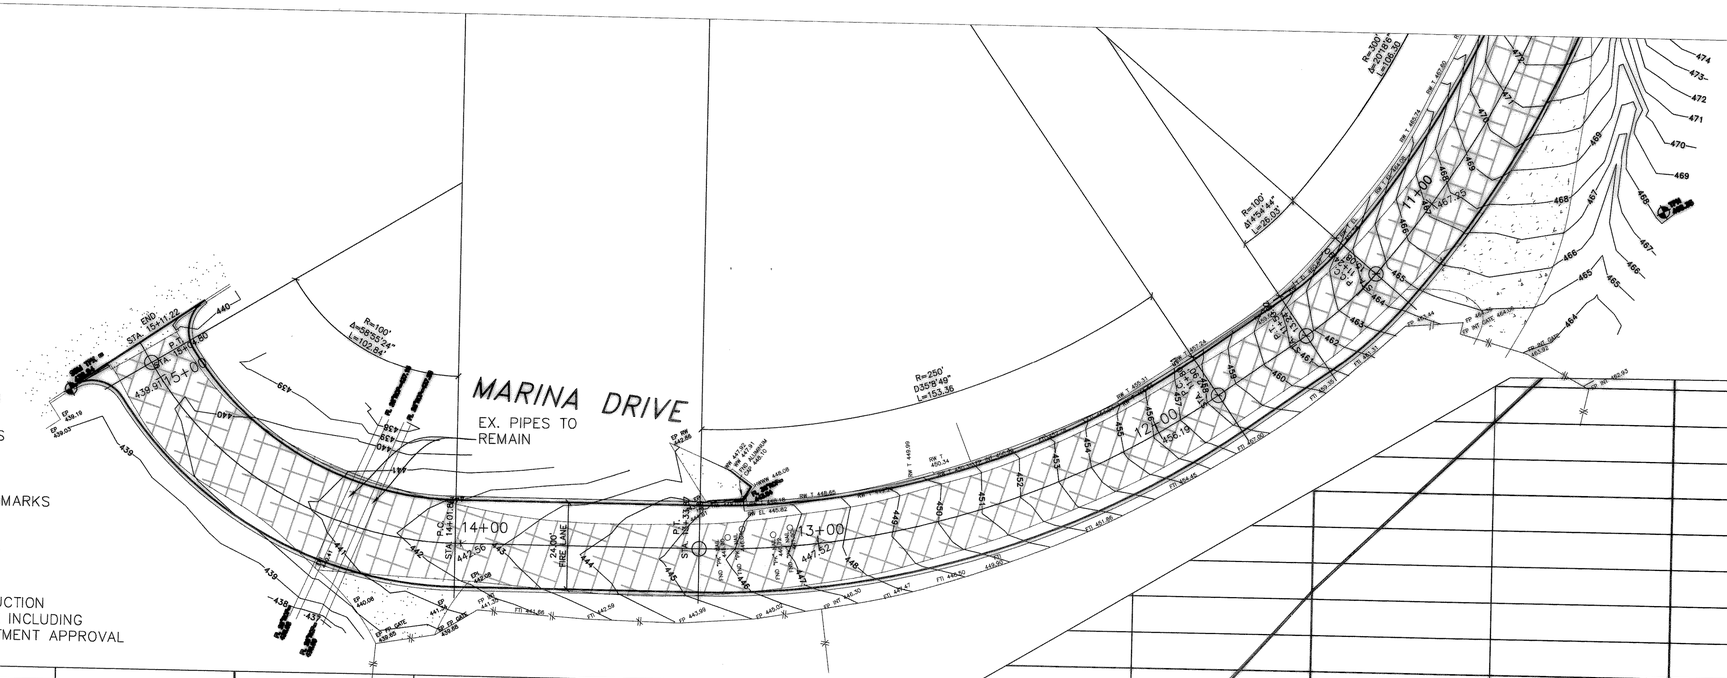


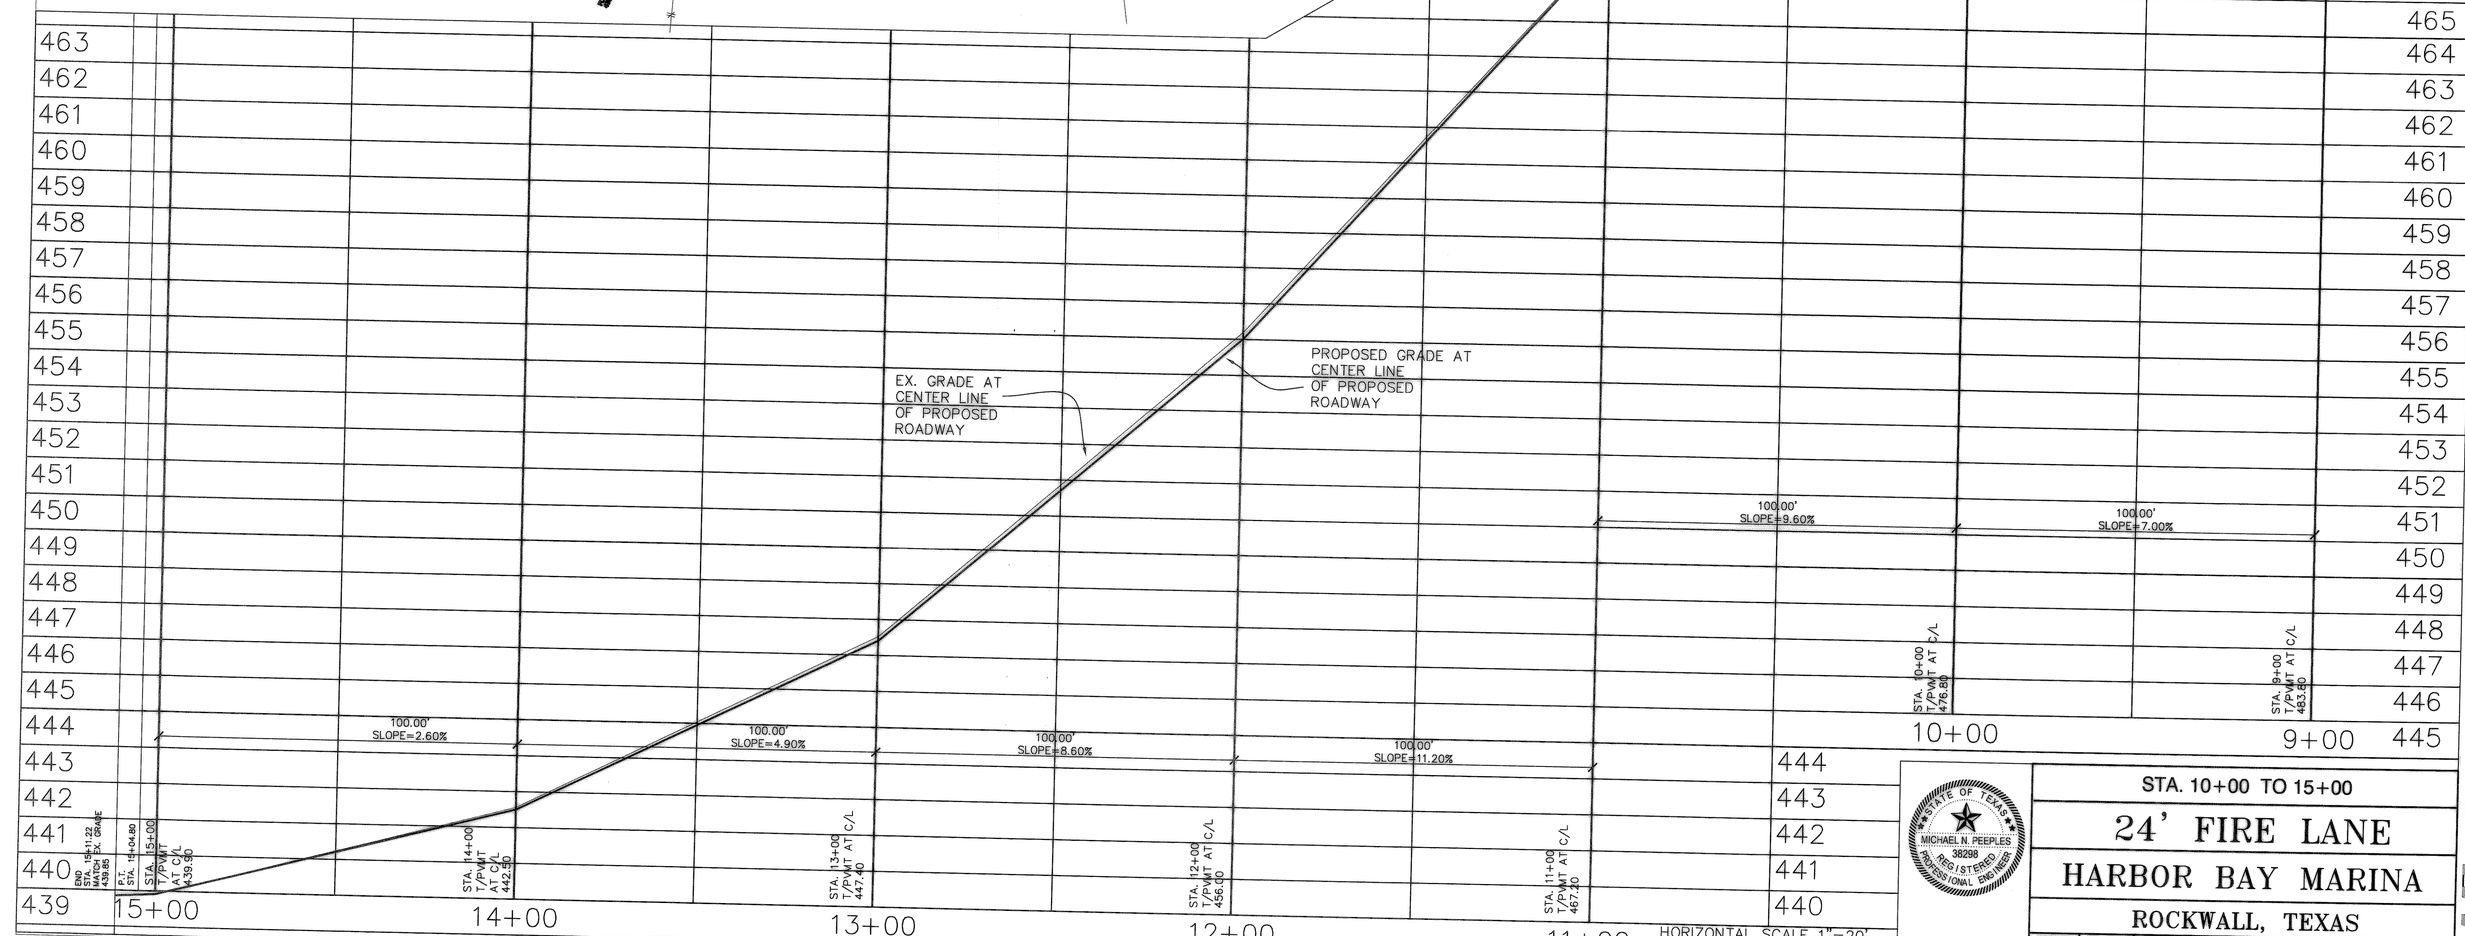


STATE OF TEXAS
MICHAEL N. PEEPLES
38298
REGISTERED PROFESSIONAL ENGINEER

STA. 10+00 TO 15+00

# 24' FIRE LANE

## HARBOR BAY MARINA

ROCKWALL, TEXAS

| DESIGN | DRAWN | DATE | SCALE | NOTES | FILE | NO. |
|---|---|---|---|---|---|---|
| MNP | MNP | 01/2007 | 1"=20' H | | | CE-3 |

RECORD DRAWING


MICHAEL PEEPLES
Engineers and Planners
1930 E. ROSEMEADE #205 - CARROLLTON, TX 75007
972-416-1968 (TEL) 214-731-9940 (FAX)
Texas Firm No. F-3754