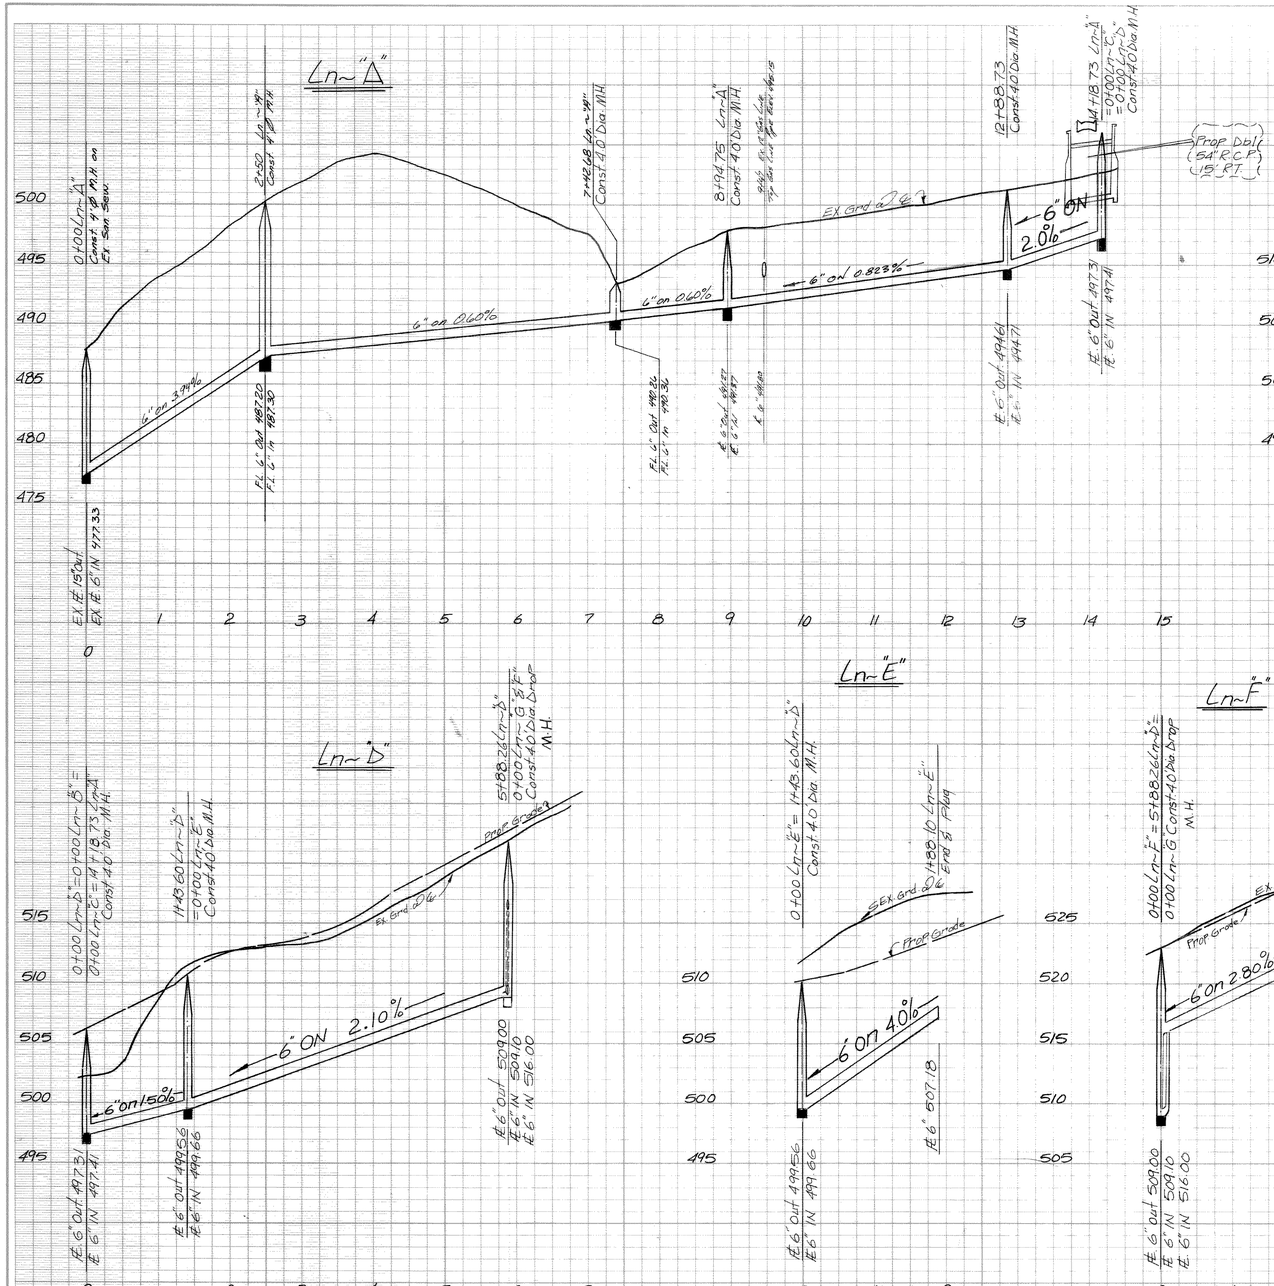

AS BUILT

10 OF 10

UTILITY PROFILES						
HARRIS HEIGHTS ADDITION PHASE ONE						
CITY OF ROCKWALL						
ROCKWALL COUNTY, TEXAS						
HAROLD L. EVANS ~ CONSULTING ENGINEER						
DESIGN	DRAWN	DATE	SCALE	NOTES	FILE	JOB NO.
DH	DH	12-11-83	1"=40'H 1"=6'V			83235