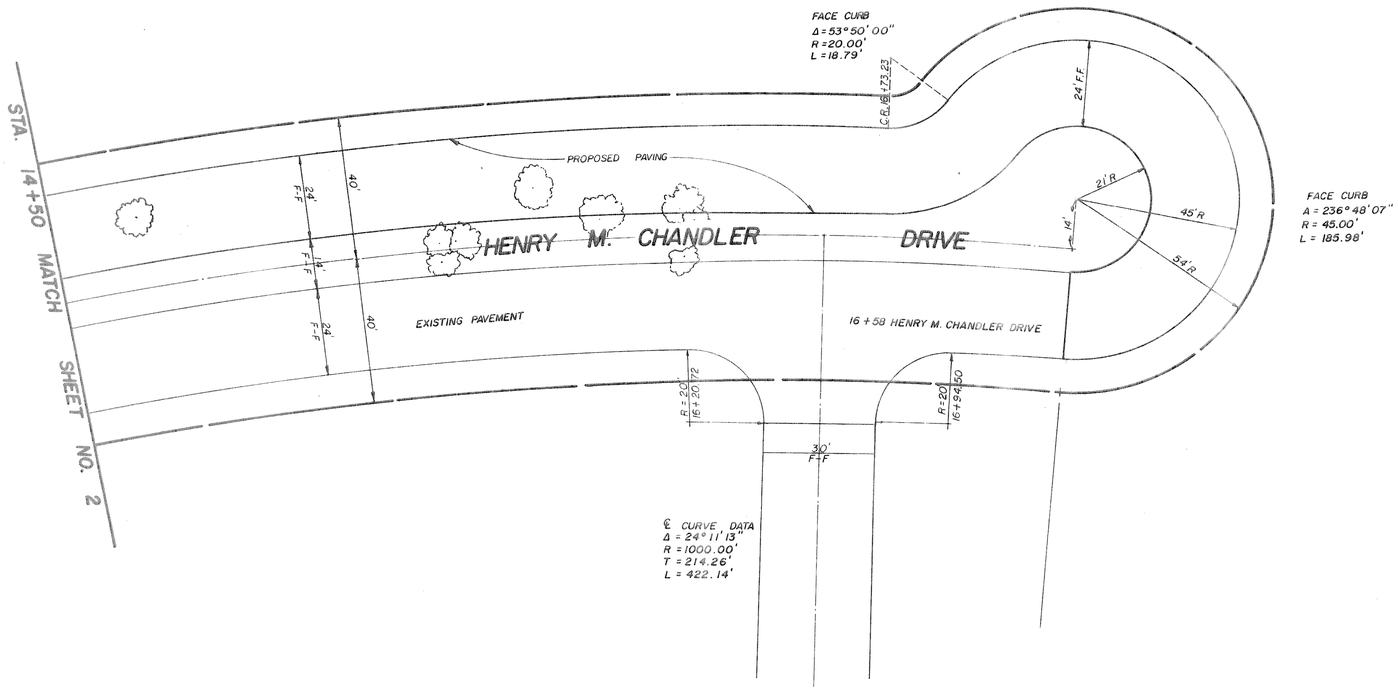


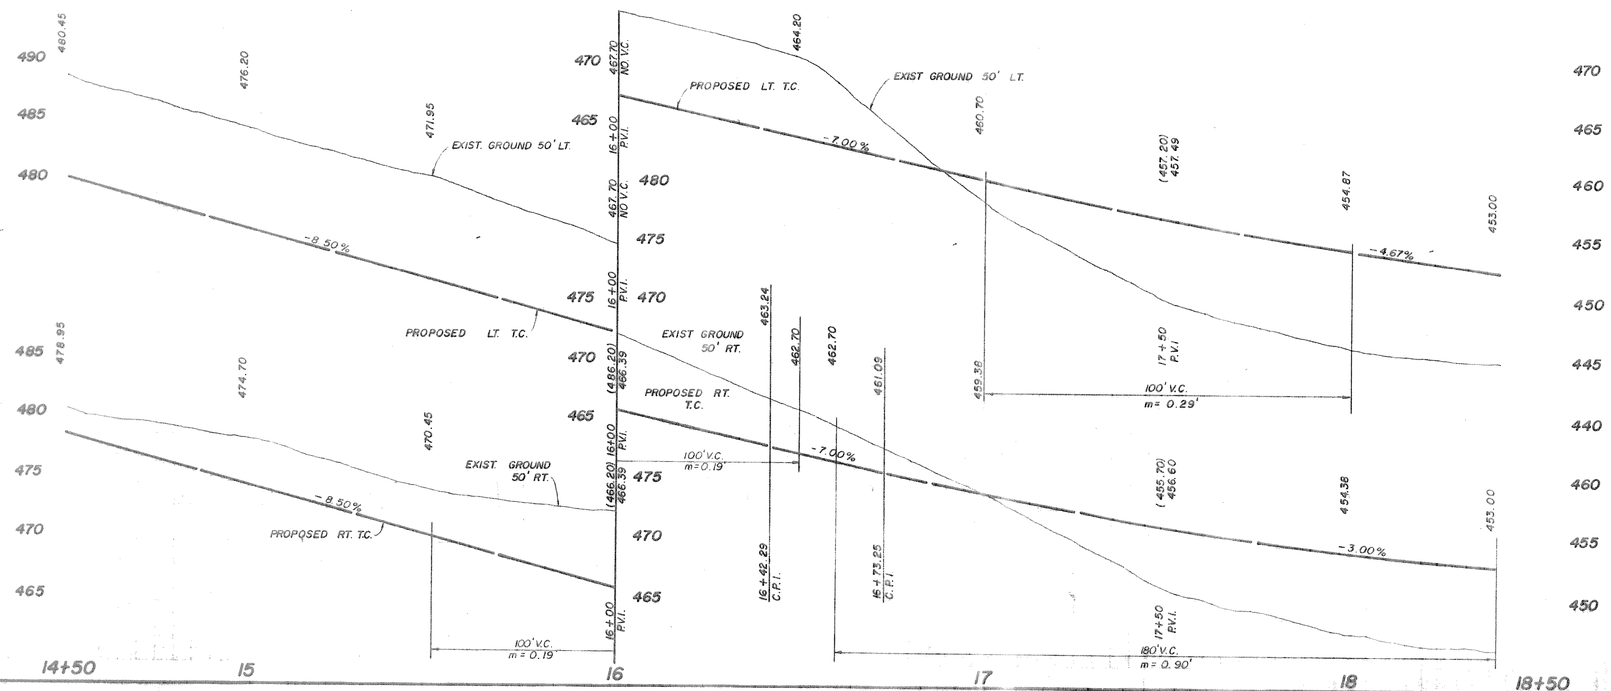


| | | | | | | |
|---|---|---|---|---|---|---|
| CHANDLERS LANDING | | | | | | |
| PROPOSED PAVING | | | | | | |
| HENRY M. CHANDLER DRIVE | | | | | | |
| ROCKWALL , TEXAS | | | | | | |
| HAROLD L. EVANS & CONSULTING ENGINEER | | | | | | |
| DESIGN | DRAWN | DATE | SCALE | NOTES | FILE | NO. |
| H.L.E. | | 2-73 | 1"=20' H. 1"=6' V. | | | 72122 |