


LOCATION MAP
NO SCALE

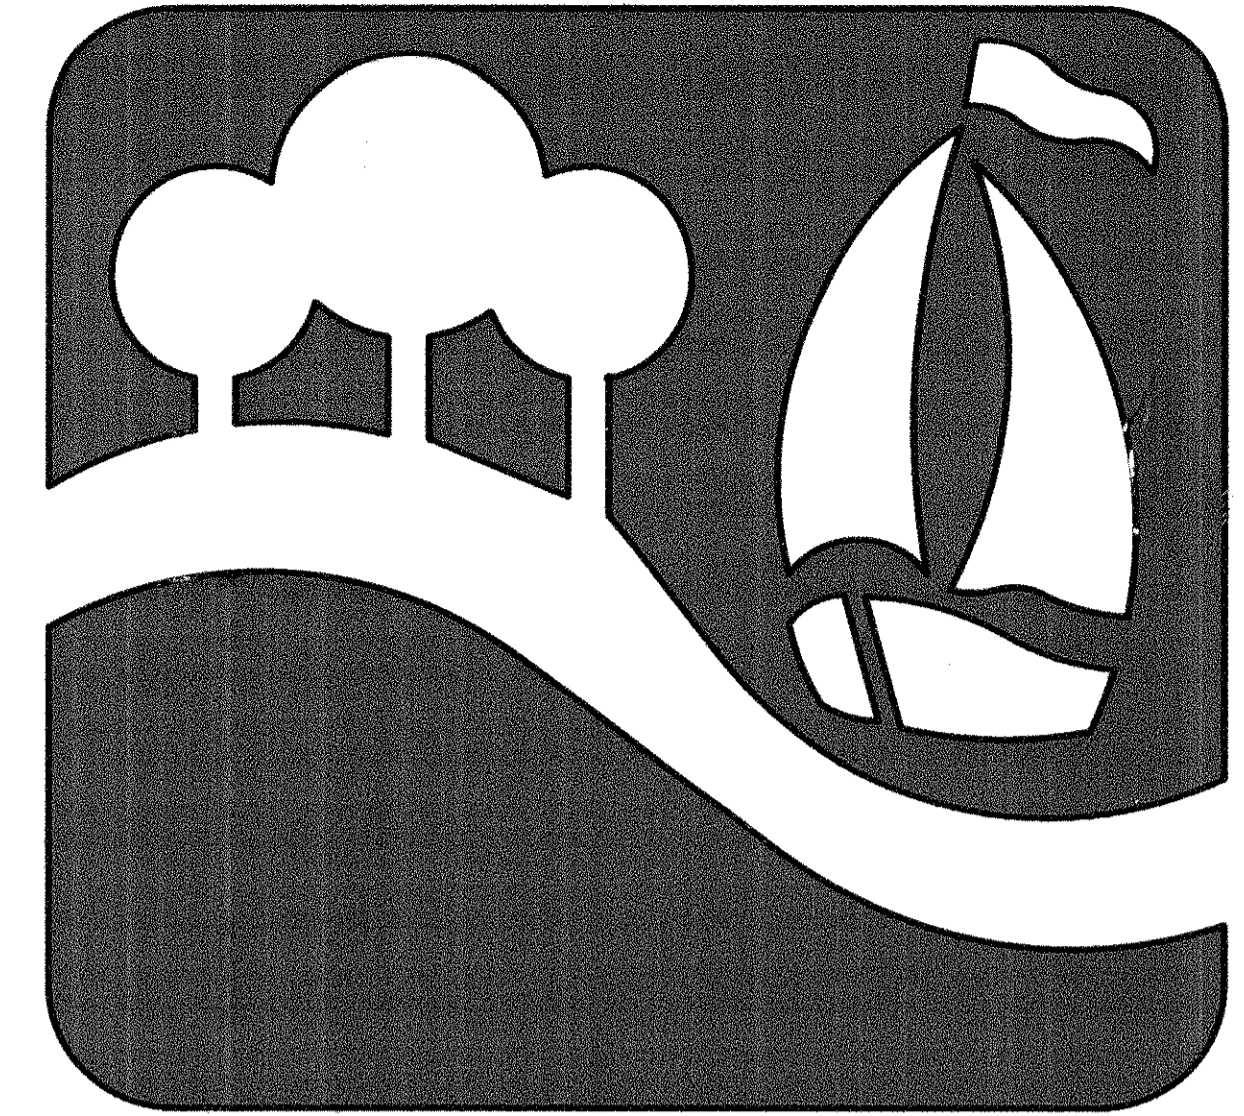

"THE NEW HORIZON"

SITE CONSTRUCTION PLANS

FOR

HIGHWAY 276 RETAIL

HIGHWAY 276 SELF STORAGE ADDITION


LOT 2R, BLOCK 1

IN THE


CITY OF ROCKWALL, TEXAS

SHEET INDEX

Sheet No.	Description
1	Cover Sheet
2	Replat
C1	Site Plan
C2	Grading Plan
C3	Drainage Area Map
C4	Sanitary Sewer Extension
C5	Sanitary Sewer Extension
C6	Utility Plan
C7	Erosion Control
C8	Typical Details & Notes
LSP	Landscape / Treescape Plan

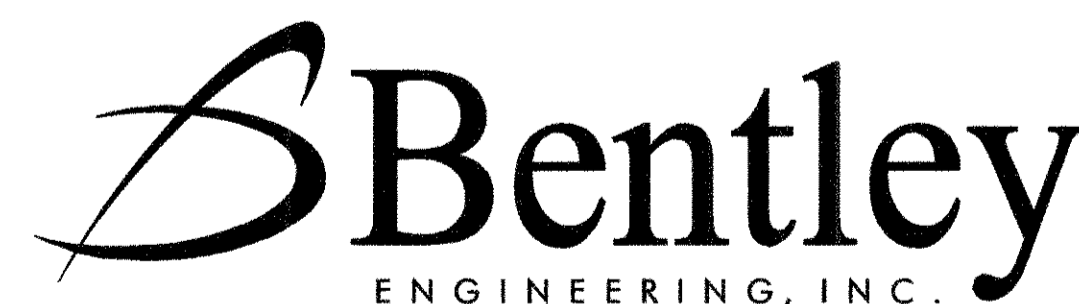

4125 BROADWAY BLVD.
SUITE A250
GARLAND, TEXAS 75043
PH. 972.240.4821
FAX. 972.240.0922

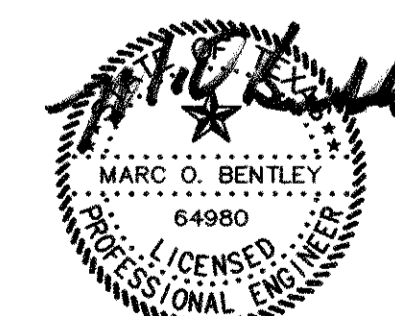

THE SEAL APPEARING ON THIS DOCUMENT WAS AUTHORIZED BY MARC O. BENTLEY, P.E. NO. 64980 ON 11/11/05

SEPTEMBER 2005

RECORD DRAWING

IMPROVEMENTS INDICATED ON THESE PLANS ARE BASED ON VISUAL OBSERVATION AND SURVEY WORK PERFORMED AT THE SITE BY BEI OR SURVEY SUBCONTRACTOR.
DATE: DECEMBER 19, 2008

HIGHWAY 276 RETAIL 25143

RECORD DRAWING