


**BENCHMARKS:**  
 "X" cut in concrete on the center line of Sunset Hill, Paving Sta. +0+10 Elev. 452.96  
 "Y" cut in concrete on the center line intersection of North Lake Shore Dr. with North Hill's Drive. Elev. 515.64

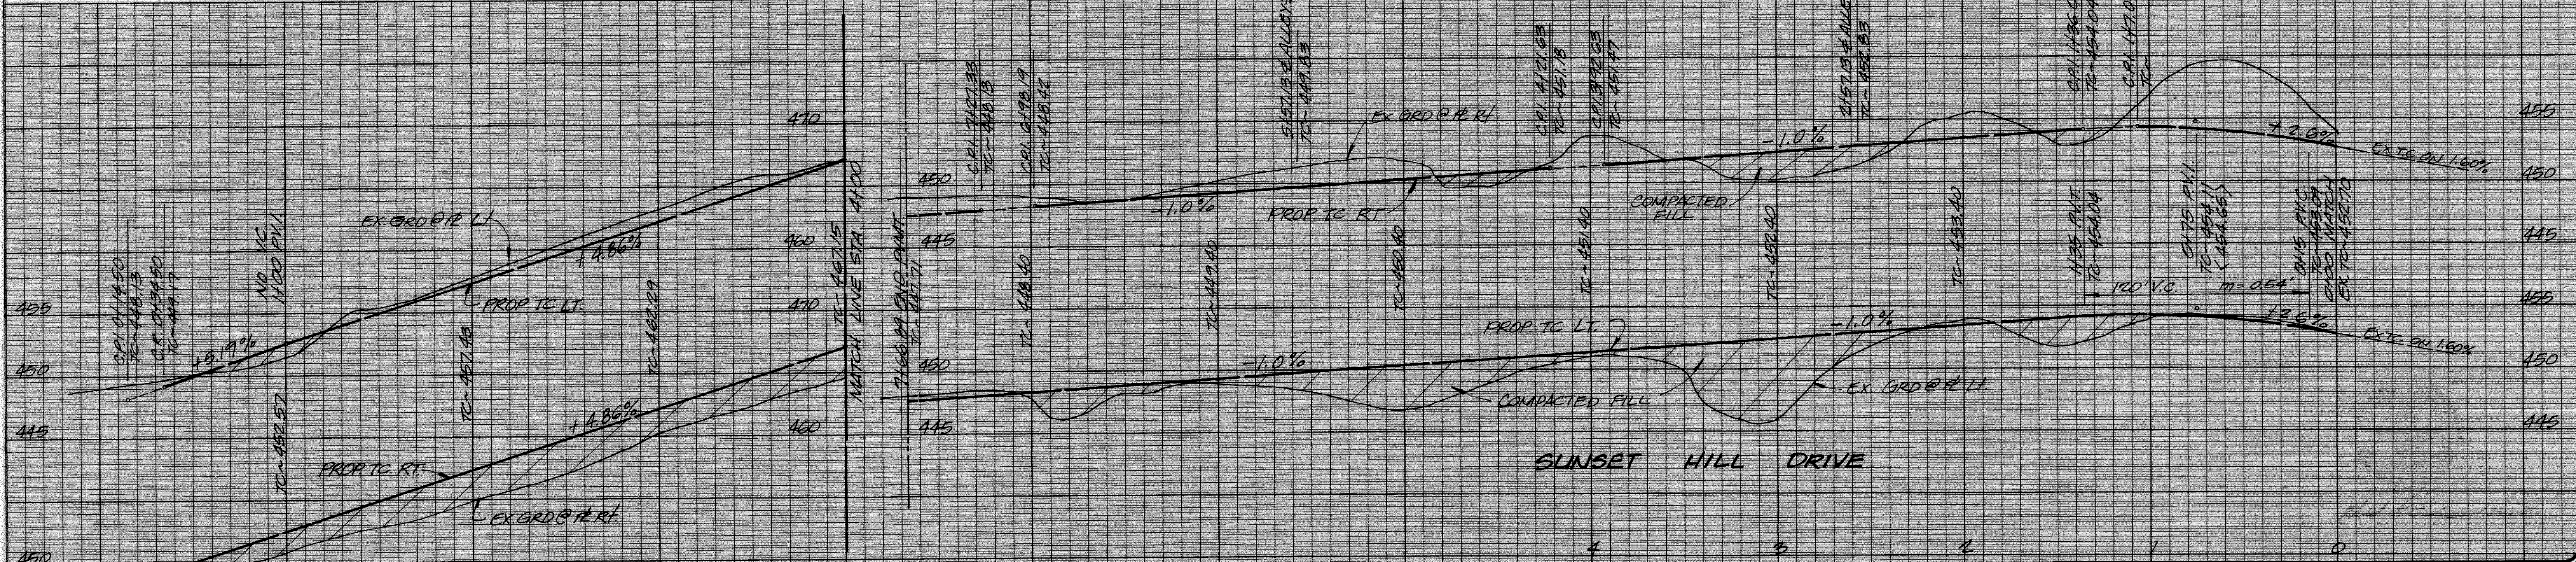

Revised Inlets @ Lakeway Dr. & Sunset Hill Dr. 1-20-94		<b>HAROLD L. EVANS &amp; ASSOCIATES</b> Consulting Engineers P. O. Box 28355 2331 Gus Thomasson Road, Suite 102 Dallas, Texas 75228 (214) 328-8133		<b>PAVING PLANS</b> <b>SUNSET HILL DR. &amp; LAKEWAY DR.</b> <b>HILLCREST SHORES</b> <b>ROCKWALL, ROCKWALL COUNTY, TEXAS</b>		<b>SHEET NO.</b> <b>3</b> <b>18</b>	
<b>REVISION DESCRIPTION</b>		<b>DATE</b> JULY 1993	<b>SCALE</b> 1" = 40' H & V	<b>DESIGN</b> H.L.E.	<b>DRAWN</b> PN	<b>JOB NO.</b> 9923	