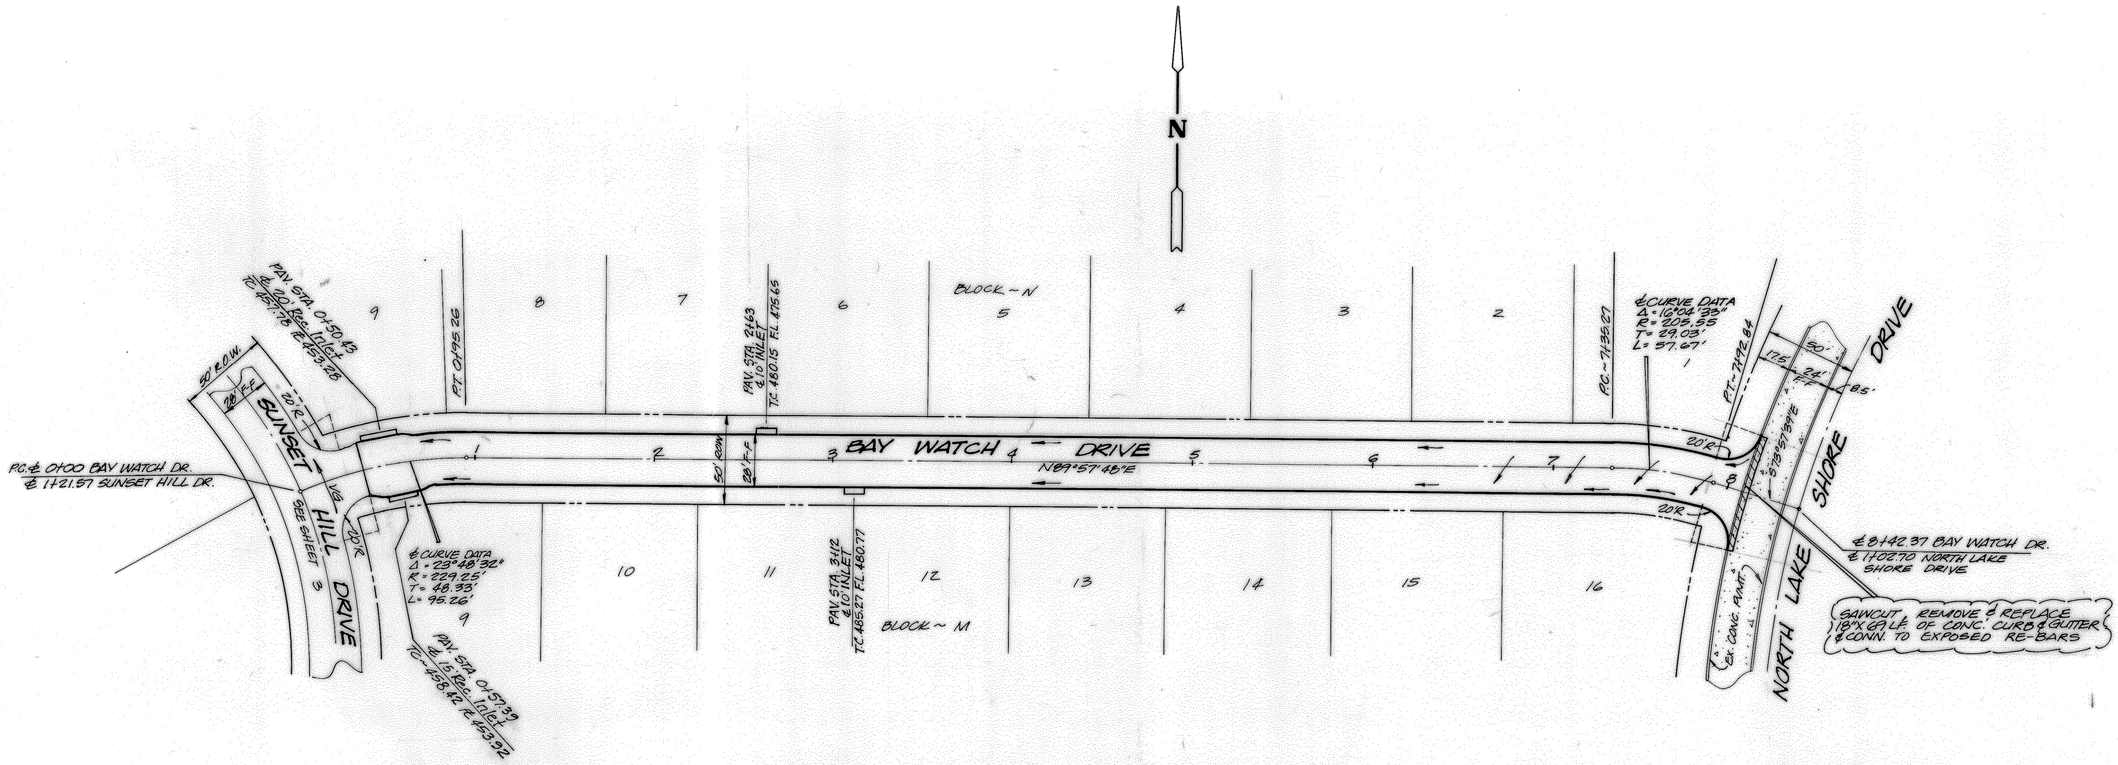

AS-BUILT

BENCHMARKS:
"X" cut in concrete on the center line of Sunset Hill, Paving Sta. -0+10 Elev. 462.96

"X" cut in concrete on the center line intersection of North Lake-Shore Dr. with North Hills Drive. Elev. 515.64

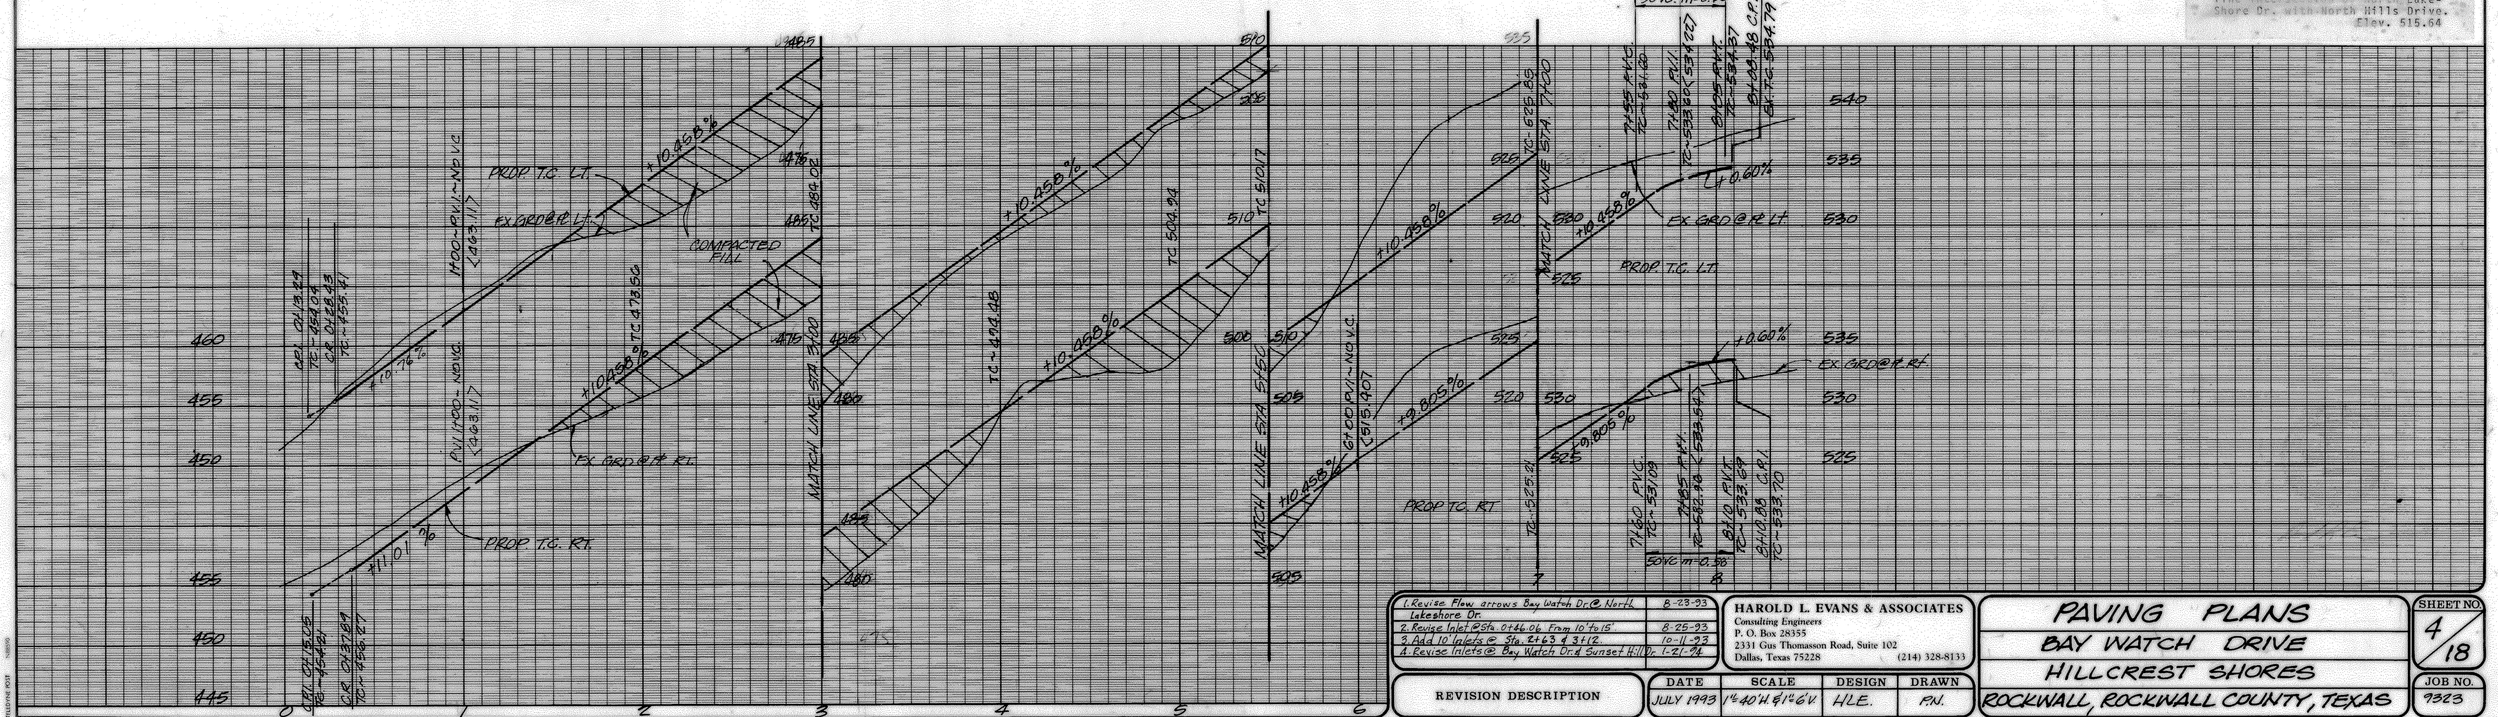

REVISION DESCRIPTION	DATE
1. Revise Flow arrows Bay Watch Dr. @ North Lakeshore Dr.	8-25-93
2. Revise Inlet Sta. 0+46.06 From 10'x15'	8-26-93
3. Add 10' Inlets @ Sta. 2+63 & 3+12	10-11-93
4. Revise Inlets @ Bay Watch Dr. & Sunset Hill	1-21-94

HAROLD L. EVANS & ASSOCIATES
Consulting Engineers
P. O. Box 28355
2331 Gus Thomasson Road, Suite 102
Dallas, Texas 75228
(214) 328-8133

DATE	SCALE	DESIGN	DRAWN
JULY 1993	1"=40'H & 1"=6'V	H.L.E.	P.N.

PAVING PLANS
BAY WATCH DRIVE
HILLCREST SHORES
ROCKWALL, ROCKWALL COUNTY, TEXAS

SHEET NO. 4/18

JOB NO. 9323