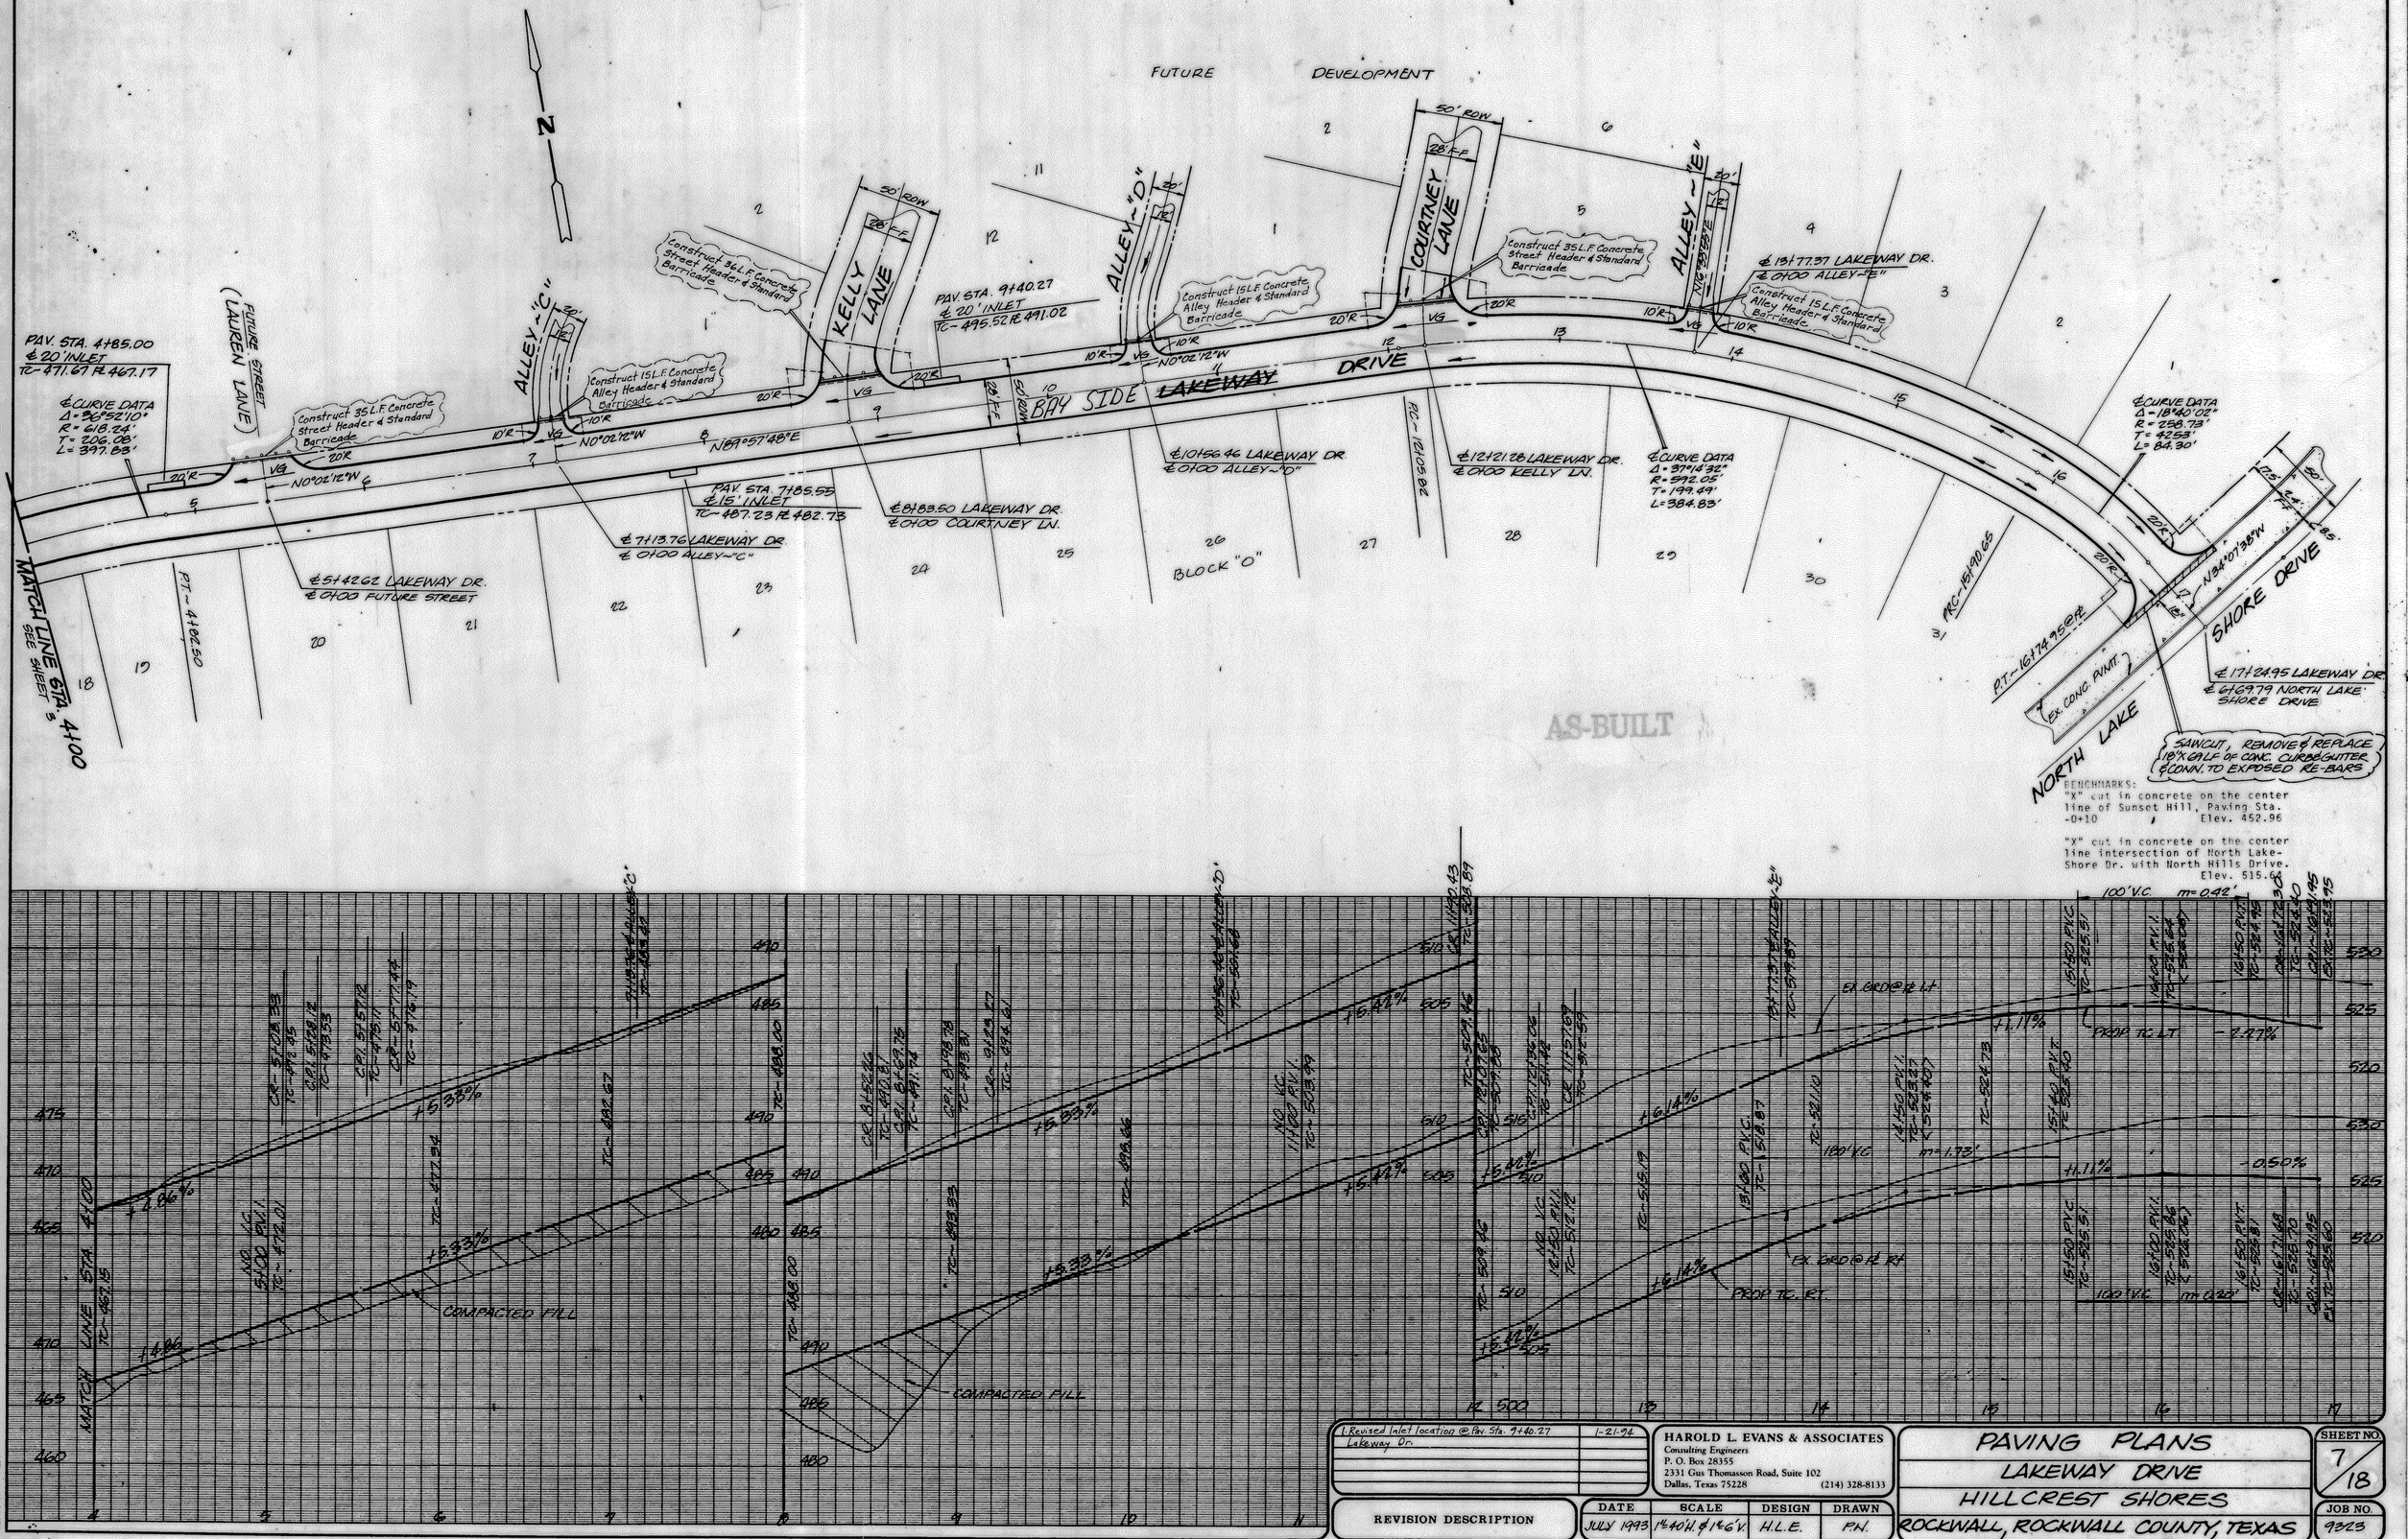

REVISION DESCRIPTION	DATE	SCALE	DESIGN	DRAWN
1. Revised Inlet location @ Pav. Sta. 7+40.27 Lakeway Dr. — 1-21-94	JULY 1993	1"=40'H & 1"=6'V.	H.L.E.	P.H.

HAROLD L. EVANS & ASSOCIATES
Consulting Engineers
P. O. Box 28355
2331 Gus Thomasson Road, Suite 102
Dallas, Texas 75228 (214) 328-8133

PAVING PLANS
LAKEWAY DRIVE
HILLCREST SHORES
ROCKWALL, ROCKWALL COUNTY, TEXAS

SHEET NO. 7/18
JOB NO. 9323