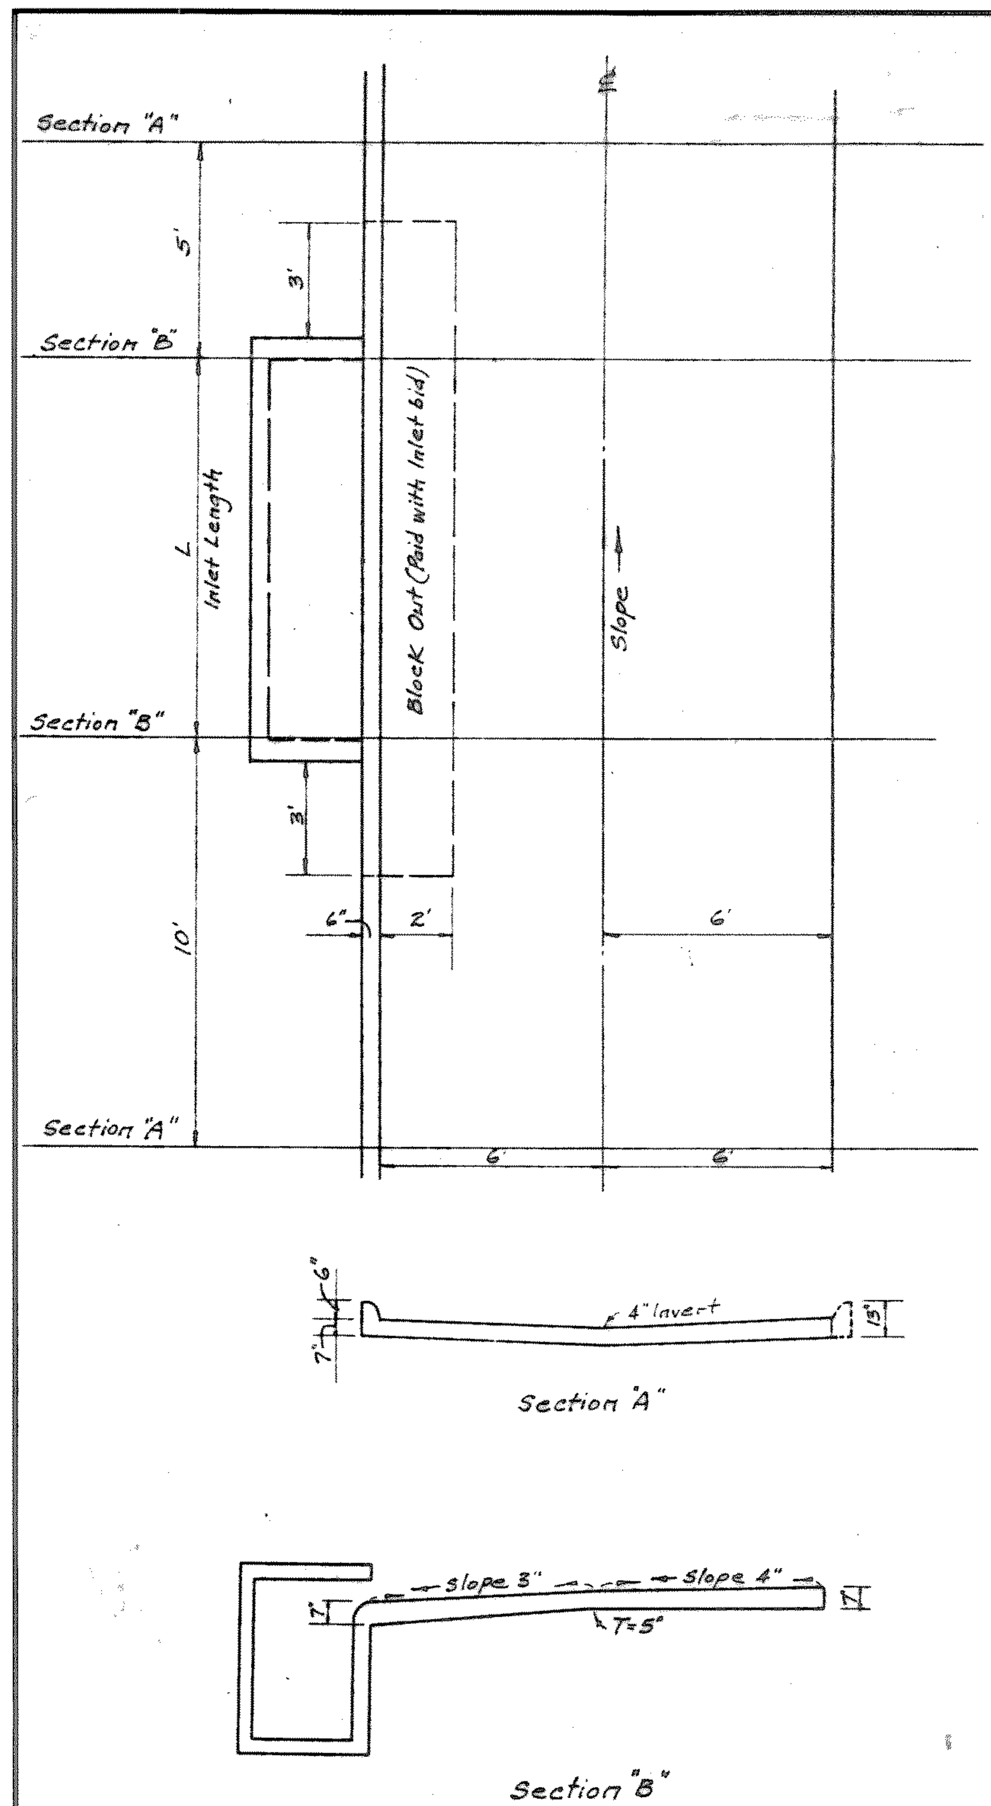

TYPICAL ALLEY INLET SECTIONS

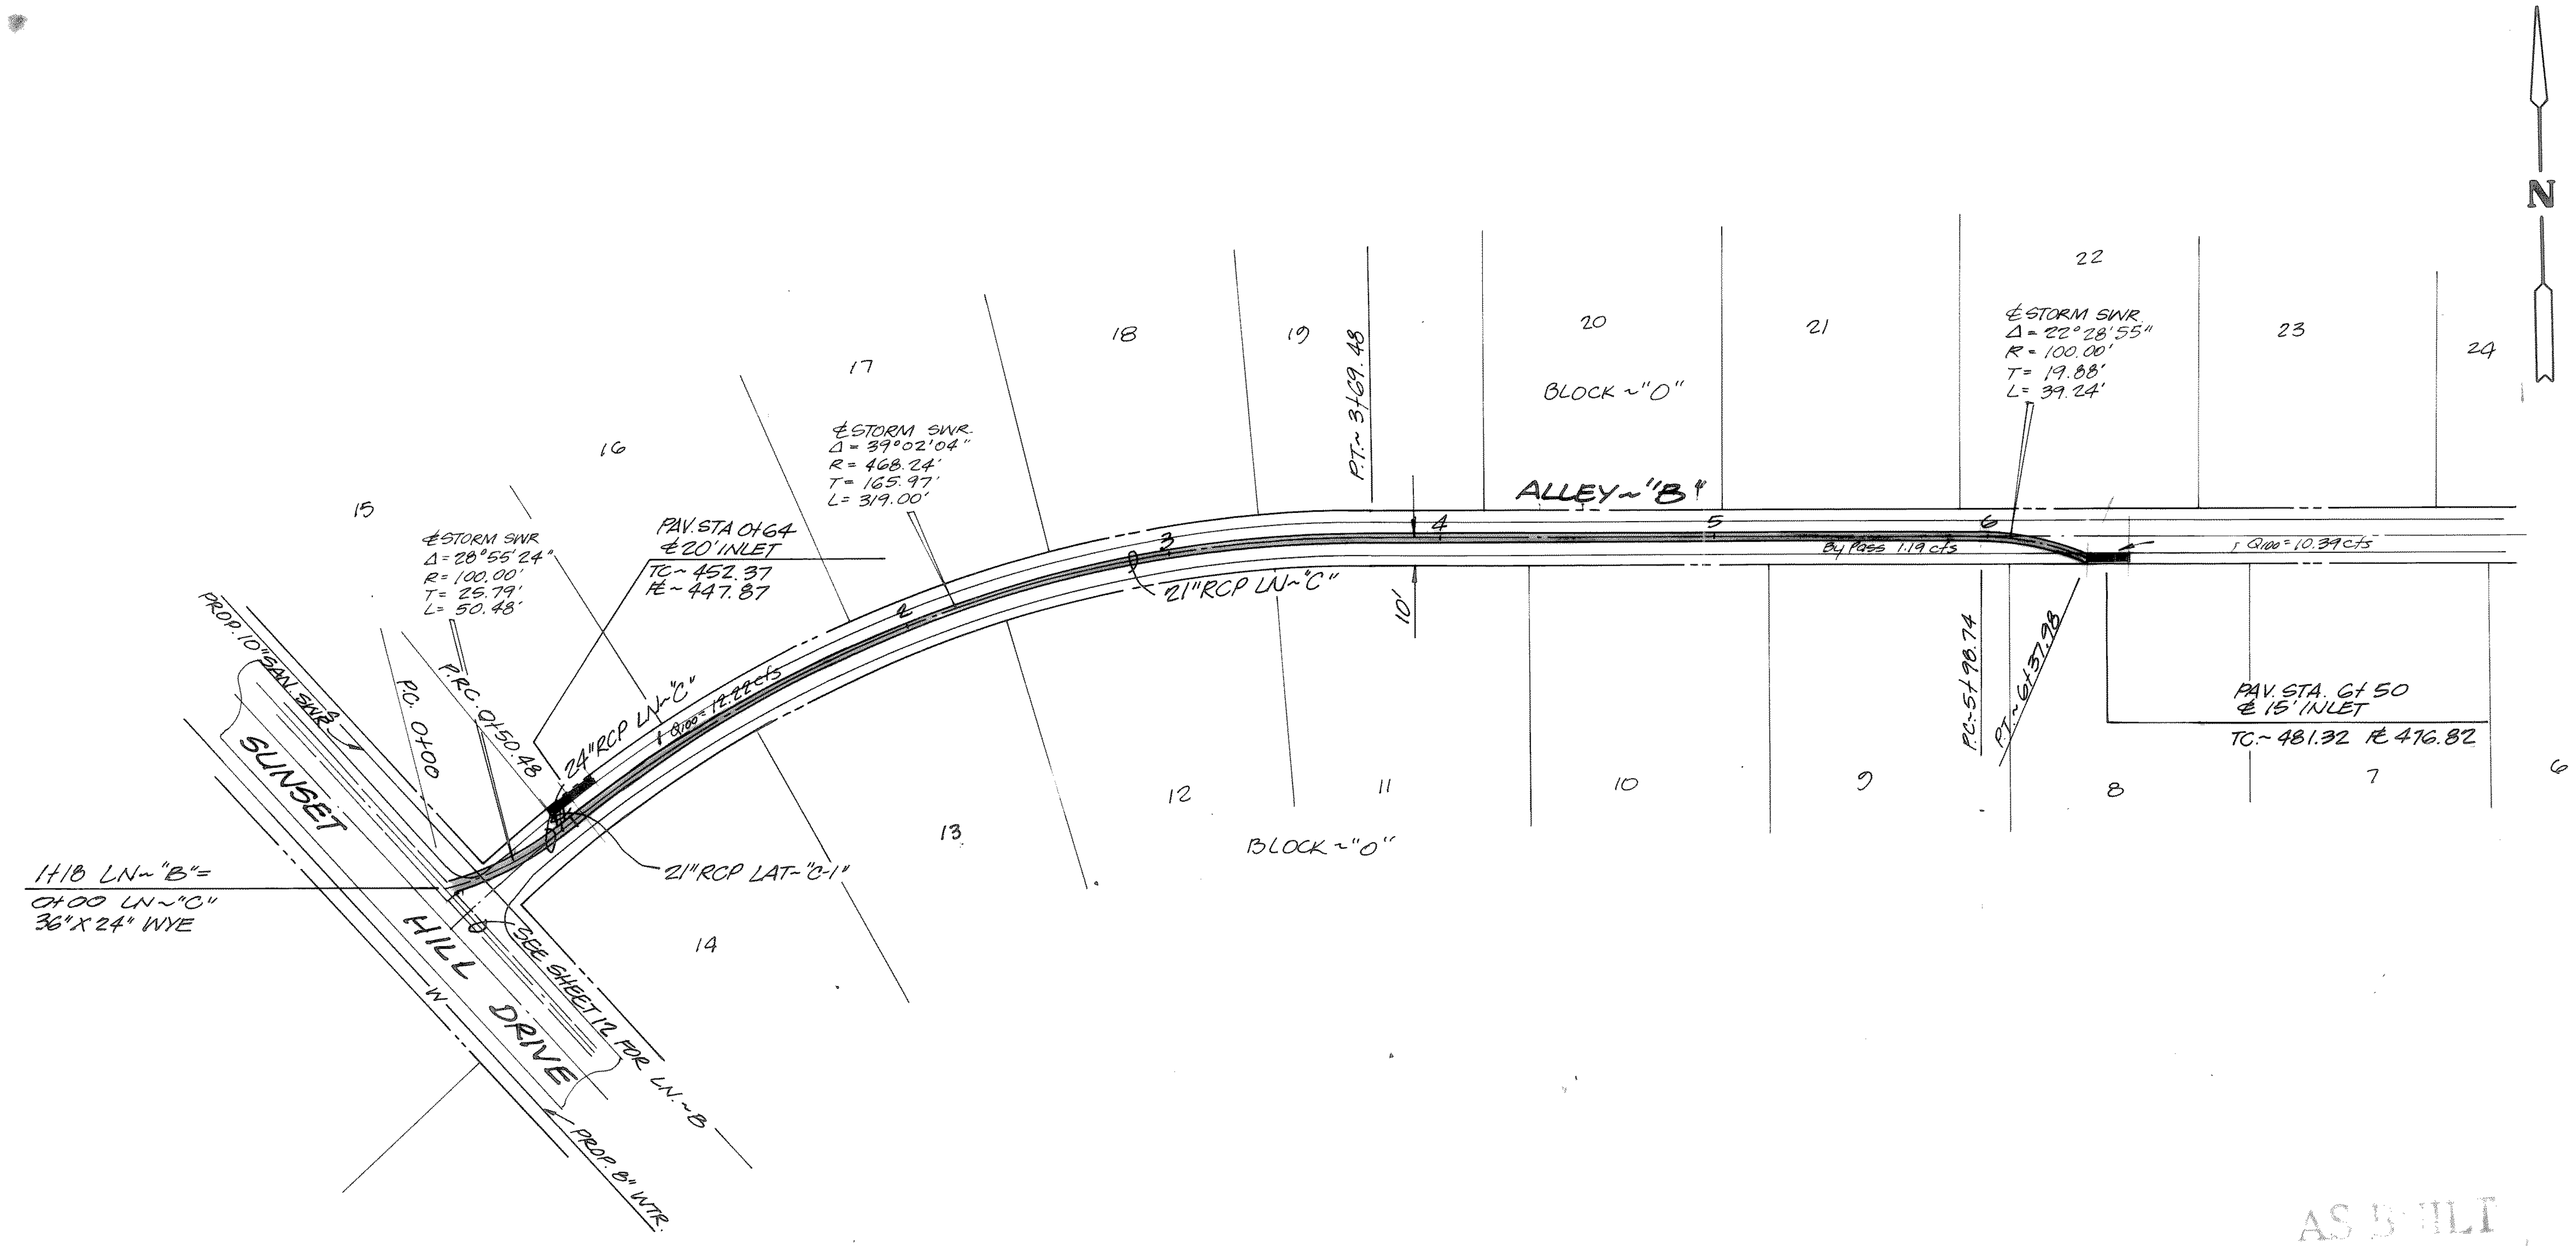

AS BUILT

BENCHMARKS:
"X" cut in concrete on the center line of Sunset Hill, Paving Sta. -0+10 Elev. 452.96

"X" cut in concrete on the center line intersection of North Lake-Shore Dr. with North Hills Drive. Elev. 515.64

REVISION DESCRIPTION		

HAROLD L. EVANS & ASSOCIATES
Consulting Engineers
P. O. Box 28355
2331 Gus Thomasson Road, Suite 102
Dallas, Texas 75228 (214) 328-8133

DATE	SCALE	DESIGN	DRAWN
JULY 1993	1"=40'H. & 1"=6'V.	HLE	PN

STORM SEWER PLAN
LINE~"C" & LAT.~"C-1"
HILLCREST SHORES
ROCKWALL, ROCKWALL COUNTY, TEXAS

SHEET NO. 14/18

JOB NO. 9323

TELEDYNE POST N8590