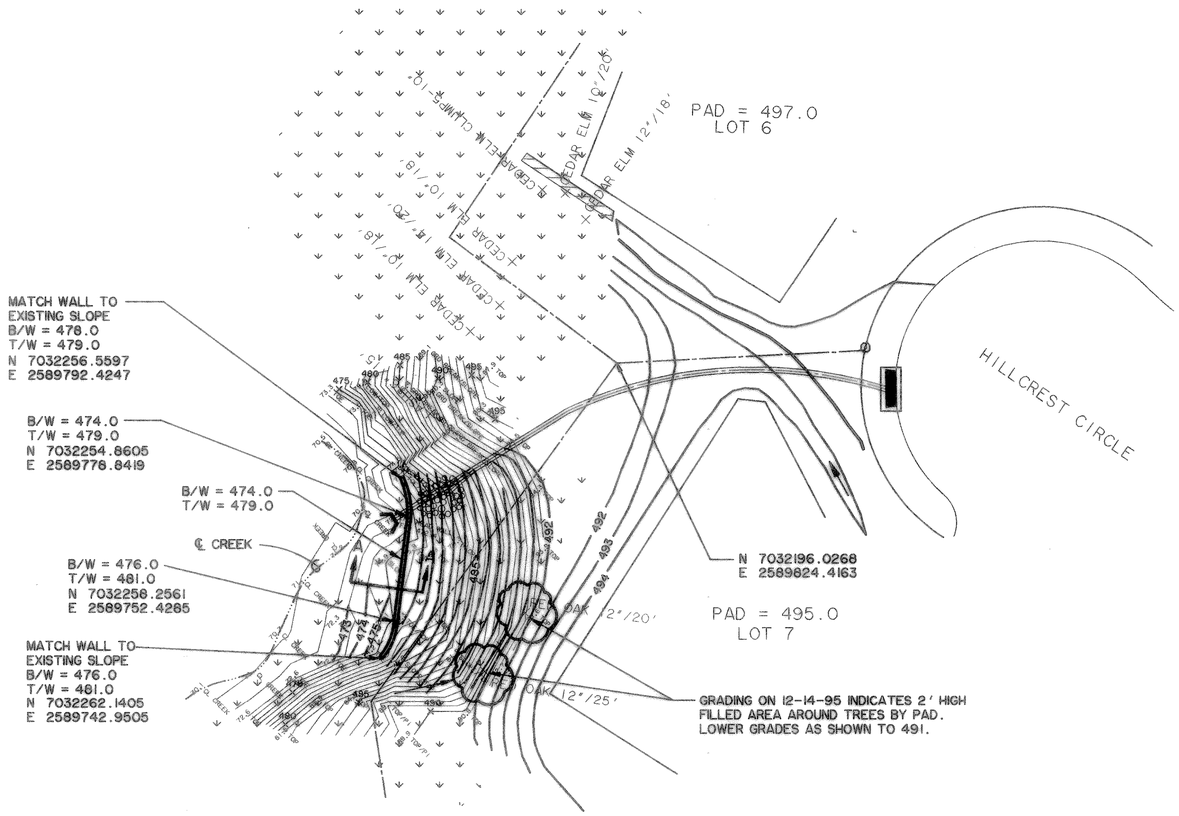

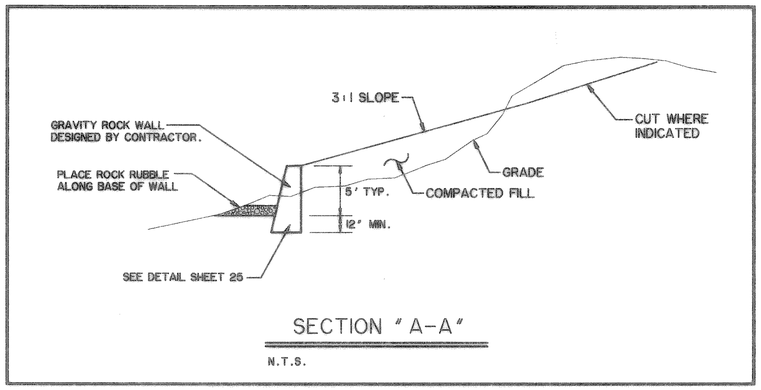

SECTION "A-A"

N.T.S.

PREPARED BY:
WIER & ASSOCIATES, INC.
ENGINEERS SURVEYORS LAND PLANNERS
4300 BELTWAY PLACE SUITE 130 ARLINGTON, TEXAS 76018 METRO (817)467-7700
3908 SOUTH FREEWAY FORT WORTH, TEXAS 76110 (817)926-0212

HILLCREST SHORES
PHASE II
CITY OF ROCKWALL,
ROCKWALL COUNTY, TEXAS

RETAINING WALL EXHIBIT

STATE OF TEXAS
ULYS LANE III
40864
REGISTERED
PROFESSIONAL ENGINEER
12/15/95

COPYRIGHT © WIER & ASSOCIATES, INC.

LAST SHEET EDIT
DATE 12-15-95
FILE EXHWALL
WA# 93065

SHEET NO.
37

RECORD PLANS
2-13-96