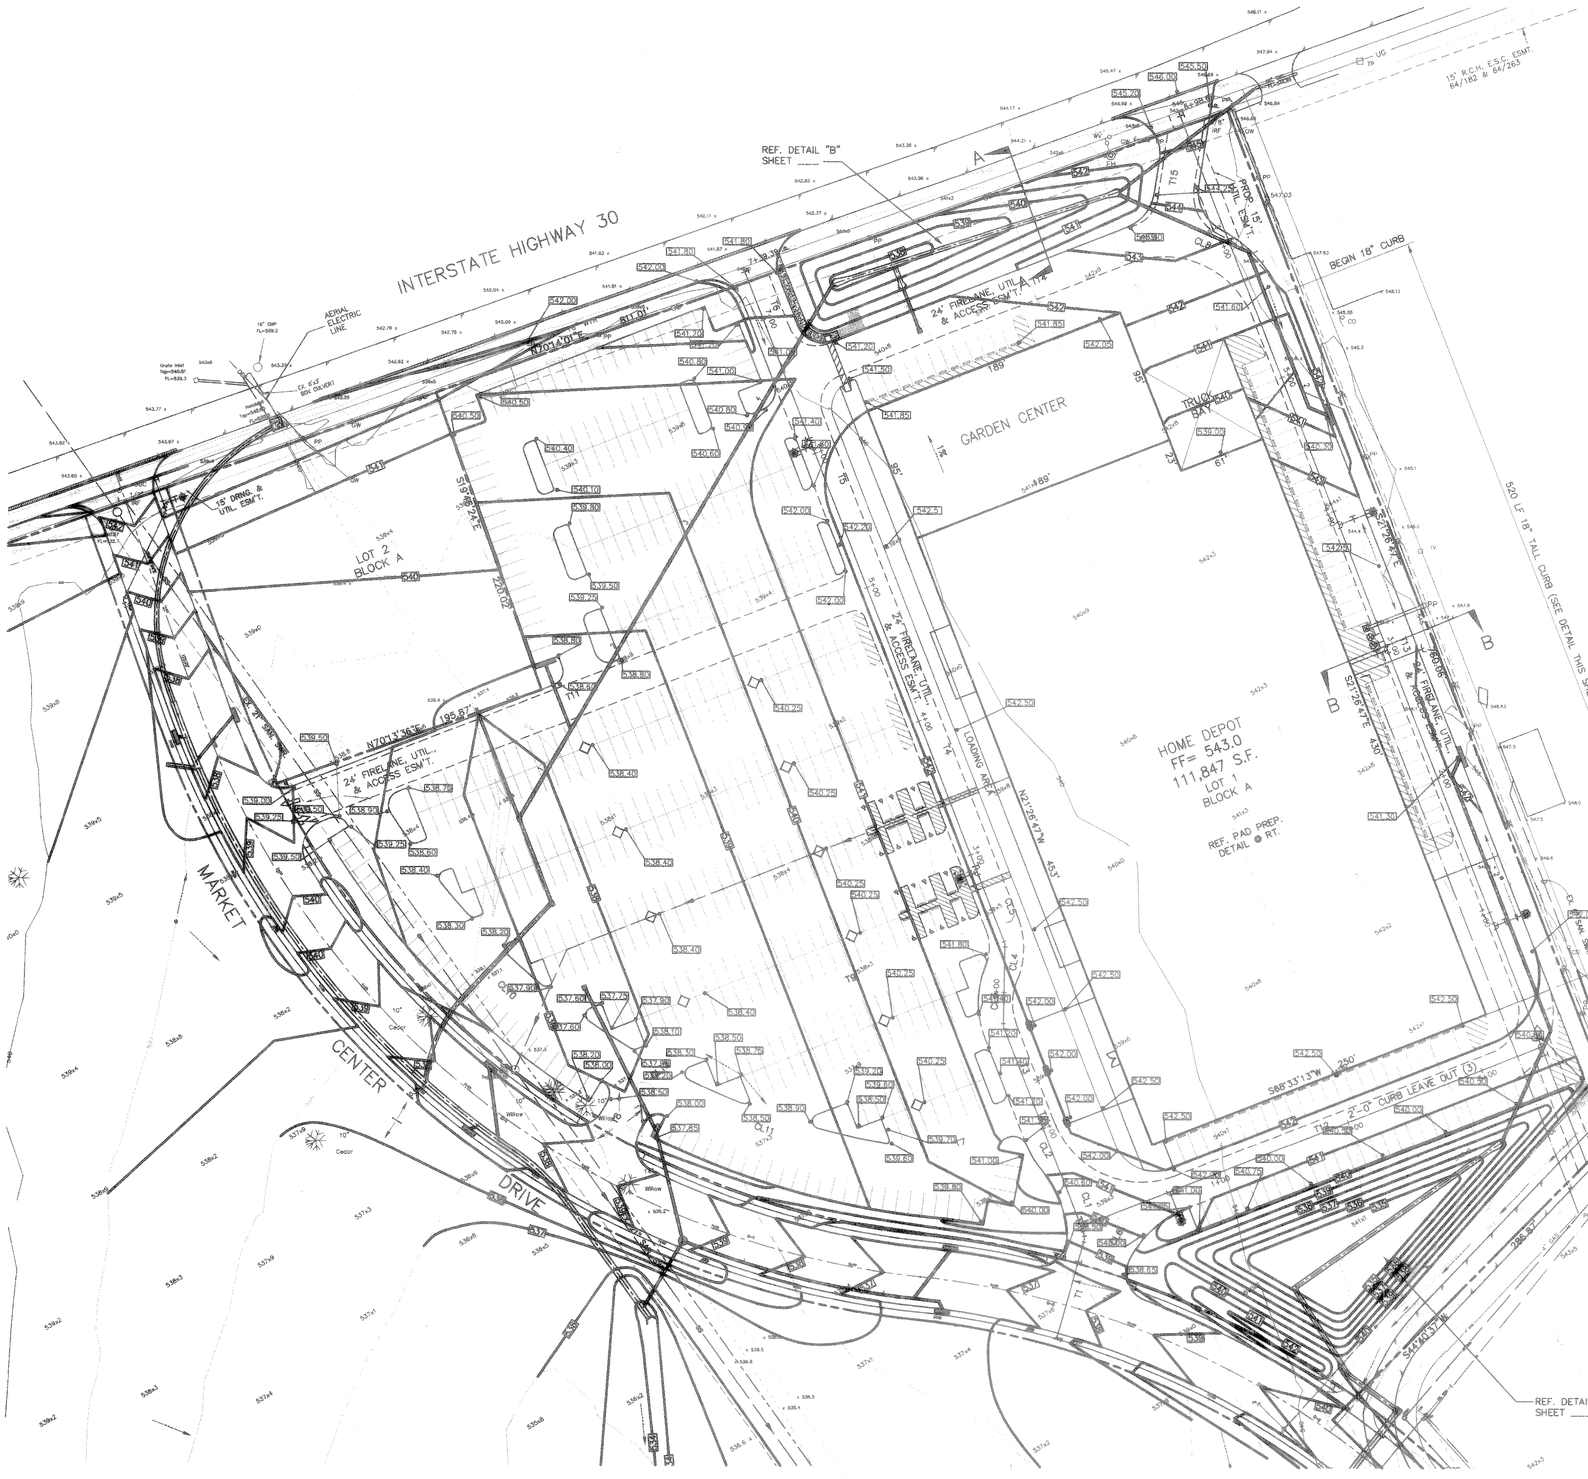

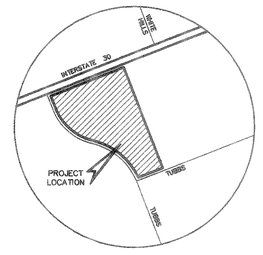

LOCATION MAP
MAPSCO PAGE 30C-G

LOCATION MAP
N.T.S.

ASBUILT

Winkelmann & Associates, Inc. hereby states that this plan, to the best of our knowledge is "As Built." Modifications from the originally approved construction documents have been made as per information provided by the contractor. Winkelmann & Associates, Inc. does not certify as to the correctness or quality of construction as no field inspection was performed.

WINKELMANN & ASSOCIATES, INC. — DATE 5-13-98

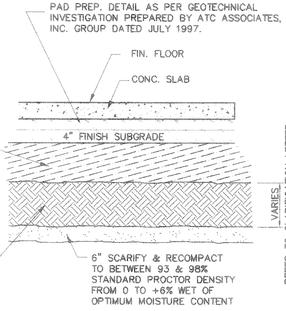

BUILDING PAD PREP. DETAIL

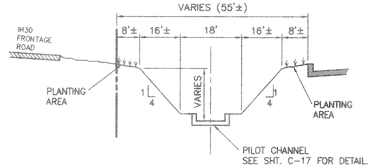

SECTION A-A

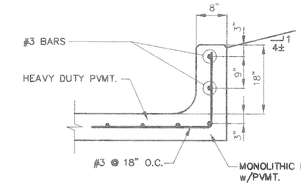

18" CURB DETAIL
SECTION B-B

No.	DATE	REVISION	APPROV.

Winkelmann & Associates, Inc.
CONSULTING CIVIL ENGINEERS ■ SURVEYORS
12850 HILLCREST ROAD, SUITE 250
DALLAS, TEXAS 75230
(972) 490-7900
(972) 490-7999 FAX

STATE OF TEXAS
MICHAEL B. CLARK
63280
REGISTERED
PROFESSIONAL ENGINEER

E.P. GAINES CHISUM SURVEY, ABST. No. 64
CITY OF ROCKWALL
ROCKWALL COUNTY, TEXAS

HOME DEPOT, U.S.A., INC.
2800 FOREST LANE
DALLAS, TEXAS 75229

GRADING PLAN
HOME DEPOT - ROCKWALL

Scale: 1" = 50'	Date: 5/22/97
Designed By: M.D.C.	
Drawn By: R.D.L.	
Checked By: M.D.C.	
File: 07939GRD.DWG	
Project No.: 07939.01(20)	

SHEET C-5 OF

C:\GEO\DWGS\07939grd Tue Dec 23 14:25:41 1997 RDL