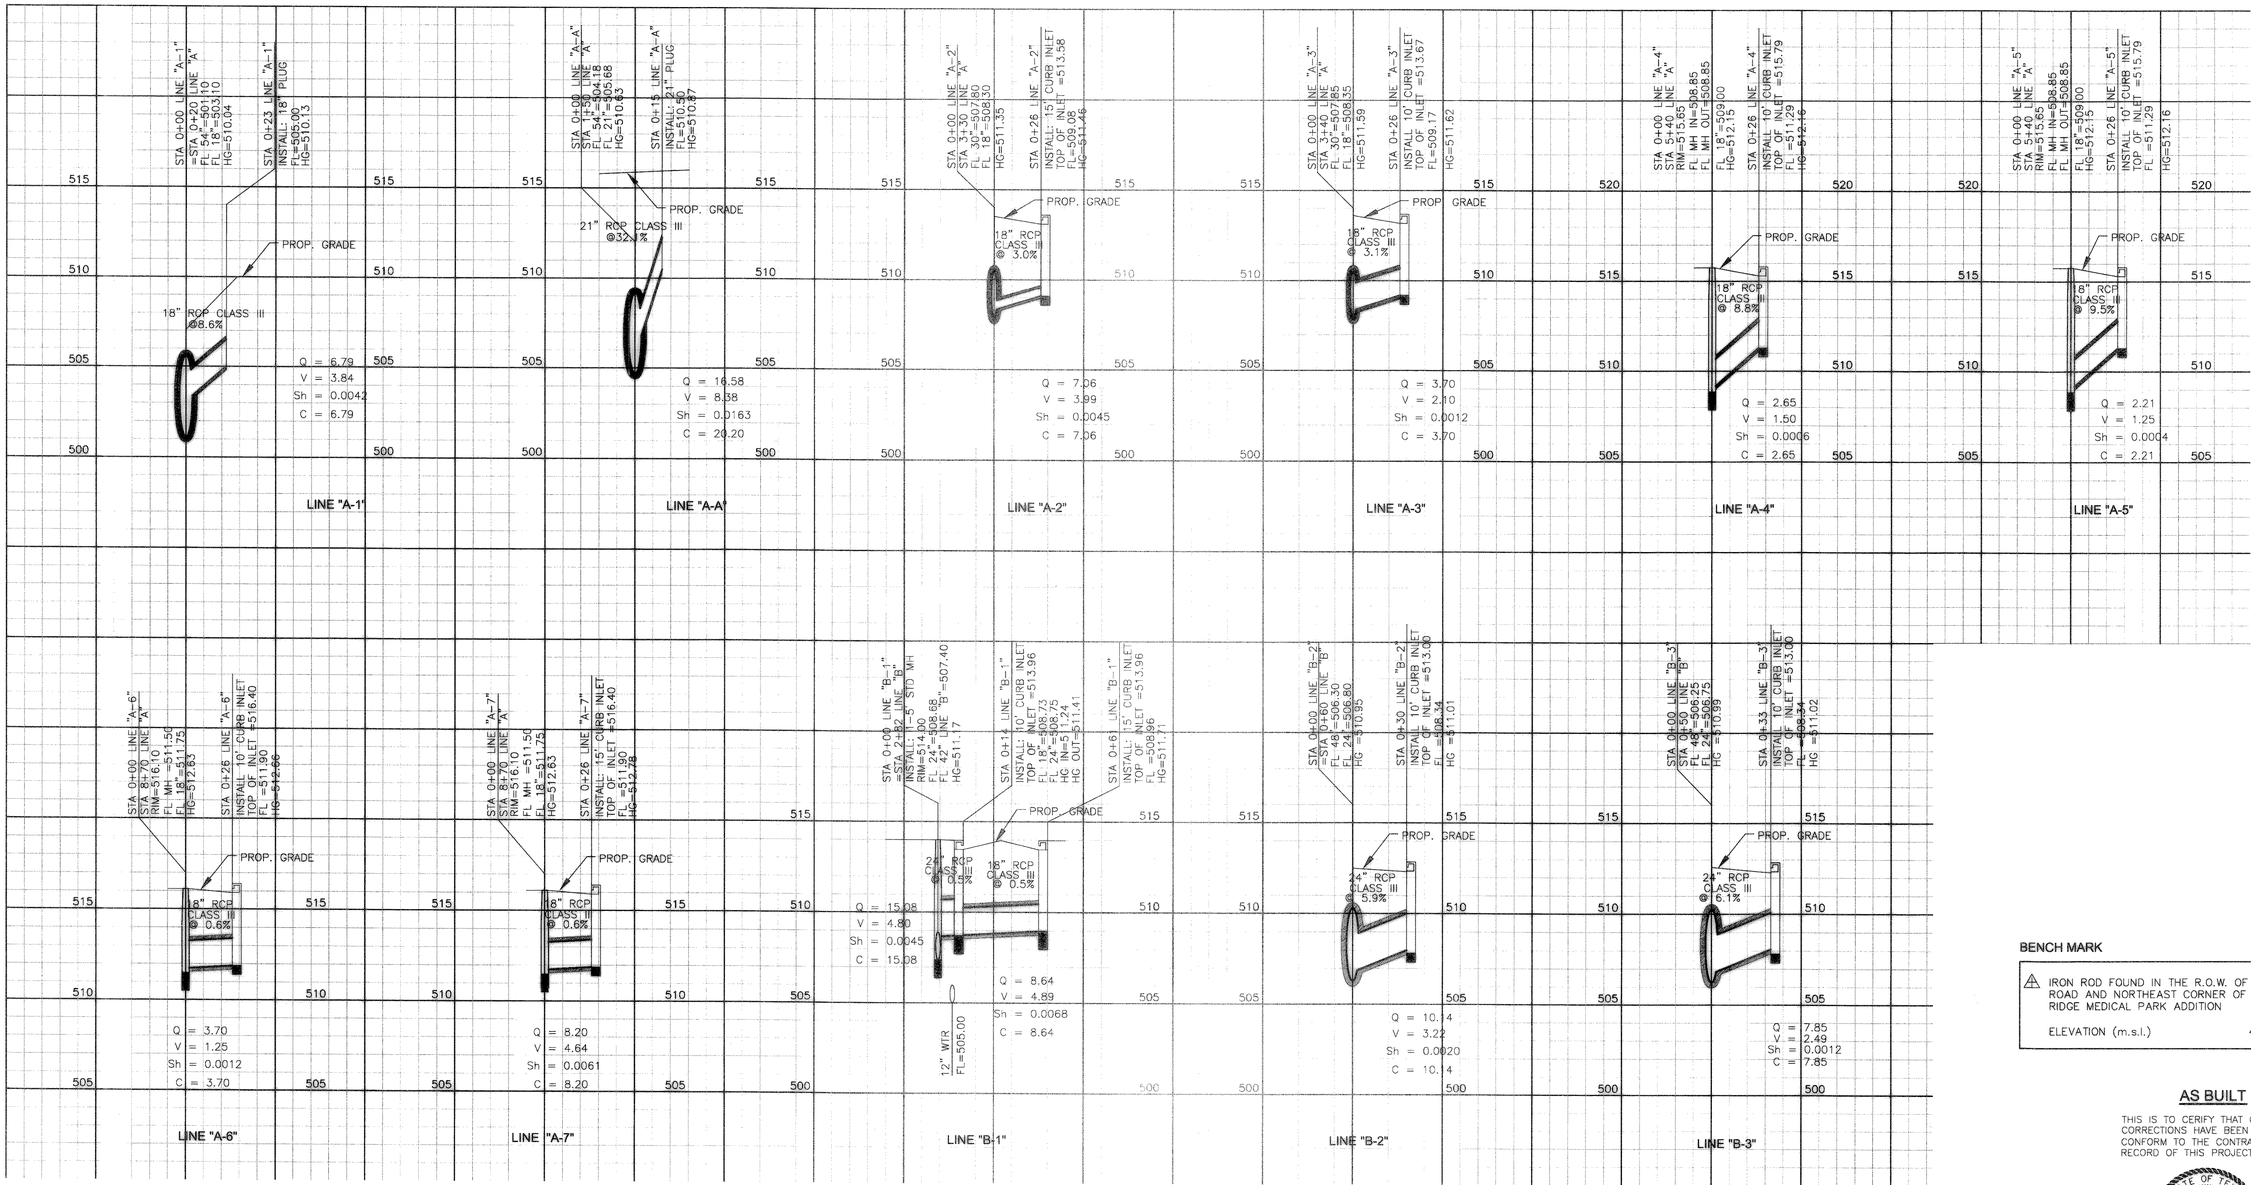

BENCH MARK

⚠ IRON ROD FOUND IN THE R.O.W. OF HORIZON ROAD AND NORTHEAST CORNER OF HORIZON RIDGE MEDICAL PARK ADDITION

ELEVATION (m.s.l.) 499.06

AS BUILT

THIS IS TO CERIFY THAT CHANGES AND CORRECTIONS HAVE BEEN MADE TO CONFORM TO THE CONTRACTOR'S RECORD OF THIS PROJECT.

STATE OF TEXAS
NARONGRIT BUTRIENG
97247
LICENSED PROFESSIONAL ENGINEER
06.23.08

LATERAL OF LINE "A" AND "B"

HORIZON RIDGE MEDICAL PARK

CITY OF ROCKWALL, TEXAS

PSA ENGINEERING
17819 DAVENPORT ROAD, SUITE 215 DALLAS, TX 75252 (972) 248-9651

DESIGN	DRAWN	DATE	SCALE	CHECK	FILE	NO.
PSA	PSA	06/23/08	AS SHOWN	PSS	2616.HRM	C-10

AS BUILT

Y:\2006\2616.HRM\AS-BUILT\SET 1\C-10.dwg