


LOCATION MAP
NO SCALE
MAPS00 300-K

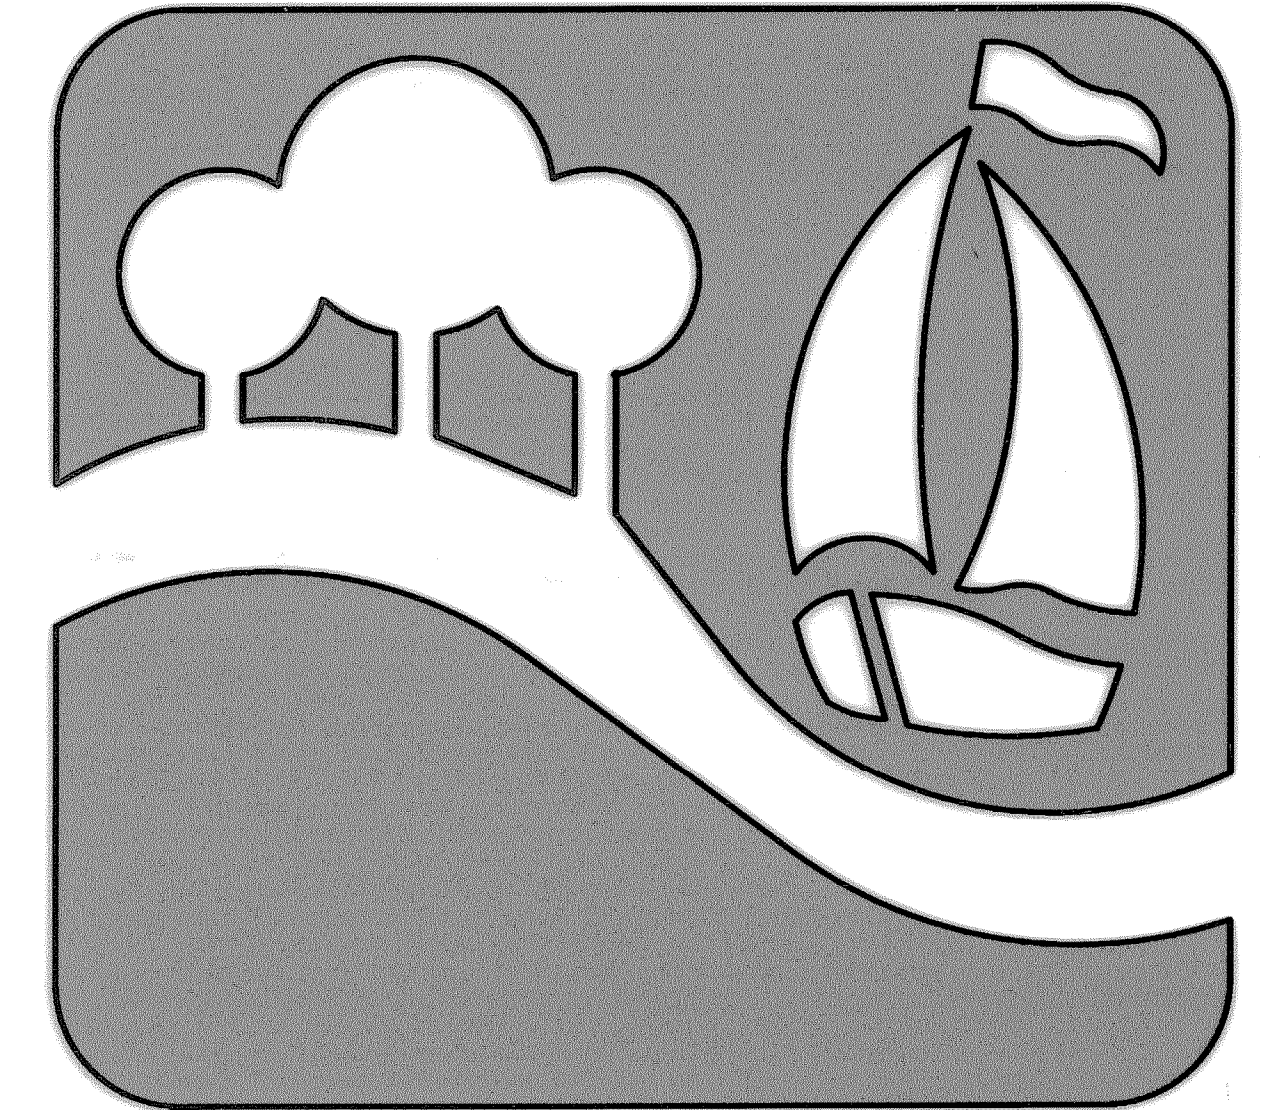

"THE NEW HORIZON"

SITE CONSTRUCTION PLANS

FOR

HORIZON RIDGE TWO

HORIZON RIDGE ADDITION

LOT 15, BLOCK A

IN THE


CITY OF ROCKWALL, TEXAS

SHEET INDEX

Sheet No.	Description
1	Cover Sheet
2	Replat
3	Replat
C1	Site Plan
C2	Grading Plan
C3	Drainage Area Map
C4	Water/Sewer/Storm Plan
C5	Schematic Detention Details
C6	Erosion Control
C7	Private Onsite Details

Bentley
ENGINEERING, INC.

4125 BROADWAY BLVD.
SUITE A250
GARLAND, TEXAS 75043
PH. 972.240.4821
FA X. 972.240.0922

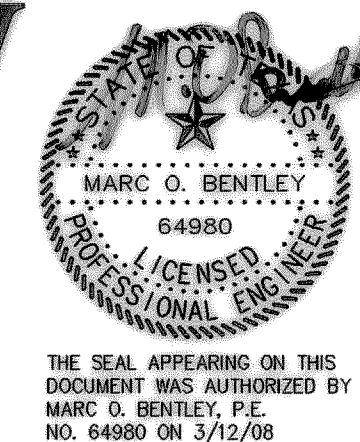

THE SEAL APPEARING ON THIS DOCUMENT WAS AUTHORIZED BY MARC O. BENTLEY, P.E. NO. 64980 ON 3/12/08

OWNER:
ROCKWALL CAPITAL ADVISORS
1010 W. RALPH HALL PARKWAY
ROCKWALL, TX 75032
469-698-4200
CONTACT: ANDREW QUALLS

APRIL 2008

RECORD DRAWING

IMPROVEMENTS INDICATED ON THESE PLANS ARE BASED ON VISUAL OBSERVATION AND SURVEY WORK PERFORMED AT THE SITE BY BEI OR SURVEY SUBCONTRACTOR.
DATE: DECEMBER 19, 2008

REVISED: 4/10/08 ISSUED FOR CONSTRUCTION
REVISED: 4/02/08
REVISED: 3/12/08

RECORD DRAWING

HORIZON RIDGE ADDN. 27160