PAVEMENT

PARKING = 5" REINFORCED WITH #3'S @ 18" O.C.E.W
(3000 PSI WITH 5.5 SACK/ CYD MIN.)

FIRE LANE = 6" REINFORCED WITH #3'S @ 18" O.C.E.W
(3600 PSI WITH 6.5 SACK/ CYD MIN.)

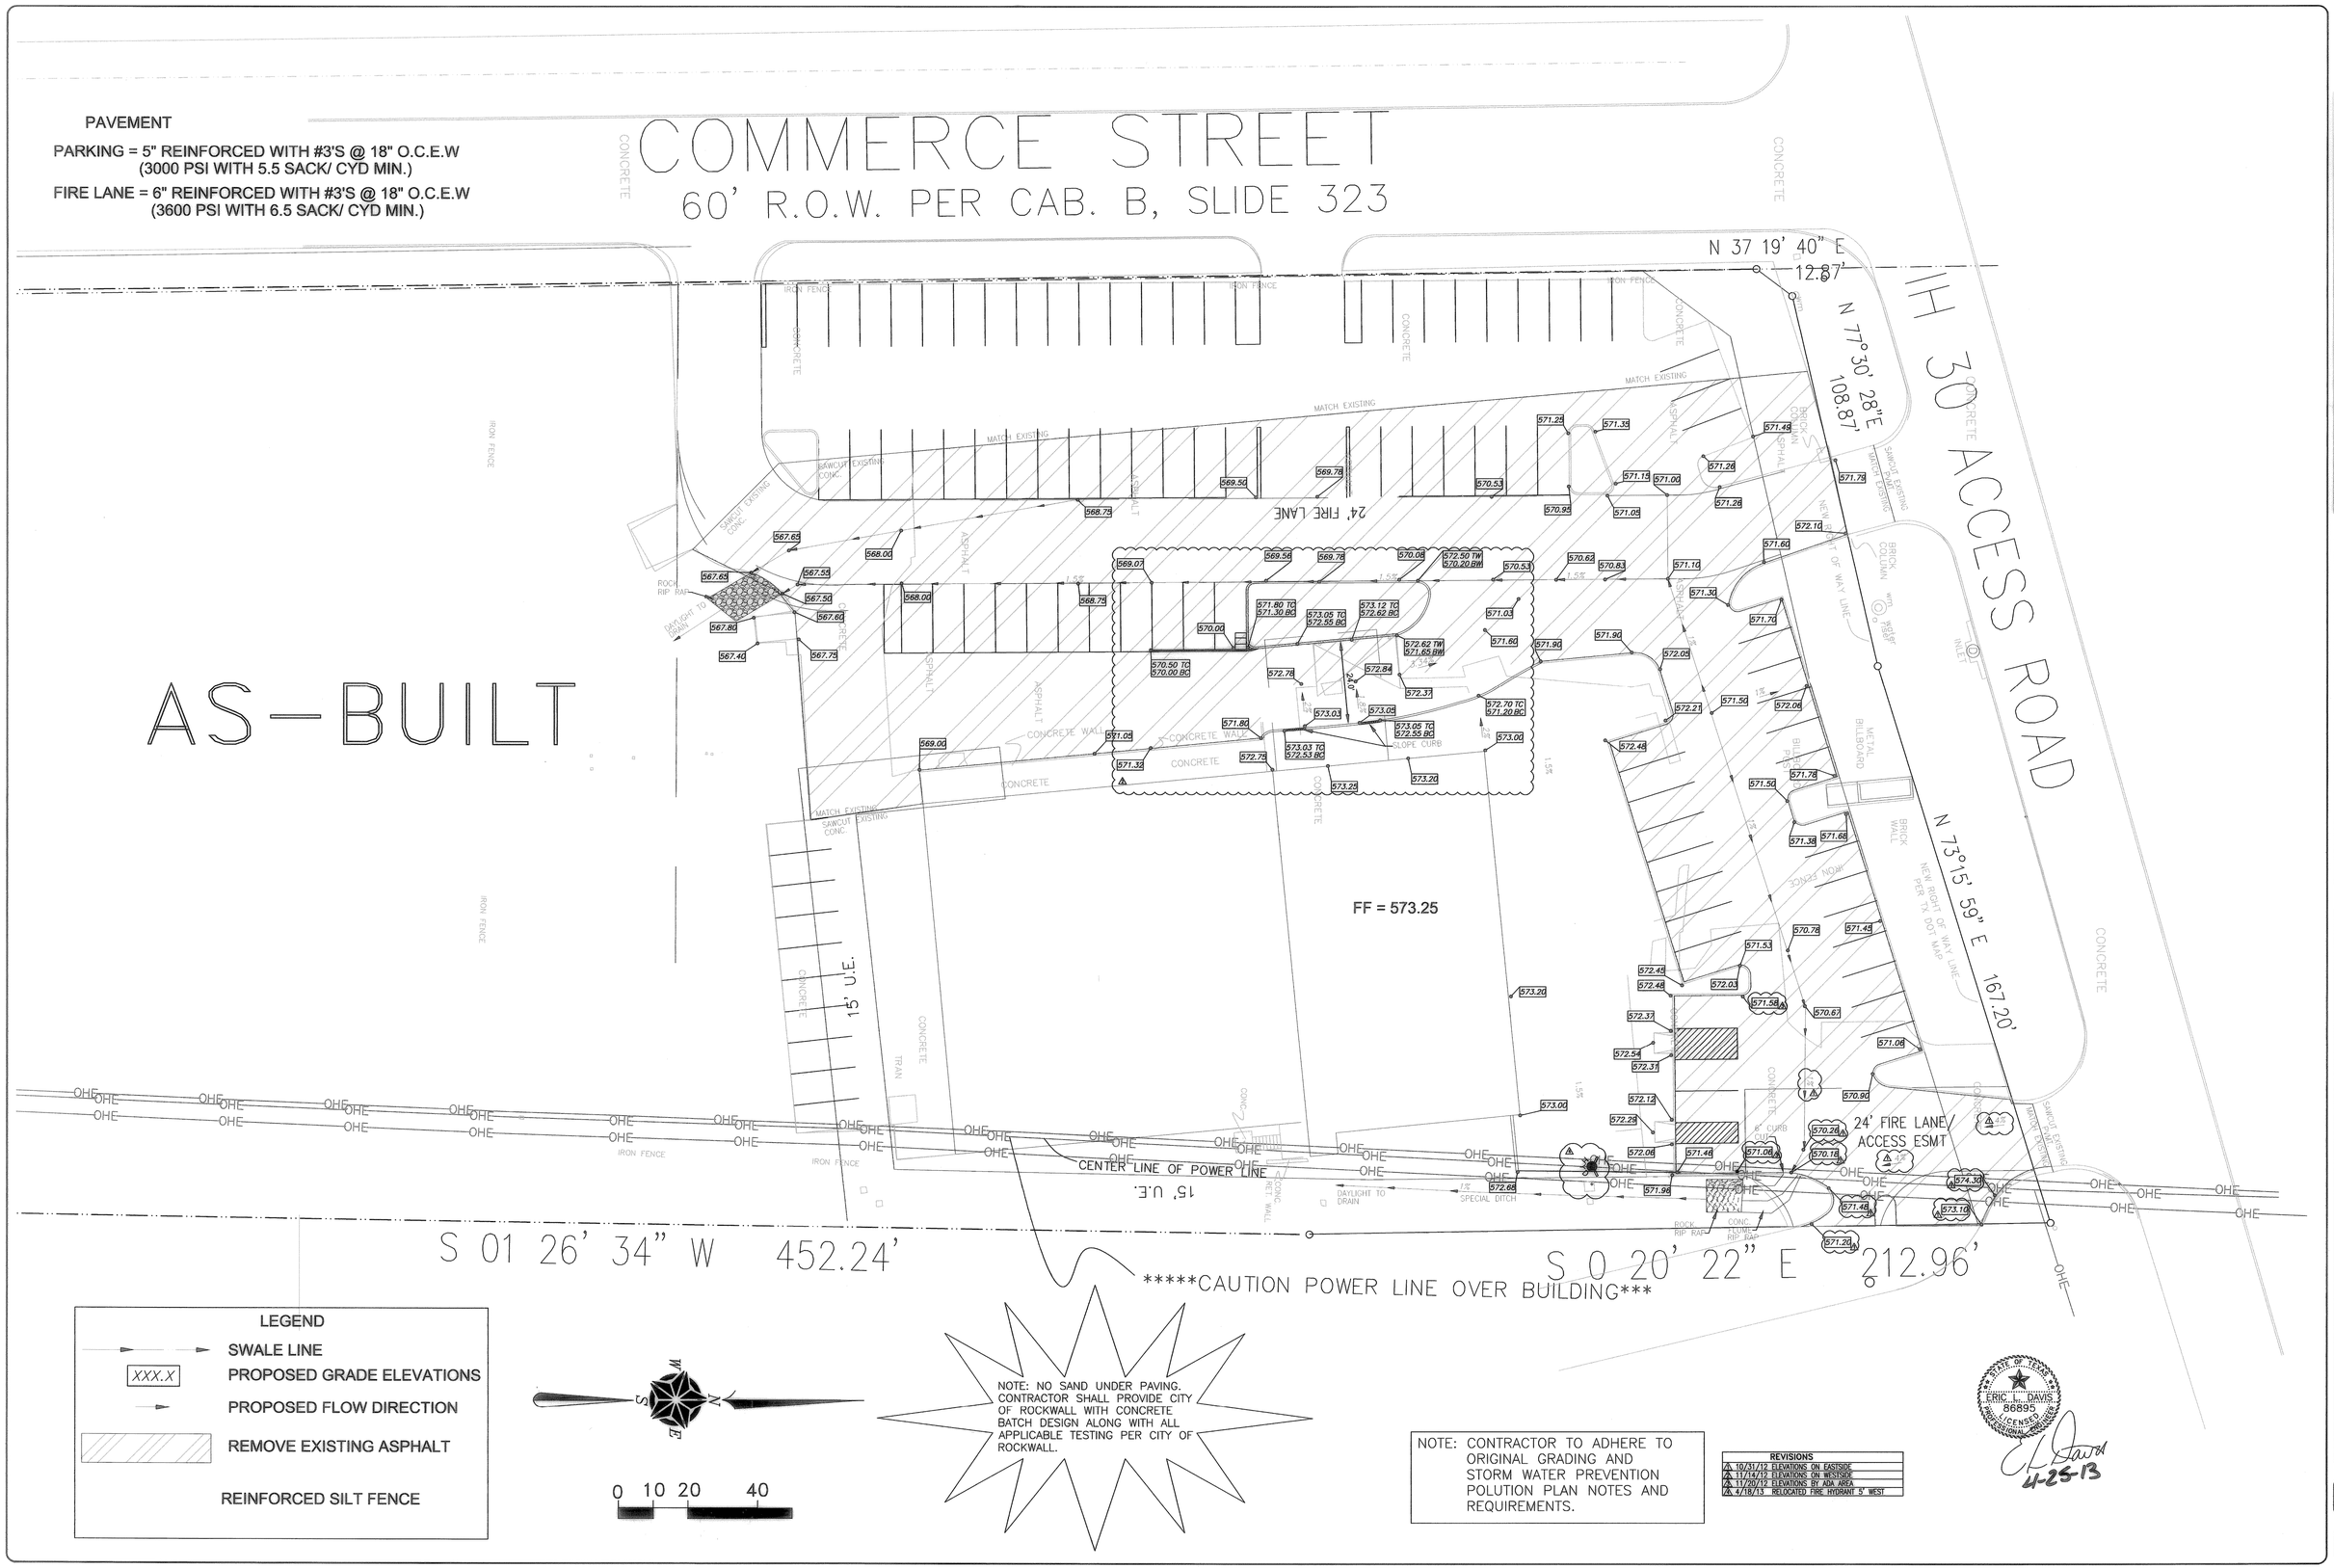

LEGEND

- SWALE LINE
- XXX.X — PROPOSED GRADE ELEVATIONS
- PROPOSED FLOW DIRECTION
- REMOVE EXISTING ASPHALT
- REINFORCED SILT FENCE

0 10 20 40

NOTE: NO SAND UNDER PAVING. CONTRACTOR SHALL PROVIDE CITY OF ROCKWALL WITH CONCRETE BATCH DESIGN ALONG WITH ALL APPLICABLE TESTING PER CITY OF ROCKWALL.

NOTE: CONTRACTOR TO ADHERE TO ORIGINAL GRADING AND STORM WATER PREVENTION POLUTION PLAN NOTES AND REQUIREMENTS.

REVISIONS
1 10/31/12 ELEVATIONS ON EASTSIDE
2 11/14/12 ELEVATIONS ON WESTSIDE
3 11/20/12 ELEVATIONS BY ADA AREA
4 4/18/13 RELOCATED FIRE HYDRANT 5' WEST

STATE OF TEXAS
ERIC L. DAVIS
86895
LICENSED
PROFESSIONAL ENGINEER
4-25-13

9/25/2012

ERIC L. DAVIS ENGINEERING, INC.
120 East Main Street
Forney, Texas 75126
972/564-0592 Fax 972/564-6523
E-Mail ericdavis@eldengineering.com

GRADING & PAVING PLAN
ENGINEERED FOR:
HYUNDAI DEALERSHIP

GC: MORGAN GROUP	PLAN: GRADING
ADDITION: ROCKWALL COUNTY	ELD JOB No.:
ADDRESS: 1540 INTERSTATE 30	DRAWN BY: BW
LOT: BLOCK:	FIRM REGISTRATION #: 3987
CITY: ROCKWALL, TEXAS	

SCALE: 1"=20'

SHEET: 1 OF 3