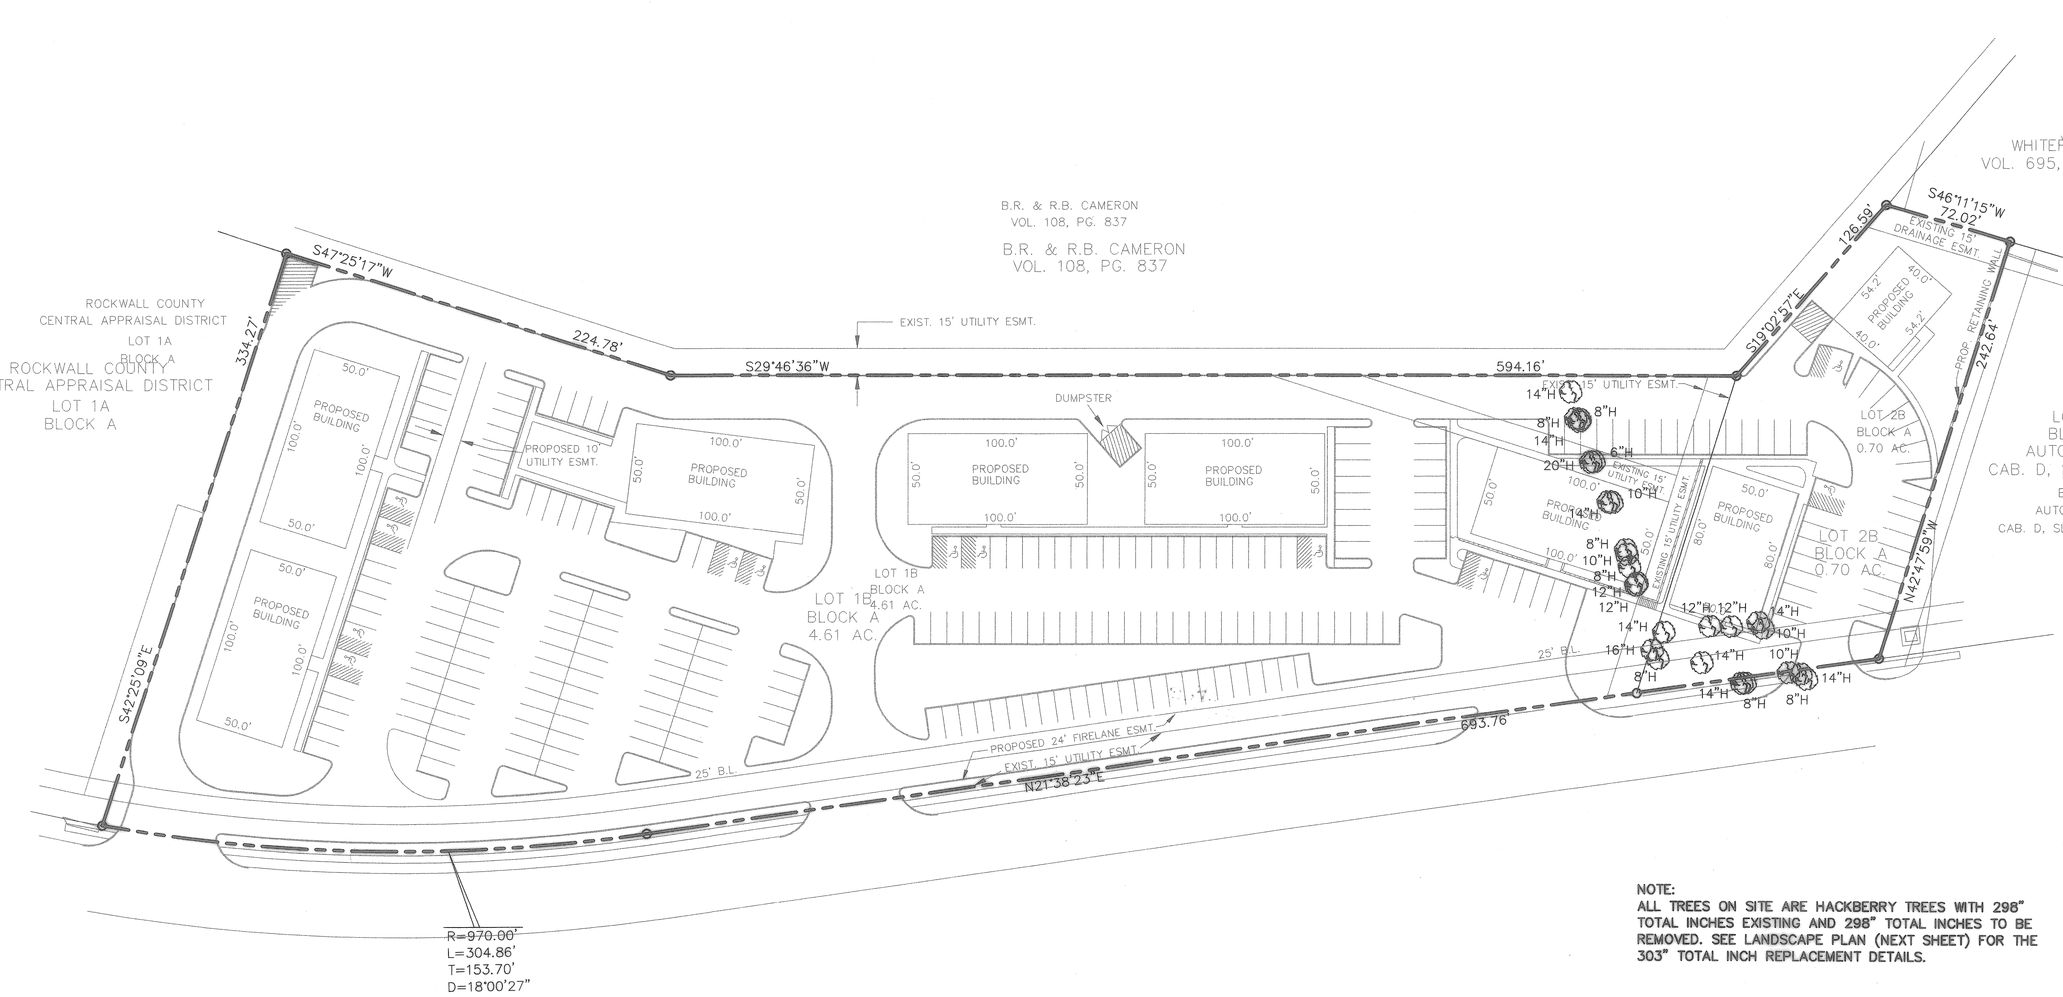

NOTE:
ALL TREES ON SITE ARE HACKBERRY TREES WITH 298" TOTAL INCHES EXISTING AND 298" TOTAL INCHES TO BE REMOVED. SEE LANDSCAPE PLAN (NEXT SHEET) FOR THE 303" TOTAL INCH REPLACEMENT DETAILS.

– EXISTING HACKBERRY

GRAPHIC SCALE

40 0 20 40 80 160

(IN FEET)
1 inch = 40 ft.

RECORD DRAWING

THIS DRAWING HAS BEEN REVISED TO REFLECT CONSTRUCTION RECORDS MAINTAINED AND PROVIDED BY THE CONTRACTOR FOR THIS PROJECT.

THE SEAL APPEARING ON THIS DOCUMENT WAS AUTHORIZED BY W.L. DOUPHRATE II TEXAS P.E. NO. 60102 ON 3/5/01

DOUPHRATE & ASSOCIATES, INC.
ENGINEERING • PROJECT MANAGEMENT • SURVEYING
2235 RIDGE RD., # 200 ROCKWALL, TEXAS 75087
PHONE: (972)771-9004 FAX: (972)771-9005

TREE PRESERVATION PLAN
JUSTIN DRIVE PROFESSIONAL PARK, LTD.
5.306 AC.
CITY OF ROCKWALL, ROCKWALL COUNTY, TEXAS

REVISION

W.L.D.
CHECKED

AC
DRAWN

3/5/01
DATE

0028TREES
PROJECT

13
OF
13