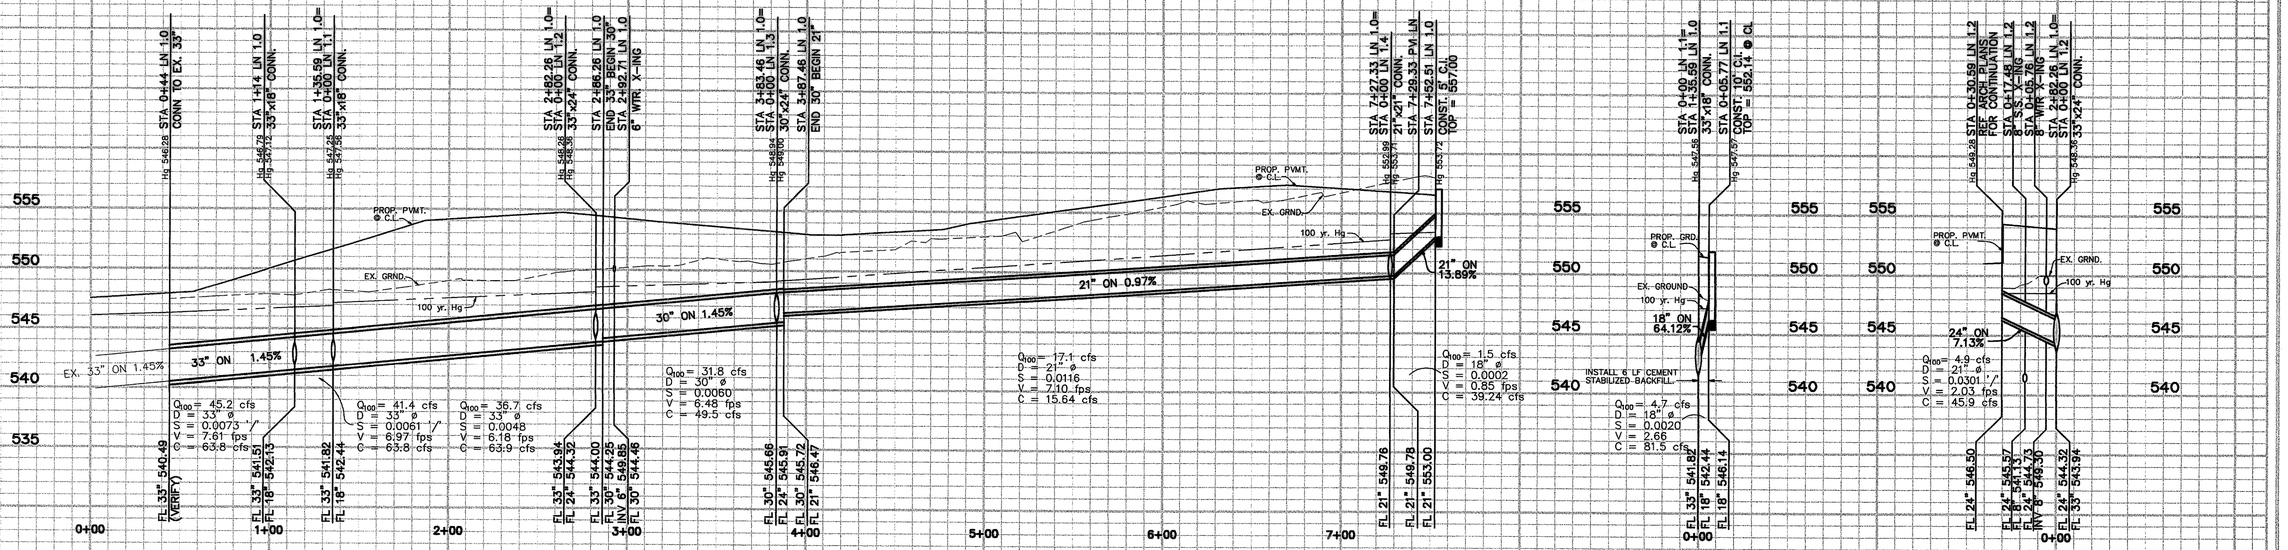

NOTE: ALL STORM SEWER TO BE CL III RCP UNLESS NOTED OTHERWISE.

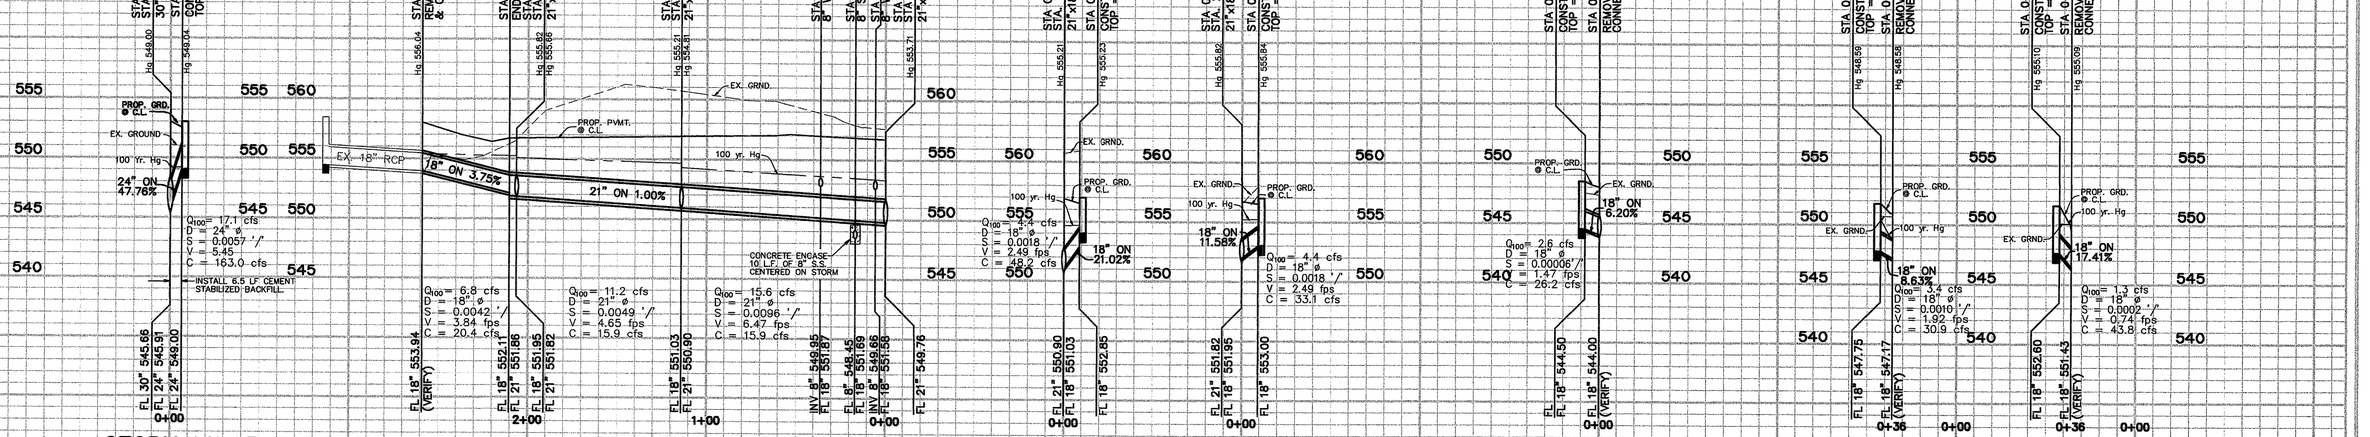

NOTE: ALL STORM SEWER TO BE CL III RCP UNLESS NOTED OTHERWISE.

REV.	DATE	REMARKS
2	5-02-05	ISSUED FOR CONSTRUCTION
1	3-22-05	ADDENDUM No. 2: ADJUSTED PROFILE GRADES

BENCH MARK:

BOX CUT IN NW CURB RETURN AT THE INTERSECTION OF WESTWOOD AND ROCKWALL PARKWAY.
ELEVATION = 537.56

AS BUILT
DATE 12/19/05

THE SEAL APPEARING ON THIS DOCUMENT WAS AUTHORIZED BY BRYAN M. BURGER, P.E. 90880 ON 6/29/05

CALL BEFORE YOU DIG 1-800-245-4545 TEXAS ONE CALL SYSTEM

STORM SEWER PROFILES

HORIZON RIDGE ADDITION

LOTS 6, 17, 18, & 19, BLOCK A

THE CITY OF ROCKWALL, TEXAS

LAWRENCE A. CATES & ASSOC., LLP
14800 QUORUM DRIVE, SUITE 200 (972) 385-2272
CONSULTING ENGINEERS
DALLAS, TEXAS

DESIGN	DRAWN	DATE	SCALE	NOTES	FILE	NO.
LAC	MCL	6/01	1"=40' 1"=6'	D.P.	24104 STORM1	C-14

R:\DWGS\24104\profile\storm-1.dwg, 4/28/2005 5:43:56 PM, kendall, HP 1050C.pc3