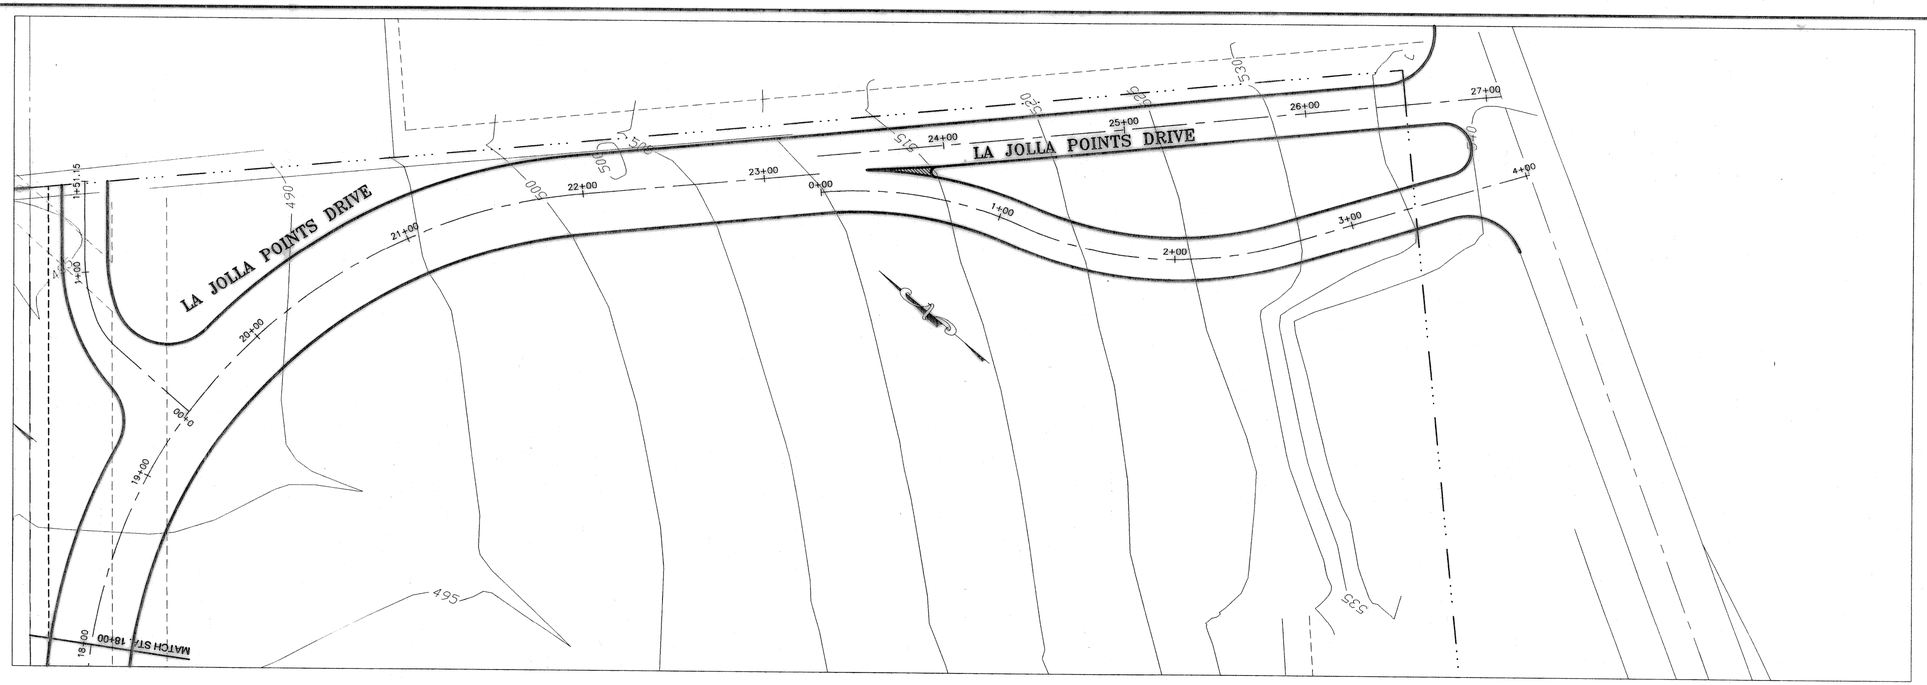

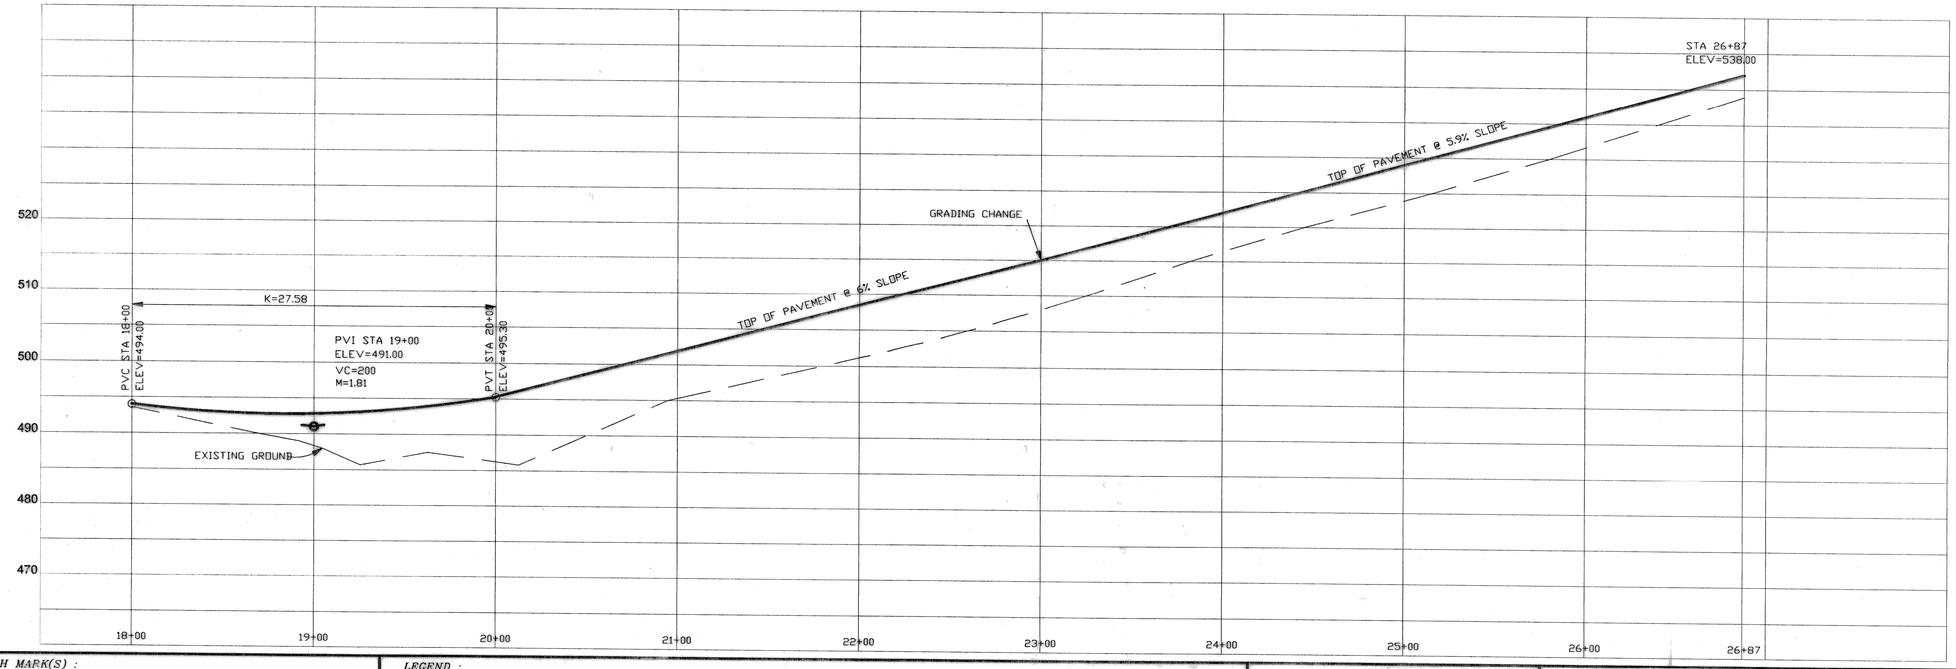

BENCH MARK(S) :

EXISTING SQUARE CUT ON TOP OF WEST CURB OF LAKESIDE DRIVE LOCATED APPROXIMATELY 120 FEET NORTH OF RAILROAD, AT THE NORTHWEST CORNER. ELEV=506.23

LEGEND :

REVISIONS

REV. NO.	DESCRIPTION	DATE	DRWN. BY

STATE OF TEXAS
PANSAK SRIBHEN
40320
REGISTERED
PROFESSIONAL ENGINEER

PSA ENGINEERING
17819 DAVENPORT RD, SUITE 215
DALLAS, TEXAS 75252
(972) 248-9651 FAX (972) 248-9681

CITY OF ROCKWALL, TEXAS
LA JOLLA POINTE ADDITION

PAVING & DRAINAGE IMPROVEMENTS
LA JOLLA PT. DR.

DESIGN	DRAWN	DATE	SCALE	PROJ. No.	SHEET No.
PSA	MIR	2-28-01	H:1"=40' V:1"=10'	2001 LJP	PH2P-2

C:\2000\2001.LJP\Current\Utility1.dwg Thu Mar 01 16:16:05 2001